



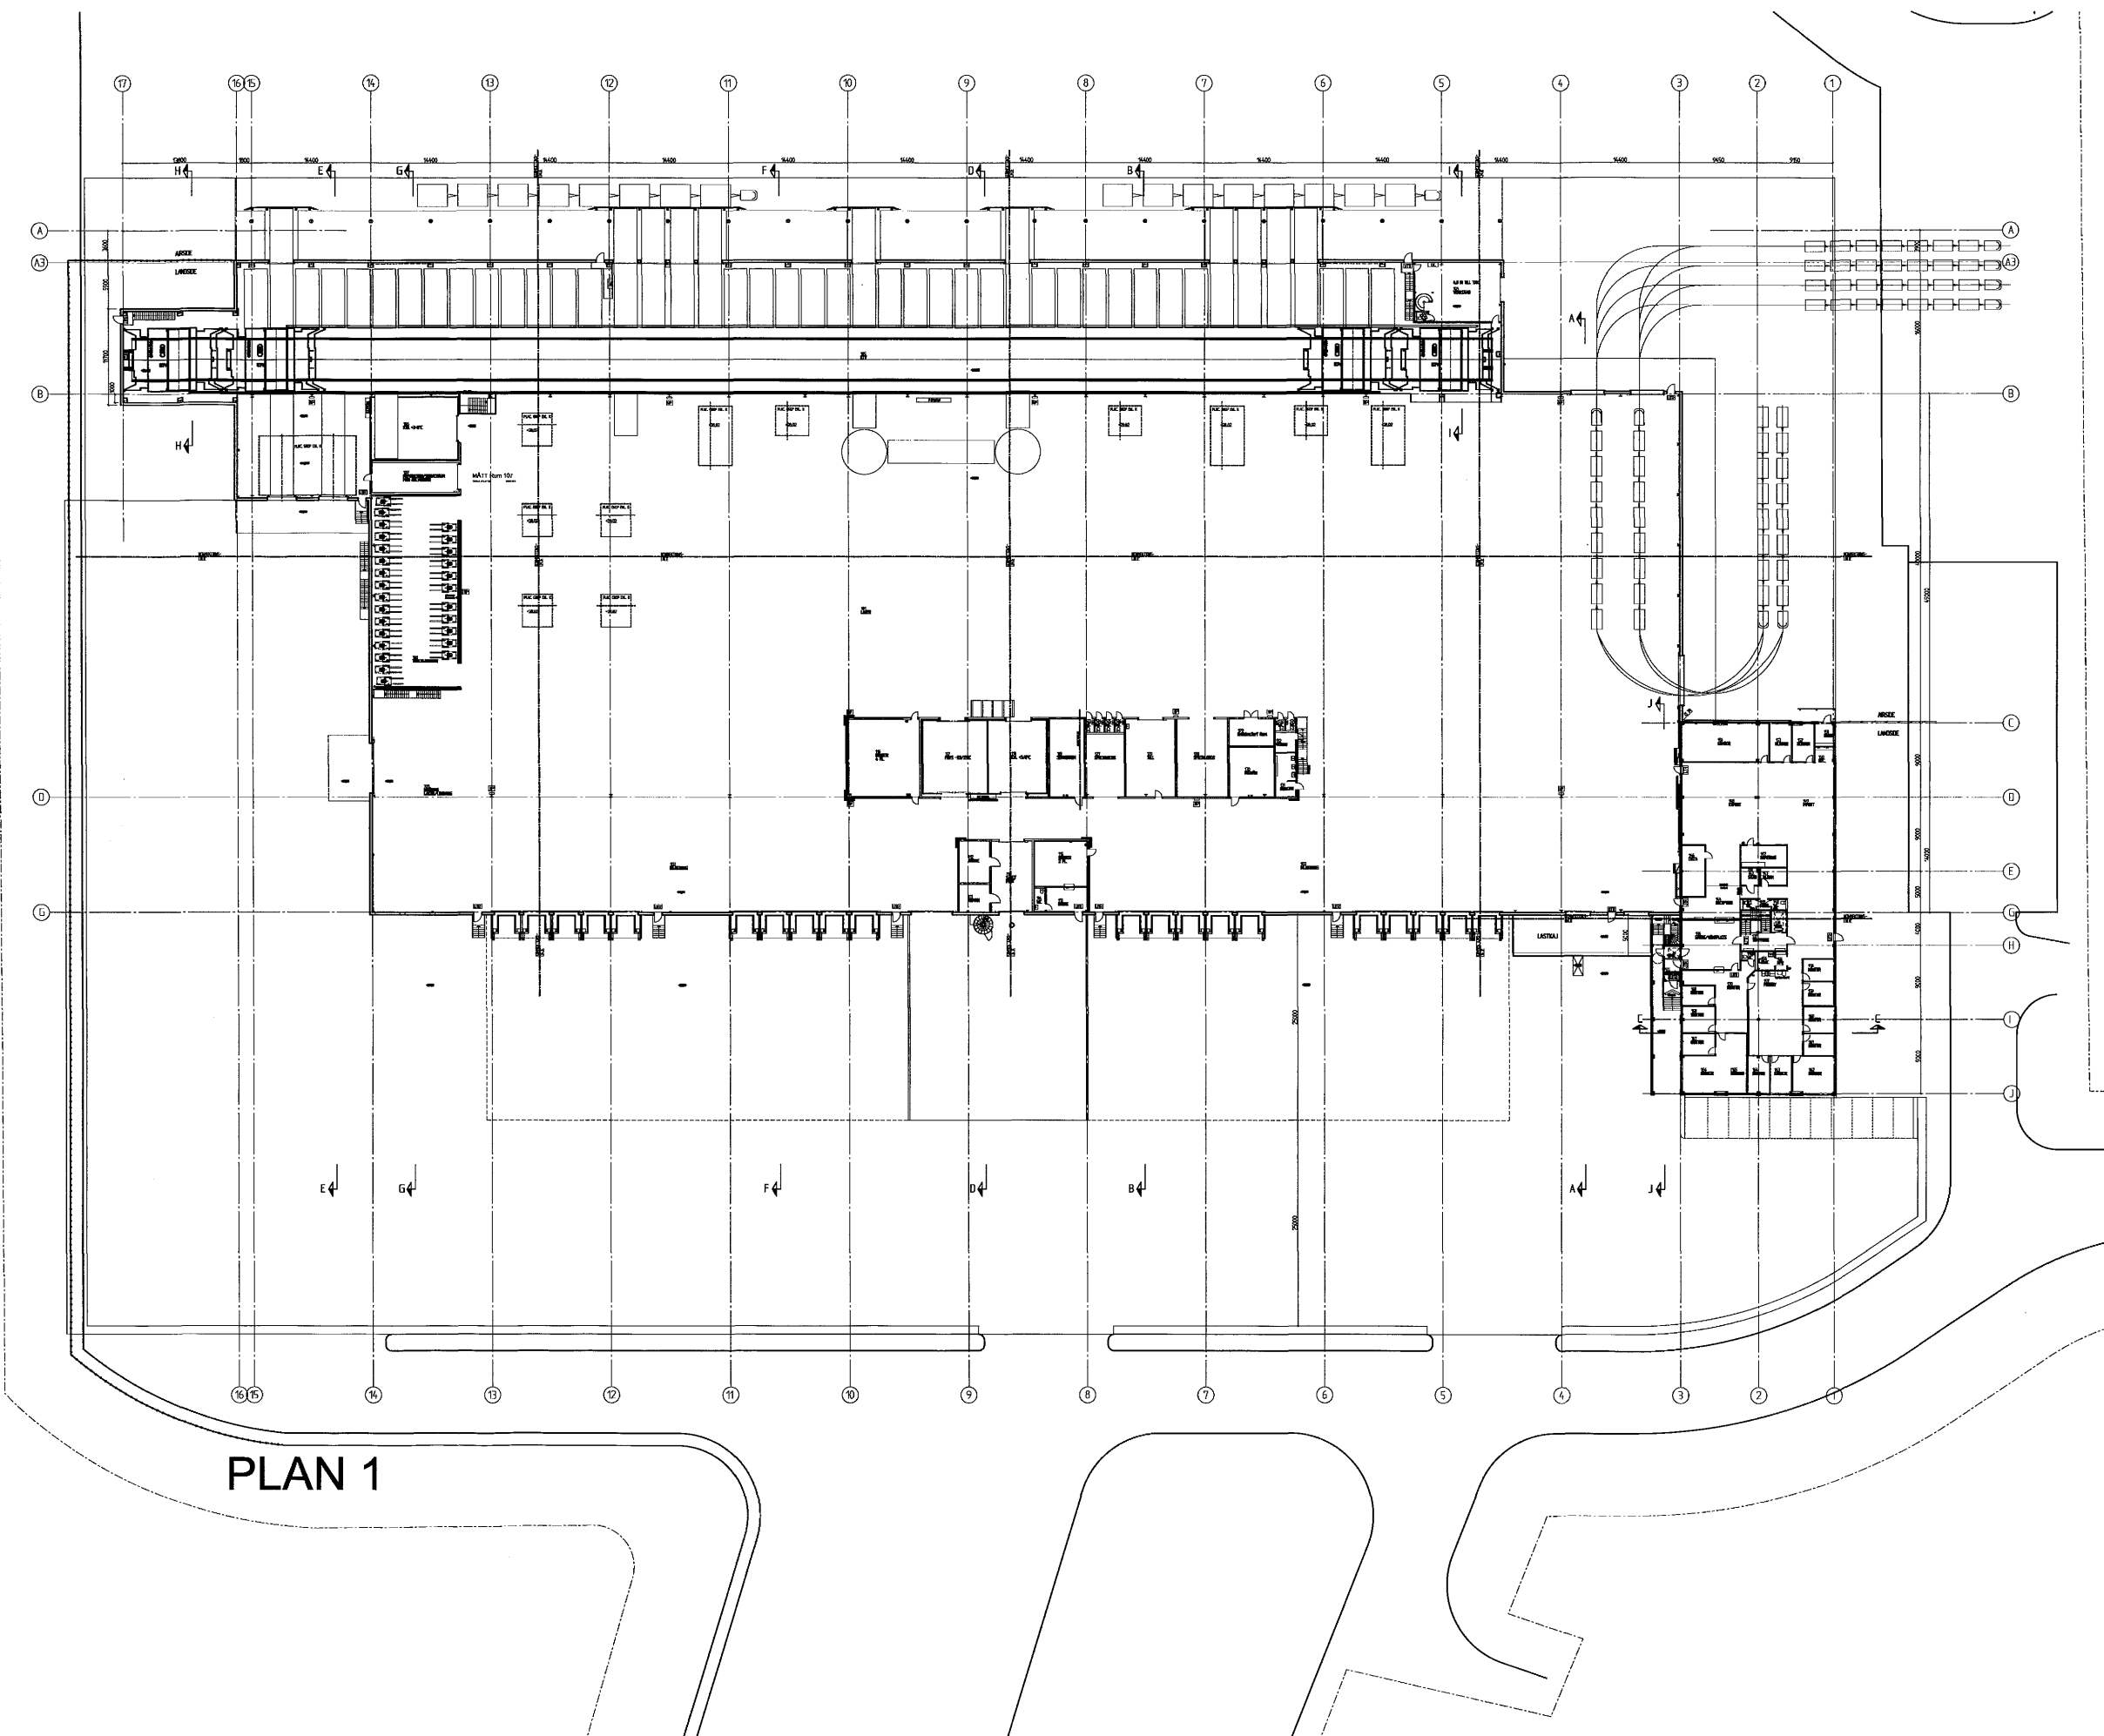

PLAN 1

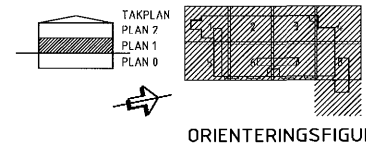

BET	ANT	ÄNDRINGEN	AVSER	DATUM	SIGN
RELATIONSHANDLING					
					
			 LUFTRÄTTSVERKET		
X	A	Conlekhon Arkitektier Fyrstad AB Kungsgatan 3, 462 33 VANERSBORG		Tel: 0521-26 26 80 Fax: 0521-26 26 99	
	K	Knut Jönsson Ingenjörbyrå AB Stationsgatan 6, 195 40 HÄRSTA		Tel: 08-594 407 88 Fax: 08-594 407 99	
	M	FB Engineering AB Hemvärsgränd 15, 171 54 SOLNA		Tel: 010-850 73 00	
	E	WSP Systems AB Box 536, 751 05 UPPSALA		Tel: 018-780 54 00 Fax: 018-780 54 49	
	Vvs	SWECO Systems AB Kungsgatan 62, 753 18 UPPSALA		Tel: 018-495 29 00 Fax: 018-15 43 12	
	-	-		-	
	-	-		-	
	-	-		-	
UPPDRAG NR 084320		RITAD/KONSTR AV AM		HANDLÄGGARE AM	
DATUM 2010-09-01		ANSVARIG Anders Patriksson			
FLYGFRAKTSTERMINAL SPIRIT STOCKHOLM ARLANDA AIRPORT ÖVERSIKTSRITNING PLAN 1					
SKALA A1- 1:400 A3- 1:800		NUMMER A-40.1-100		BET	