


XREF:
LAGER_SB11

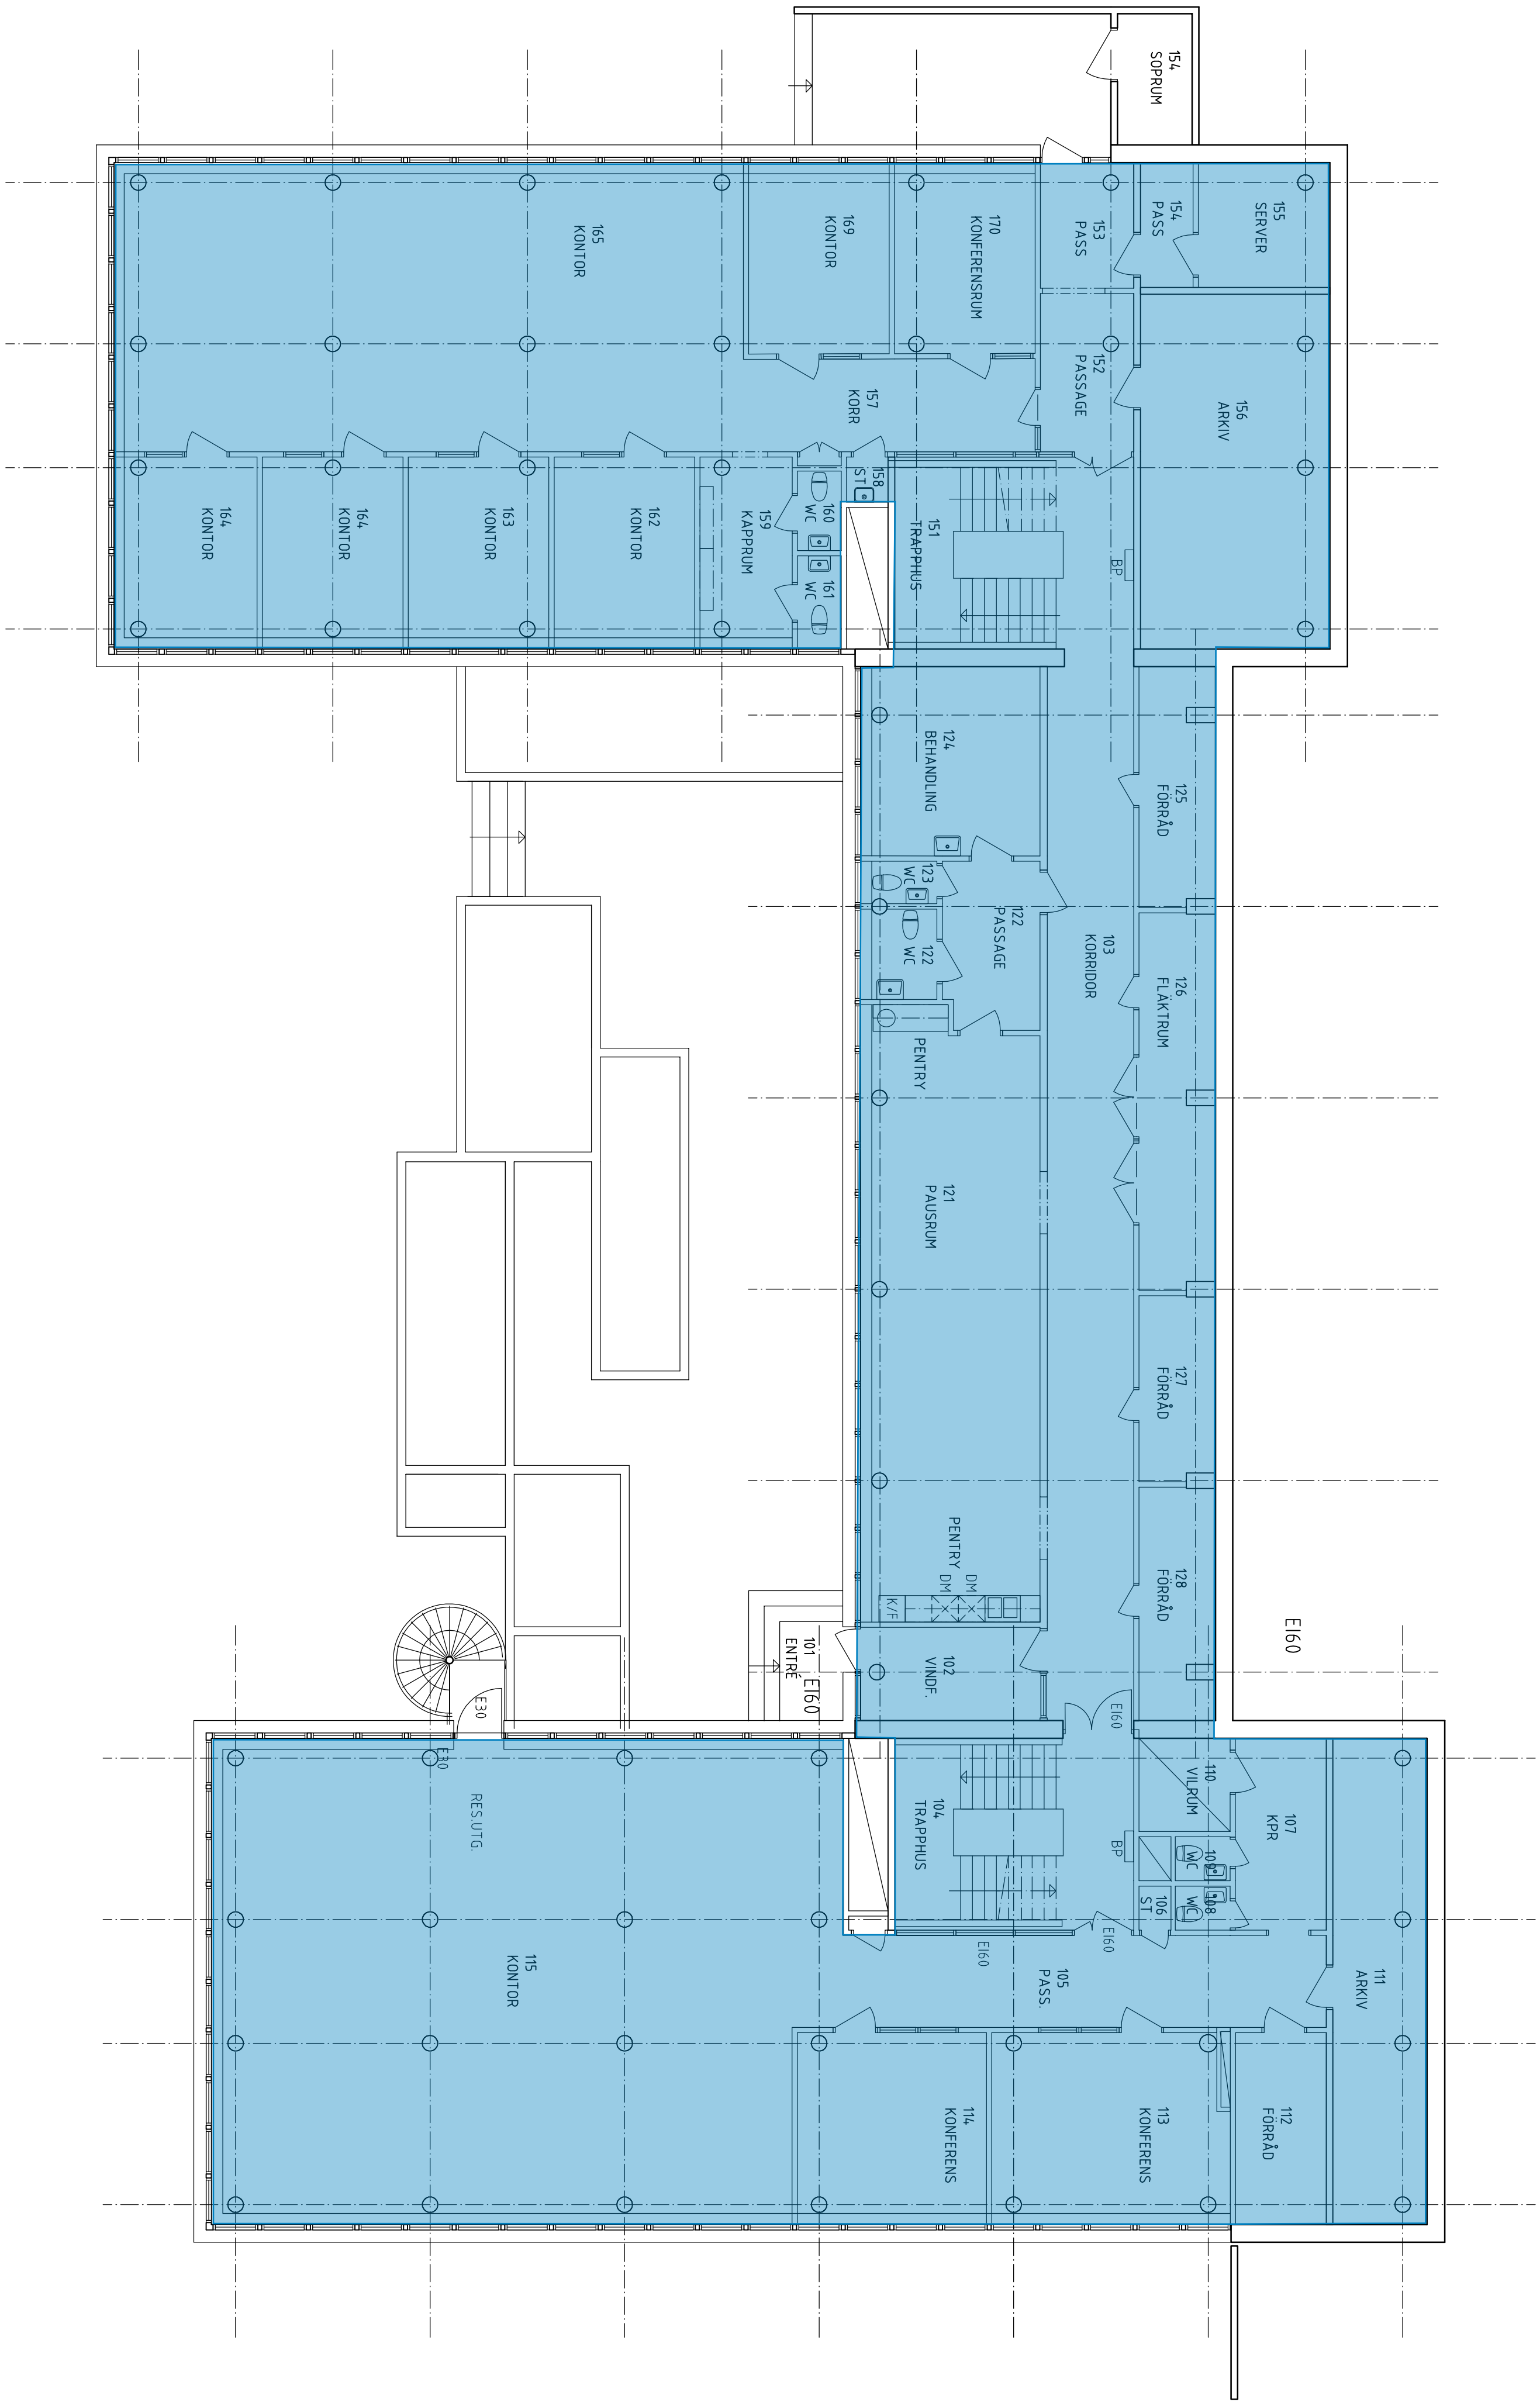

BET	ART	ANORDNING	ANSEER	SKALA	DATUM
RELATIONSHANDLING					
ERSMARK 78:2					
SOUTERRANGPLAN, PLAN 1					
SKALA 1:100 (A1)					
A-30:12R					
1 BET					
Fastighets AB POLARIS					
CONSUTEC SKELLEFTEA					
KONSTRUKTÖRER AB TEL: 0910-878 00					
DRÖMMAHETEN RITA / ANORDNA					
63689 LALO LARS LÖFSTEDT					
2015-06-11 One Mission					