



B
A-40-2-A100

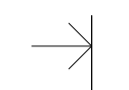




A
A-40-2-A100

A
A-40-2-A100

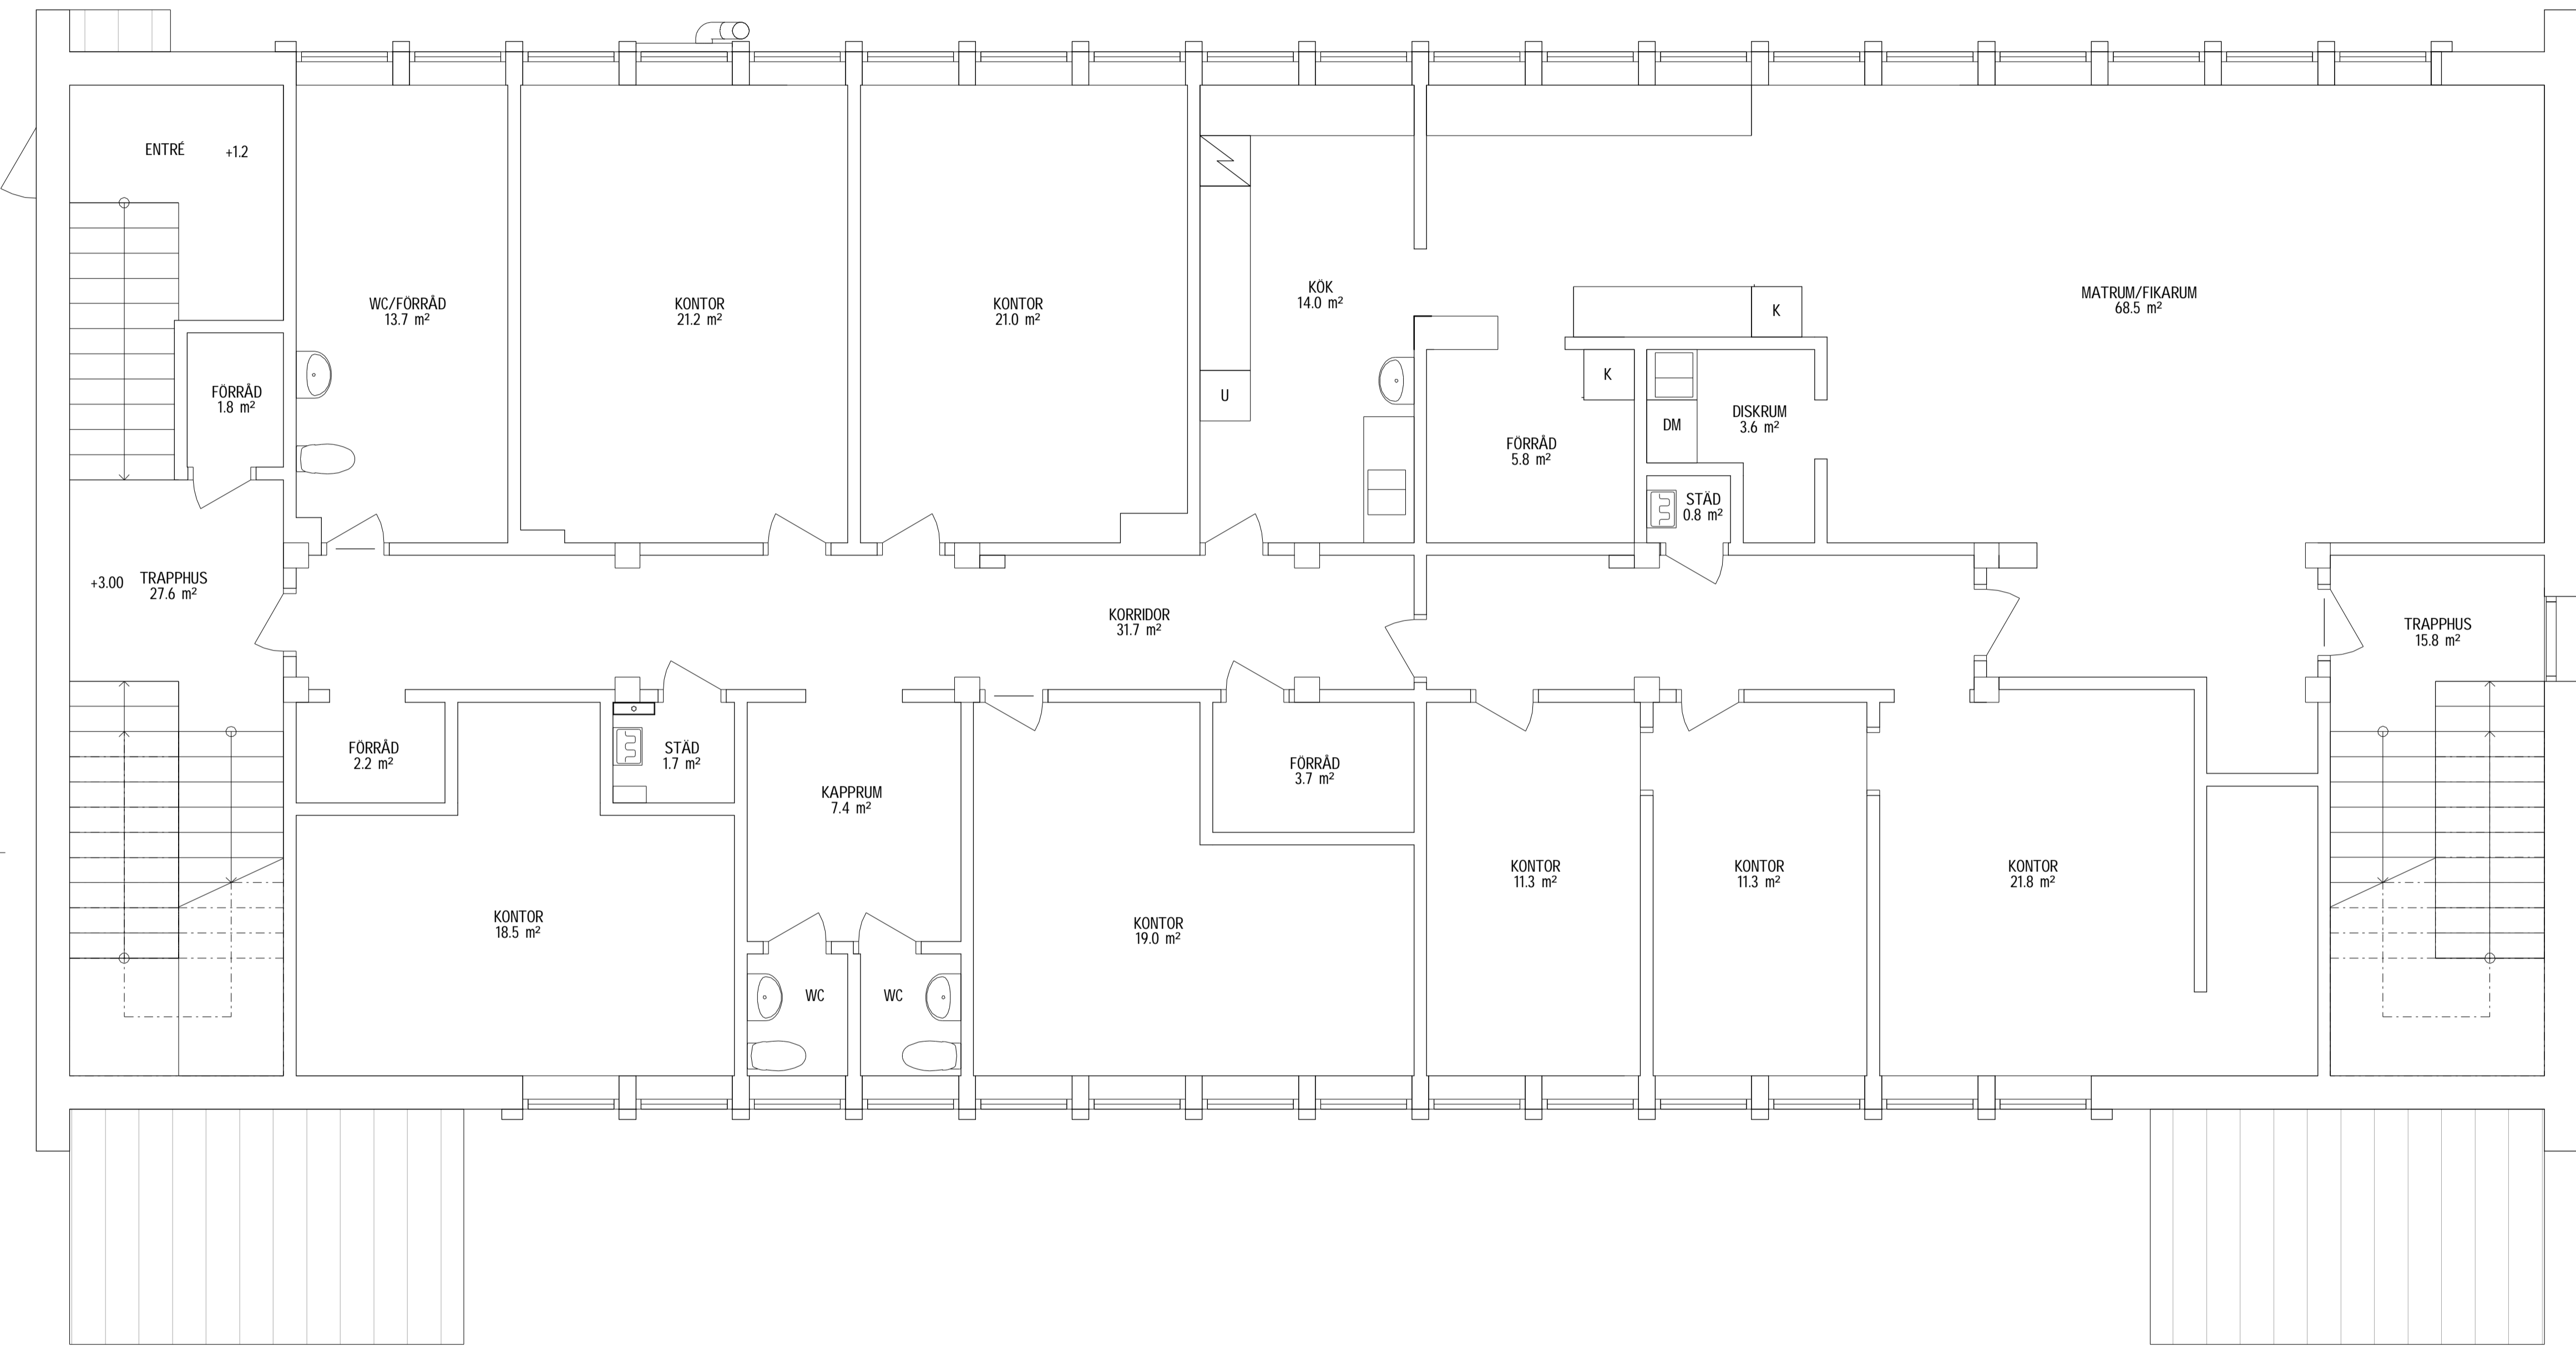


Plan 2
SKALA 1 : 50

B
A-40-2-A100

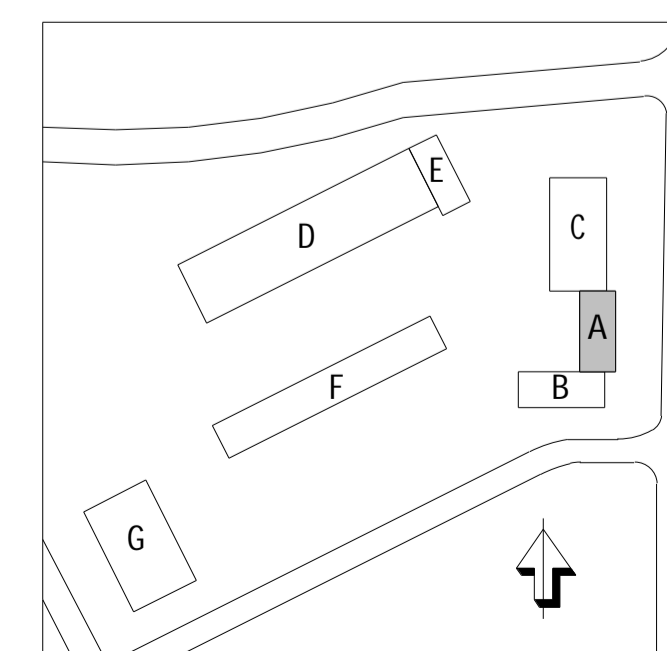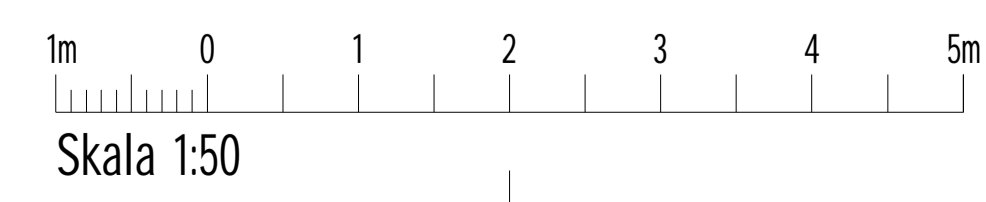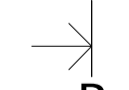

BET	ANDRINGEN AVSER	DATUM	SIGN
RELATIONSHANDLING			
MOTALA KOMMUN KV. NORRSKENET Hus A - Kontor			
UPPRAGNING 2206		RITAD/KONSTR AV JA	UPPRAGSLEDARE EA
DATUM 2022-05-13		ANSVÄRIG Emil Andersson	
Plan 2			
SKALA A1 1:50 A3 1:100	NUMMER A-40-1-A120	BET	

B
A-40-2-A100


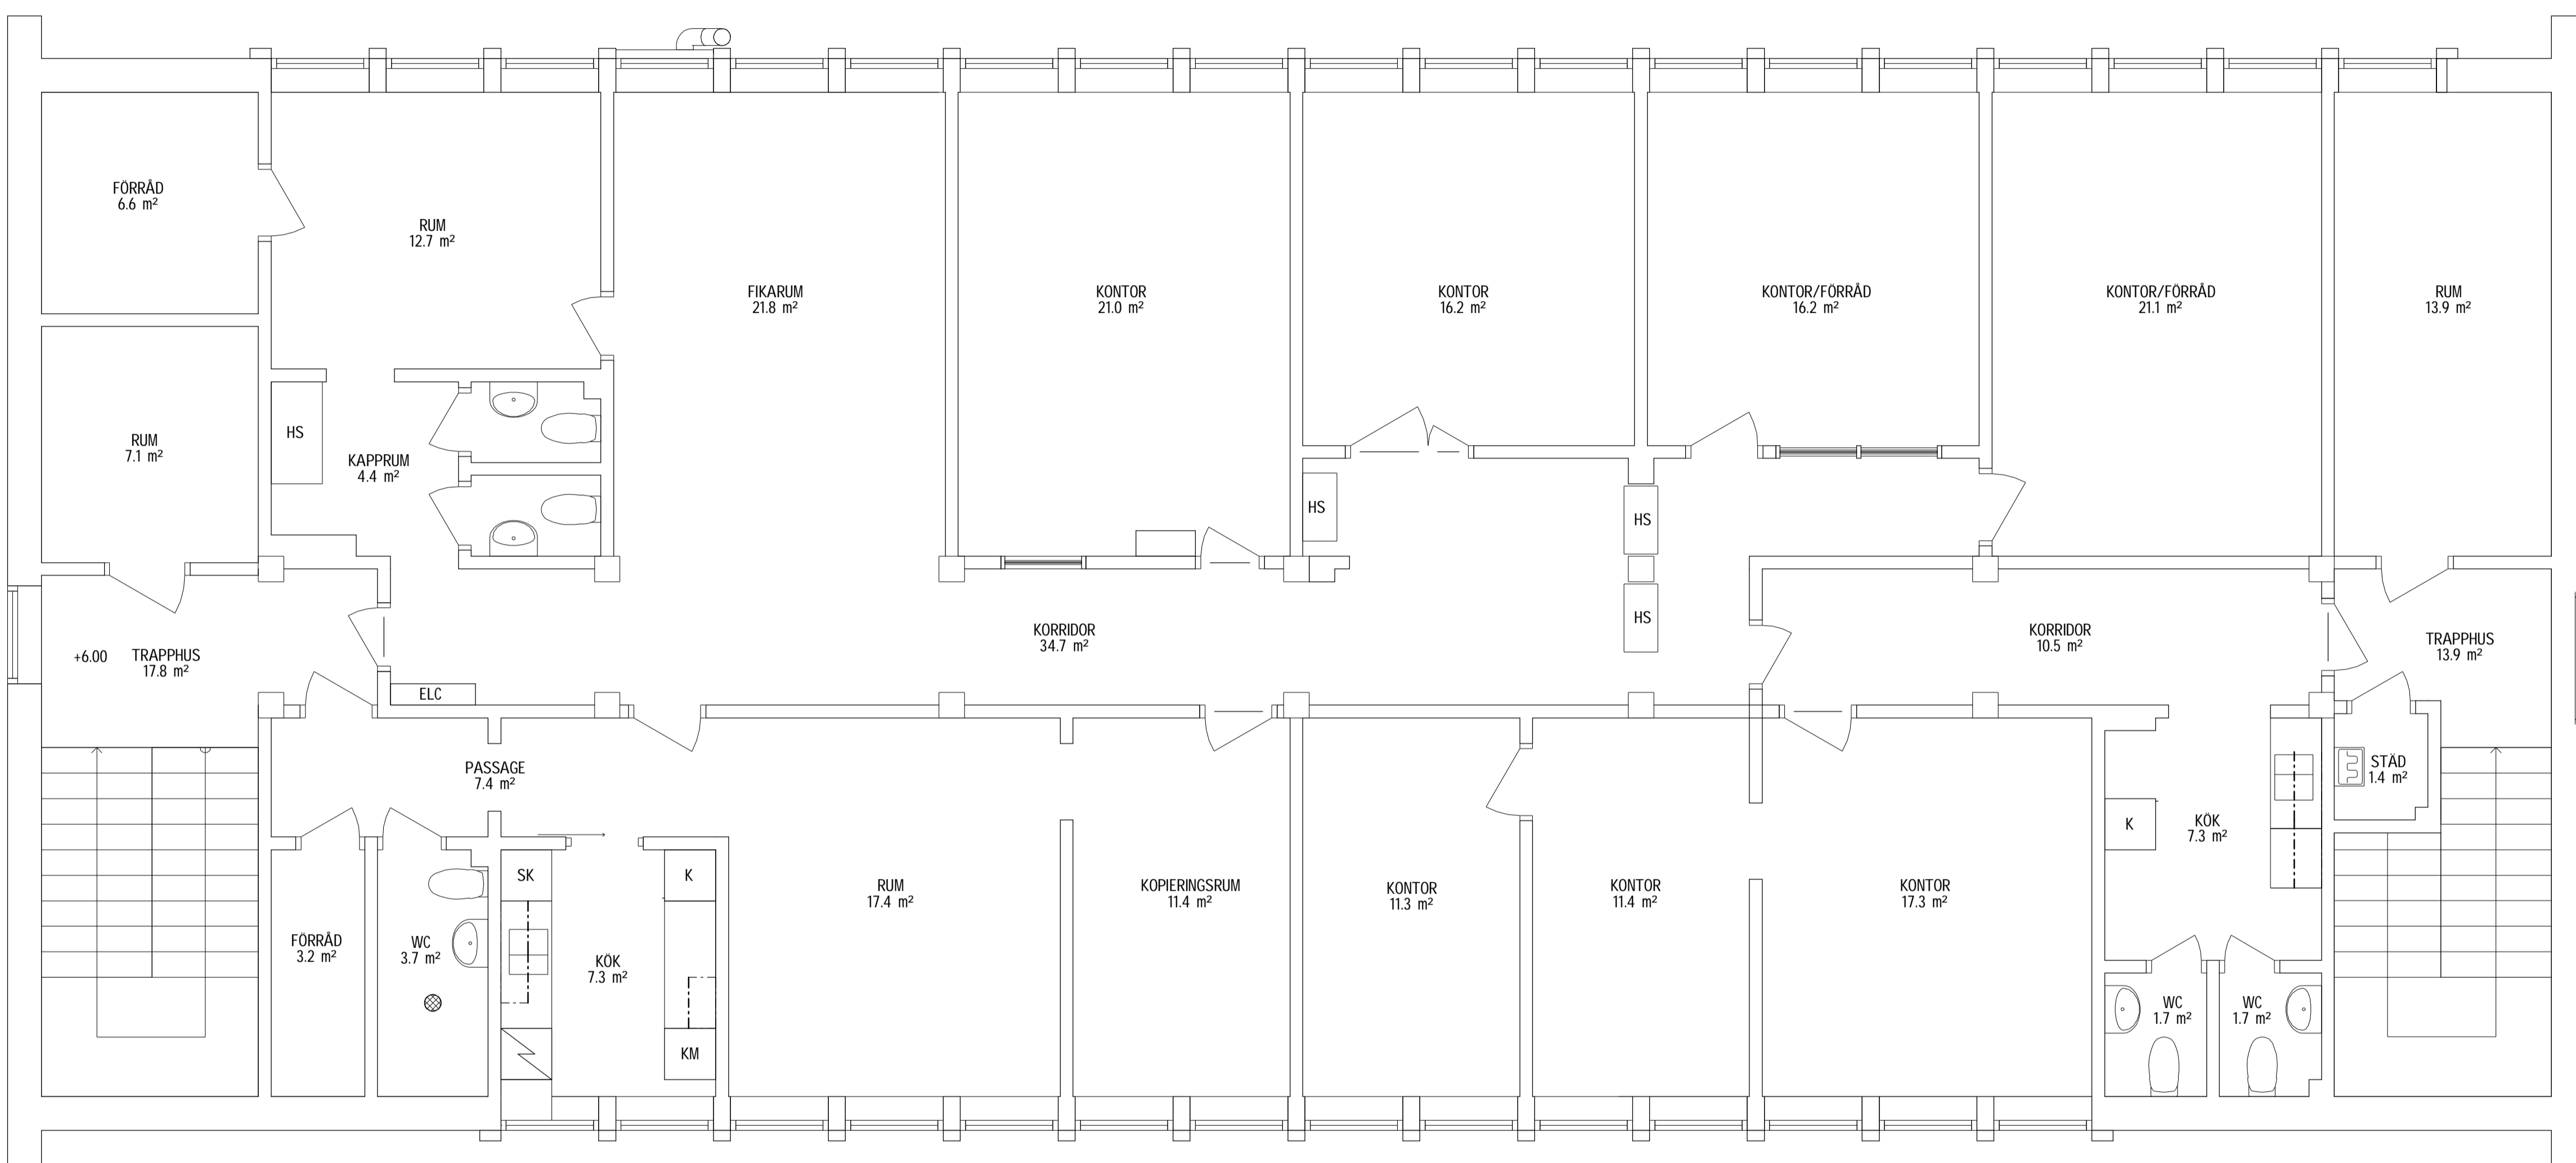


A
A-40-2-A100

A
A-40-2-A100

Plan 3
SKALA 1 : 50

B
A-40-2-A100

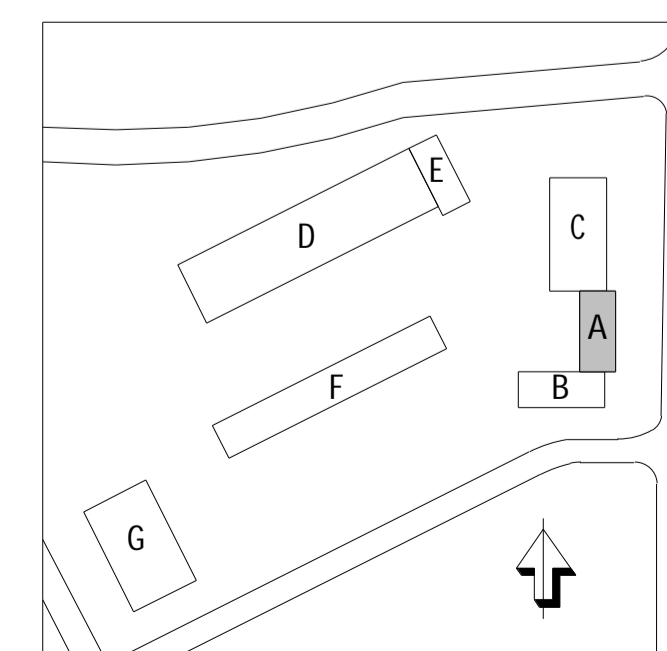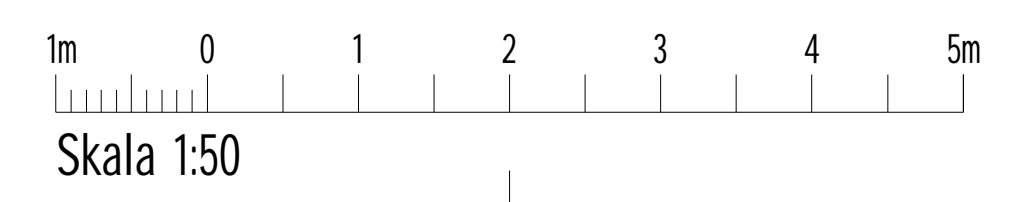

BET	ANDRINGEN AVSER	DATUM	SIGN
RELATIONSHANDLING			
MOTALA KOMMUN KV. NORRSKENET Hus A - Kontor			
UPPRAGNR 2206		RTAD/KONSTR AV JA	UPPRAGSLEDARE EA
DATUM 2022-05-13		ANSVÄRIG Emil Andersson	
Plan 3			
SKALA A1 1:50 A3 1:100	NUMMER A-40-1-A130	BET	

2022-05-13 14:31:14 G:\2206 Kv. Norrskenet\A-modellritningar\Hus A\2206-HUS-A.rvt