



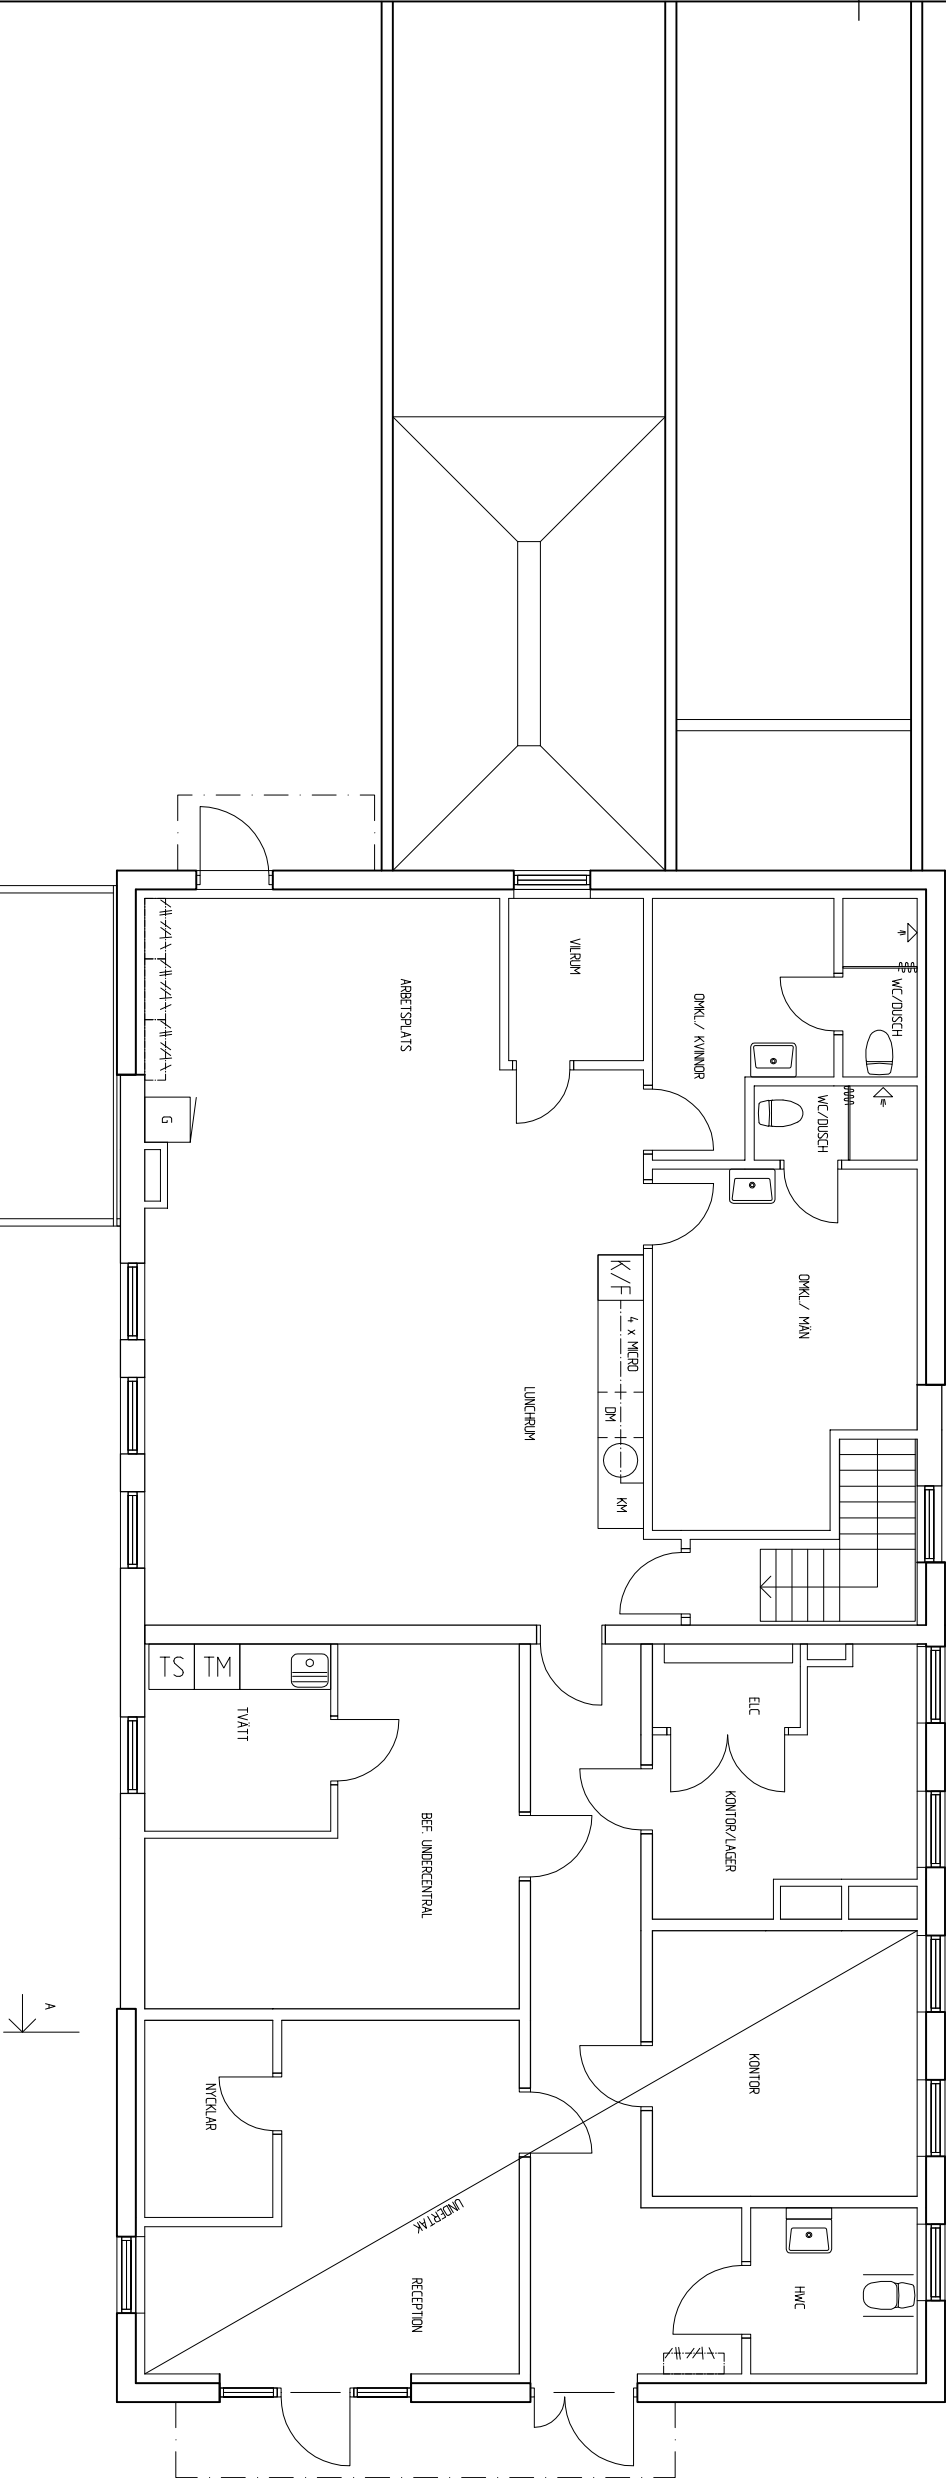

| REV.               | ANT. | REVISERING AVSEER | SEN | DATA |
|--------------------|------|-------------------|-----|------|
| RELATIONSHANDLING  |      |                   |     |      |
| PLANRITNING        |      |                   |     |      |
| BOMULLEN 4         |      |                   |     |      |
| OMRÅDESKONTOR EKON |      |                   |     |      |
| OMBYGGNAD          |      |                   |     |      |
| PLANRITNING        |      |                   |     |      |
| SKALA 1:50         |      |                   |     |      |
| A3 100             |      |                   |     |      |
| A-40.1-100         |      |                   |     |      |
| REV                |      |                   |     |      |

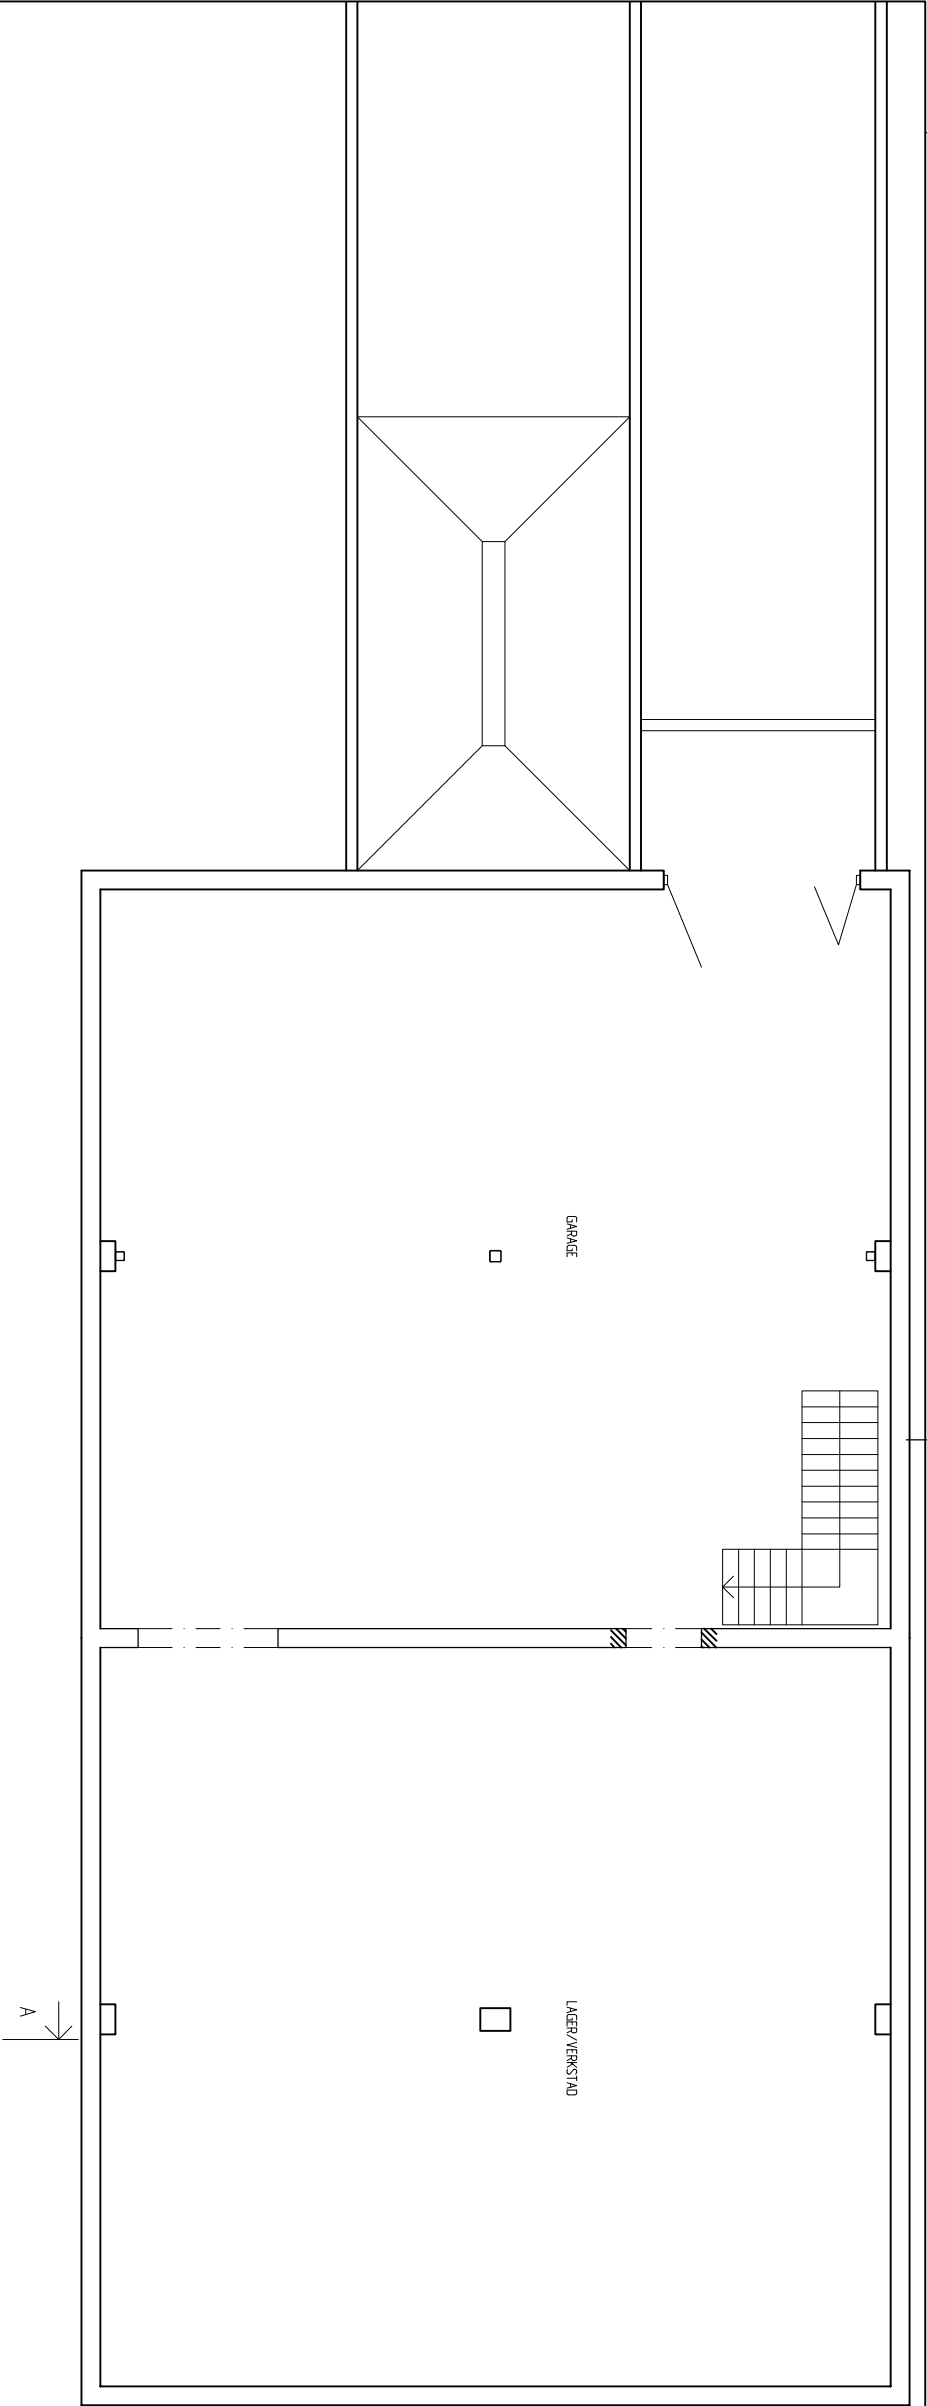

**HAKAN STRÖM**  
**BYGGNADS AB**

Ett Arbete i samarbete med

014 23 22 30

PROJEKTSKIVOR

BRÅN AV

2014-12-09

2014-12-09

