


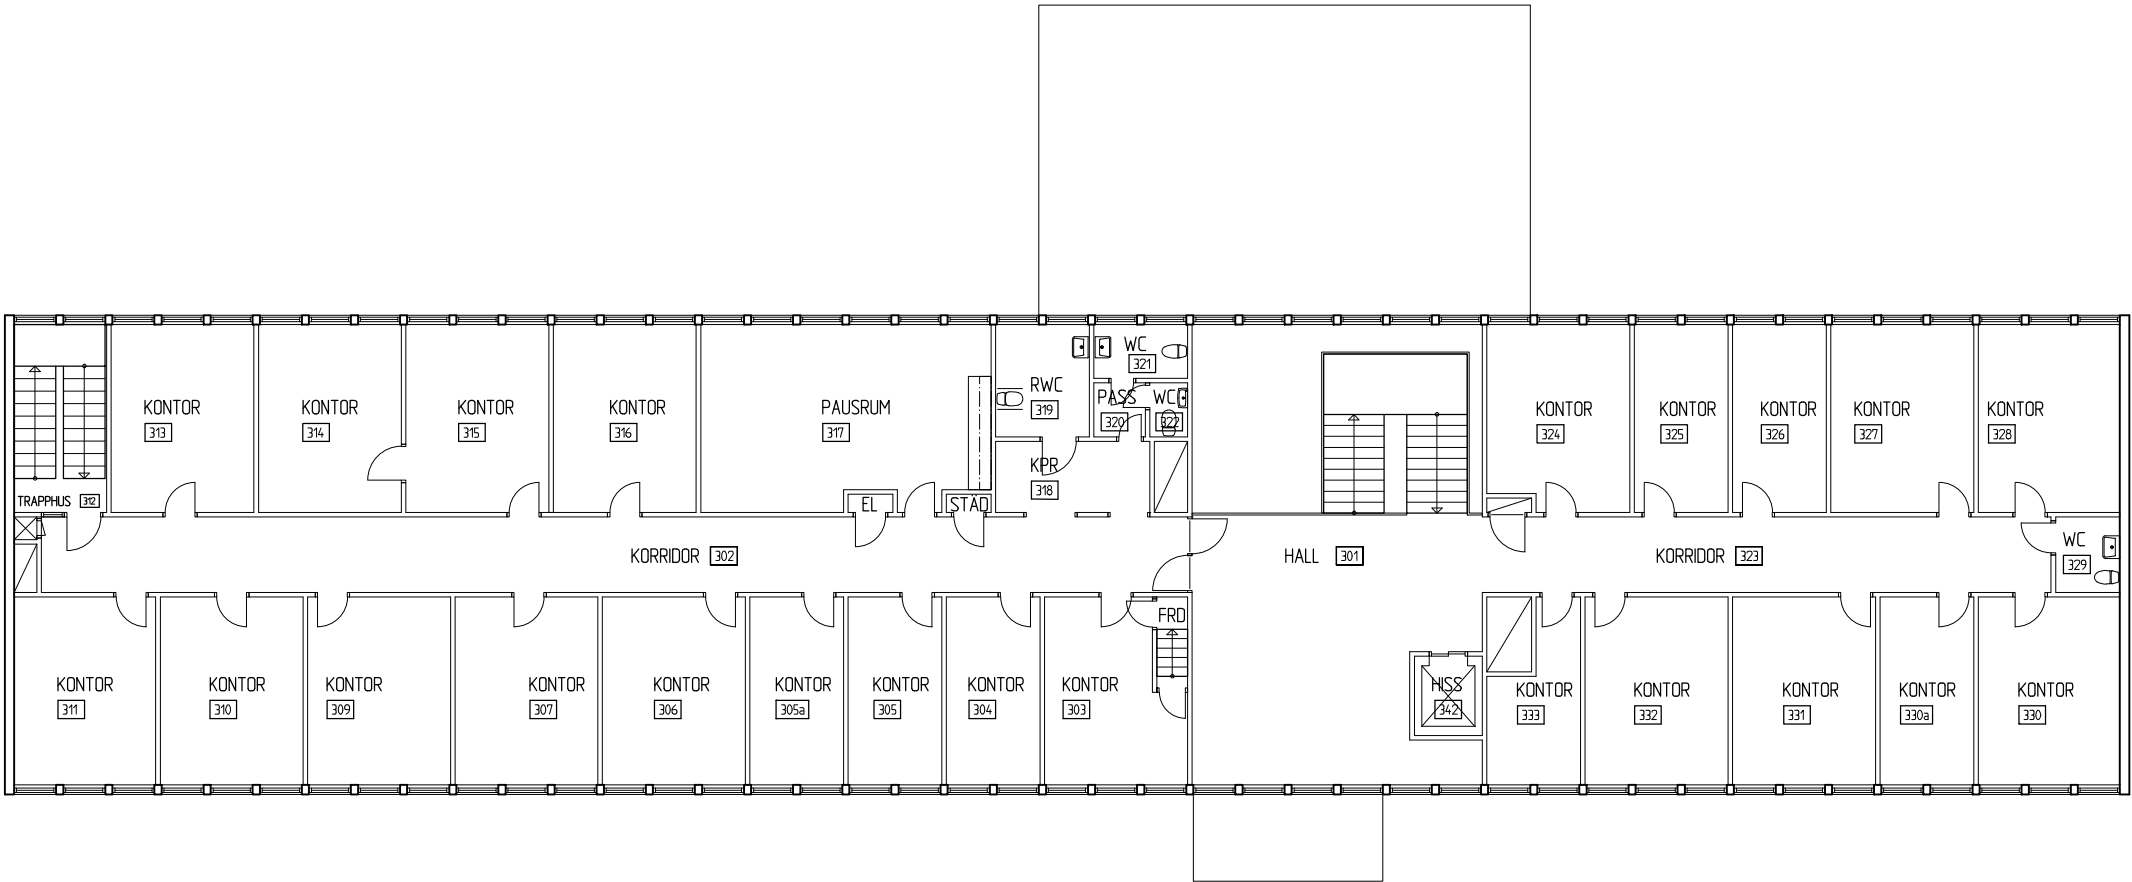

PLAN 3

BET	ANT	ÄNDRINGEN	AVSER	SIGN	DATUM
RELATIONSHANDLING					
ARBETSNUMMER 3102770500					
RITAD AV JD		HANDLAGGARE LN / JD			
DATUM 2013-10-25		ANSVARIG LN			
NEWSEC ASSET MANAGEMENT AB FANAN 26, HALMSTAD REGION HALLAND					
PLAN 3					
SKALA A3 = 1:200 A1 = 1:100		RITINGSNUMMER I REV A-40.1-103			