



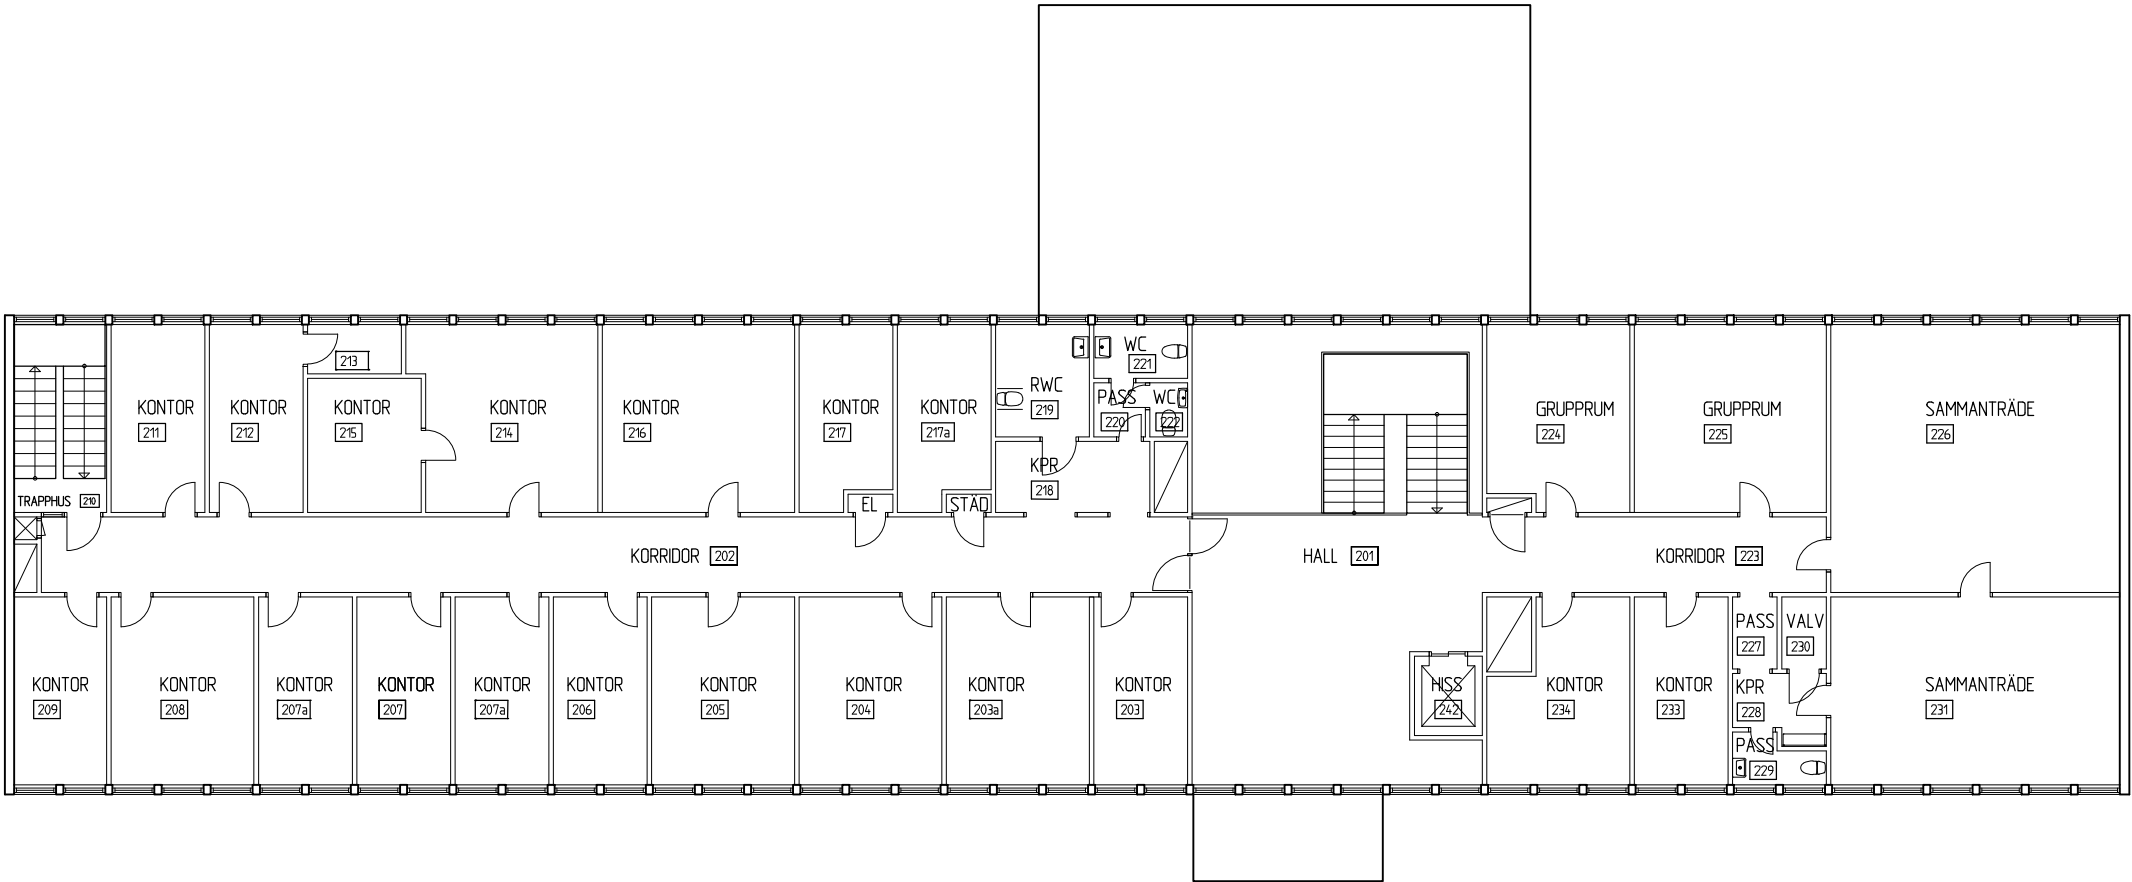

PLAN 2

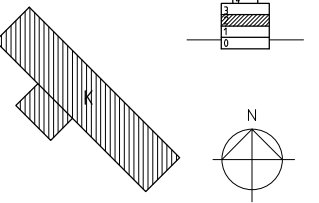

North arrow pointing up. Scale bar showing 0, 1, 2, 3, 4, 5, 6, 7, 8, 9, 10 meters.

BET	ANT	ÄNDRINGEN AVSER	SIGN	DATUM
RELATIONSHANDLING				
NEWSEC		alecta		
white Byråhusen 13, 302 50 00 00 Halmstad Tel +46 030 65 00 00 Fax +46 030 65 00 10				
ARBETSNUMMER 3102770500		RITAD AV JD	HANDLAGGARE LN / JD	
DATUM 2013-10-25		ANSVARIG LN		
NEWSEC ASSET MANAGEMENT AB FANAN 26, HALMSTAD REGION HALLAND				
PLAN 2 SKALA A3 = 1:200 A1 = 1:100		RITNINGNUMMER A-40.1-102 REV		