

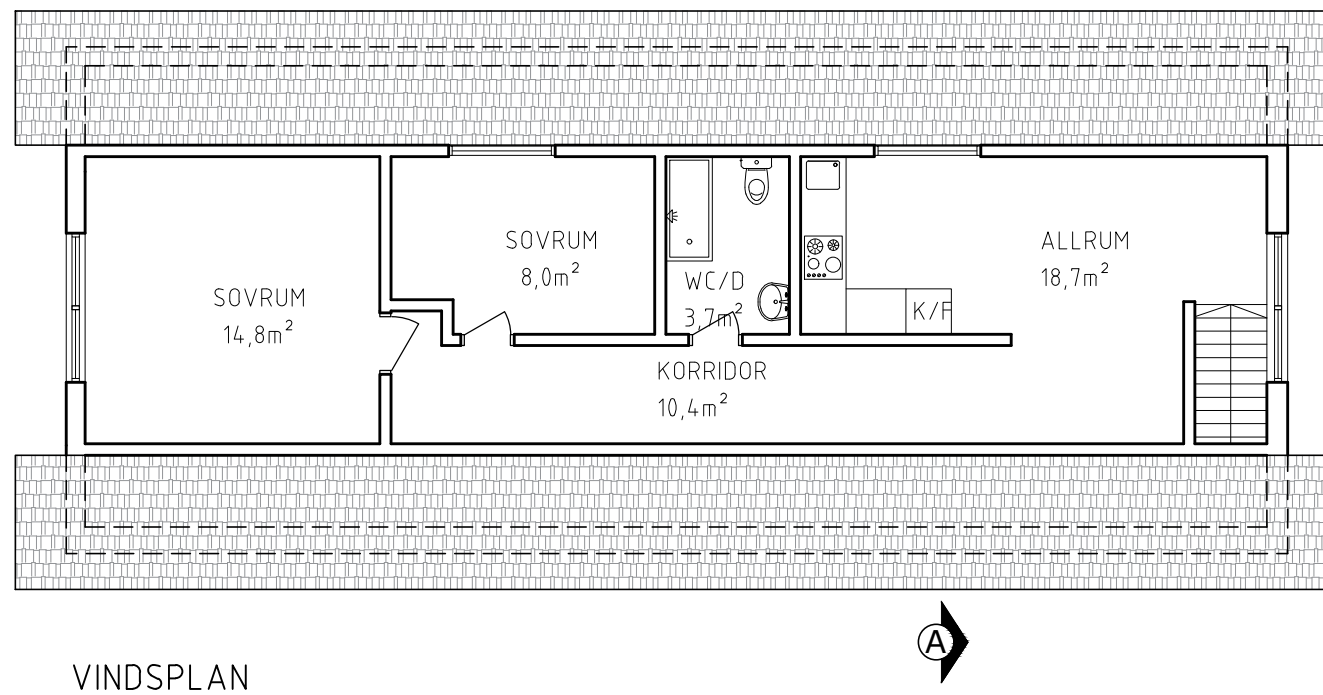
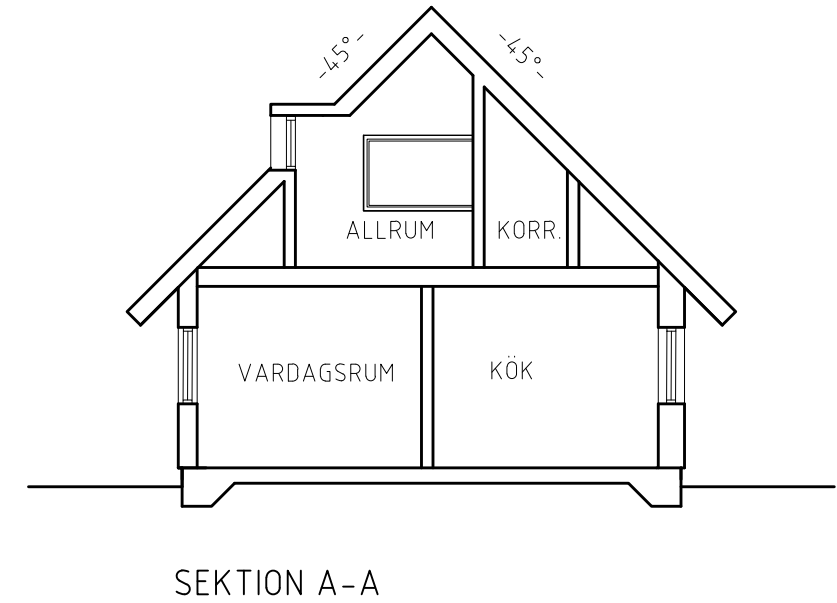


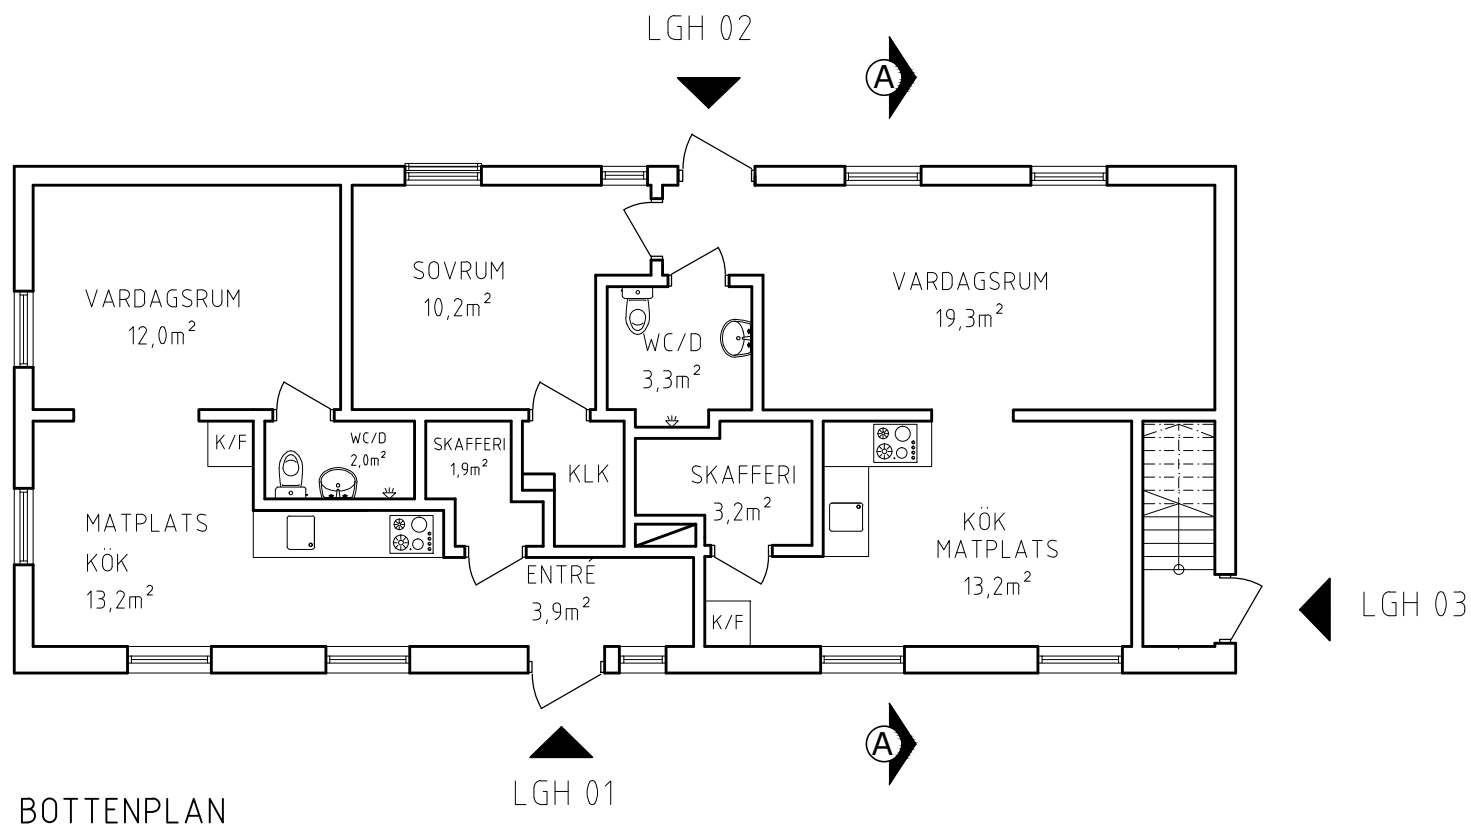

SKALA 1:100

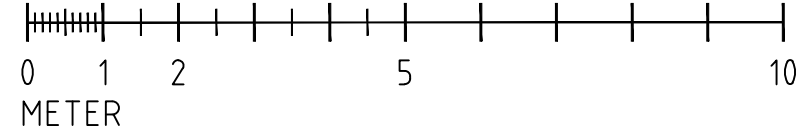

LGH 01 - 33m²

LGH 02 - 49,2m²

LGH 03 - 55,6m²

RELATIONSHANDLING	
OLOFSBO 1:42 FALKENBERG KOMMUN	
BOTTENPLAN, VINDSPLAN SEKTION A-A	
RITAD AV: AS	DATUM: 2021-03-26
SKALA A3 1:100	RITNING NR. 1