



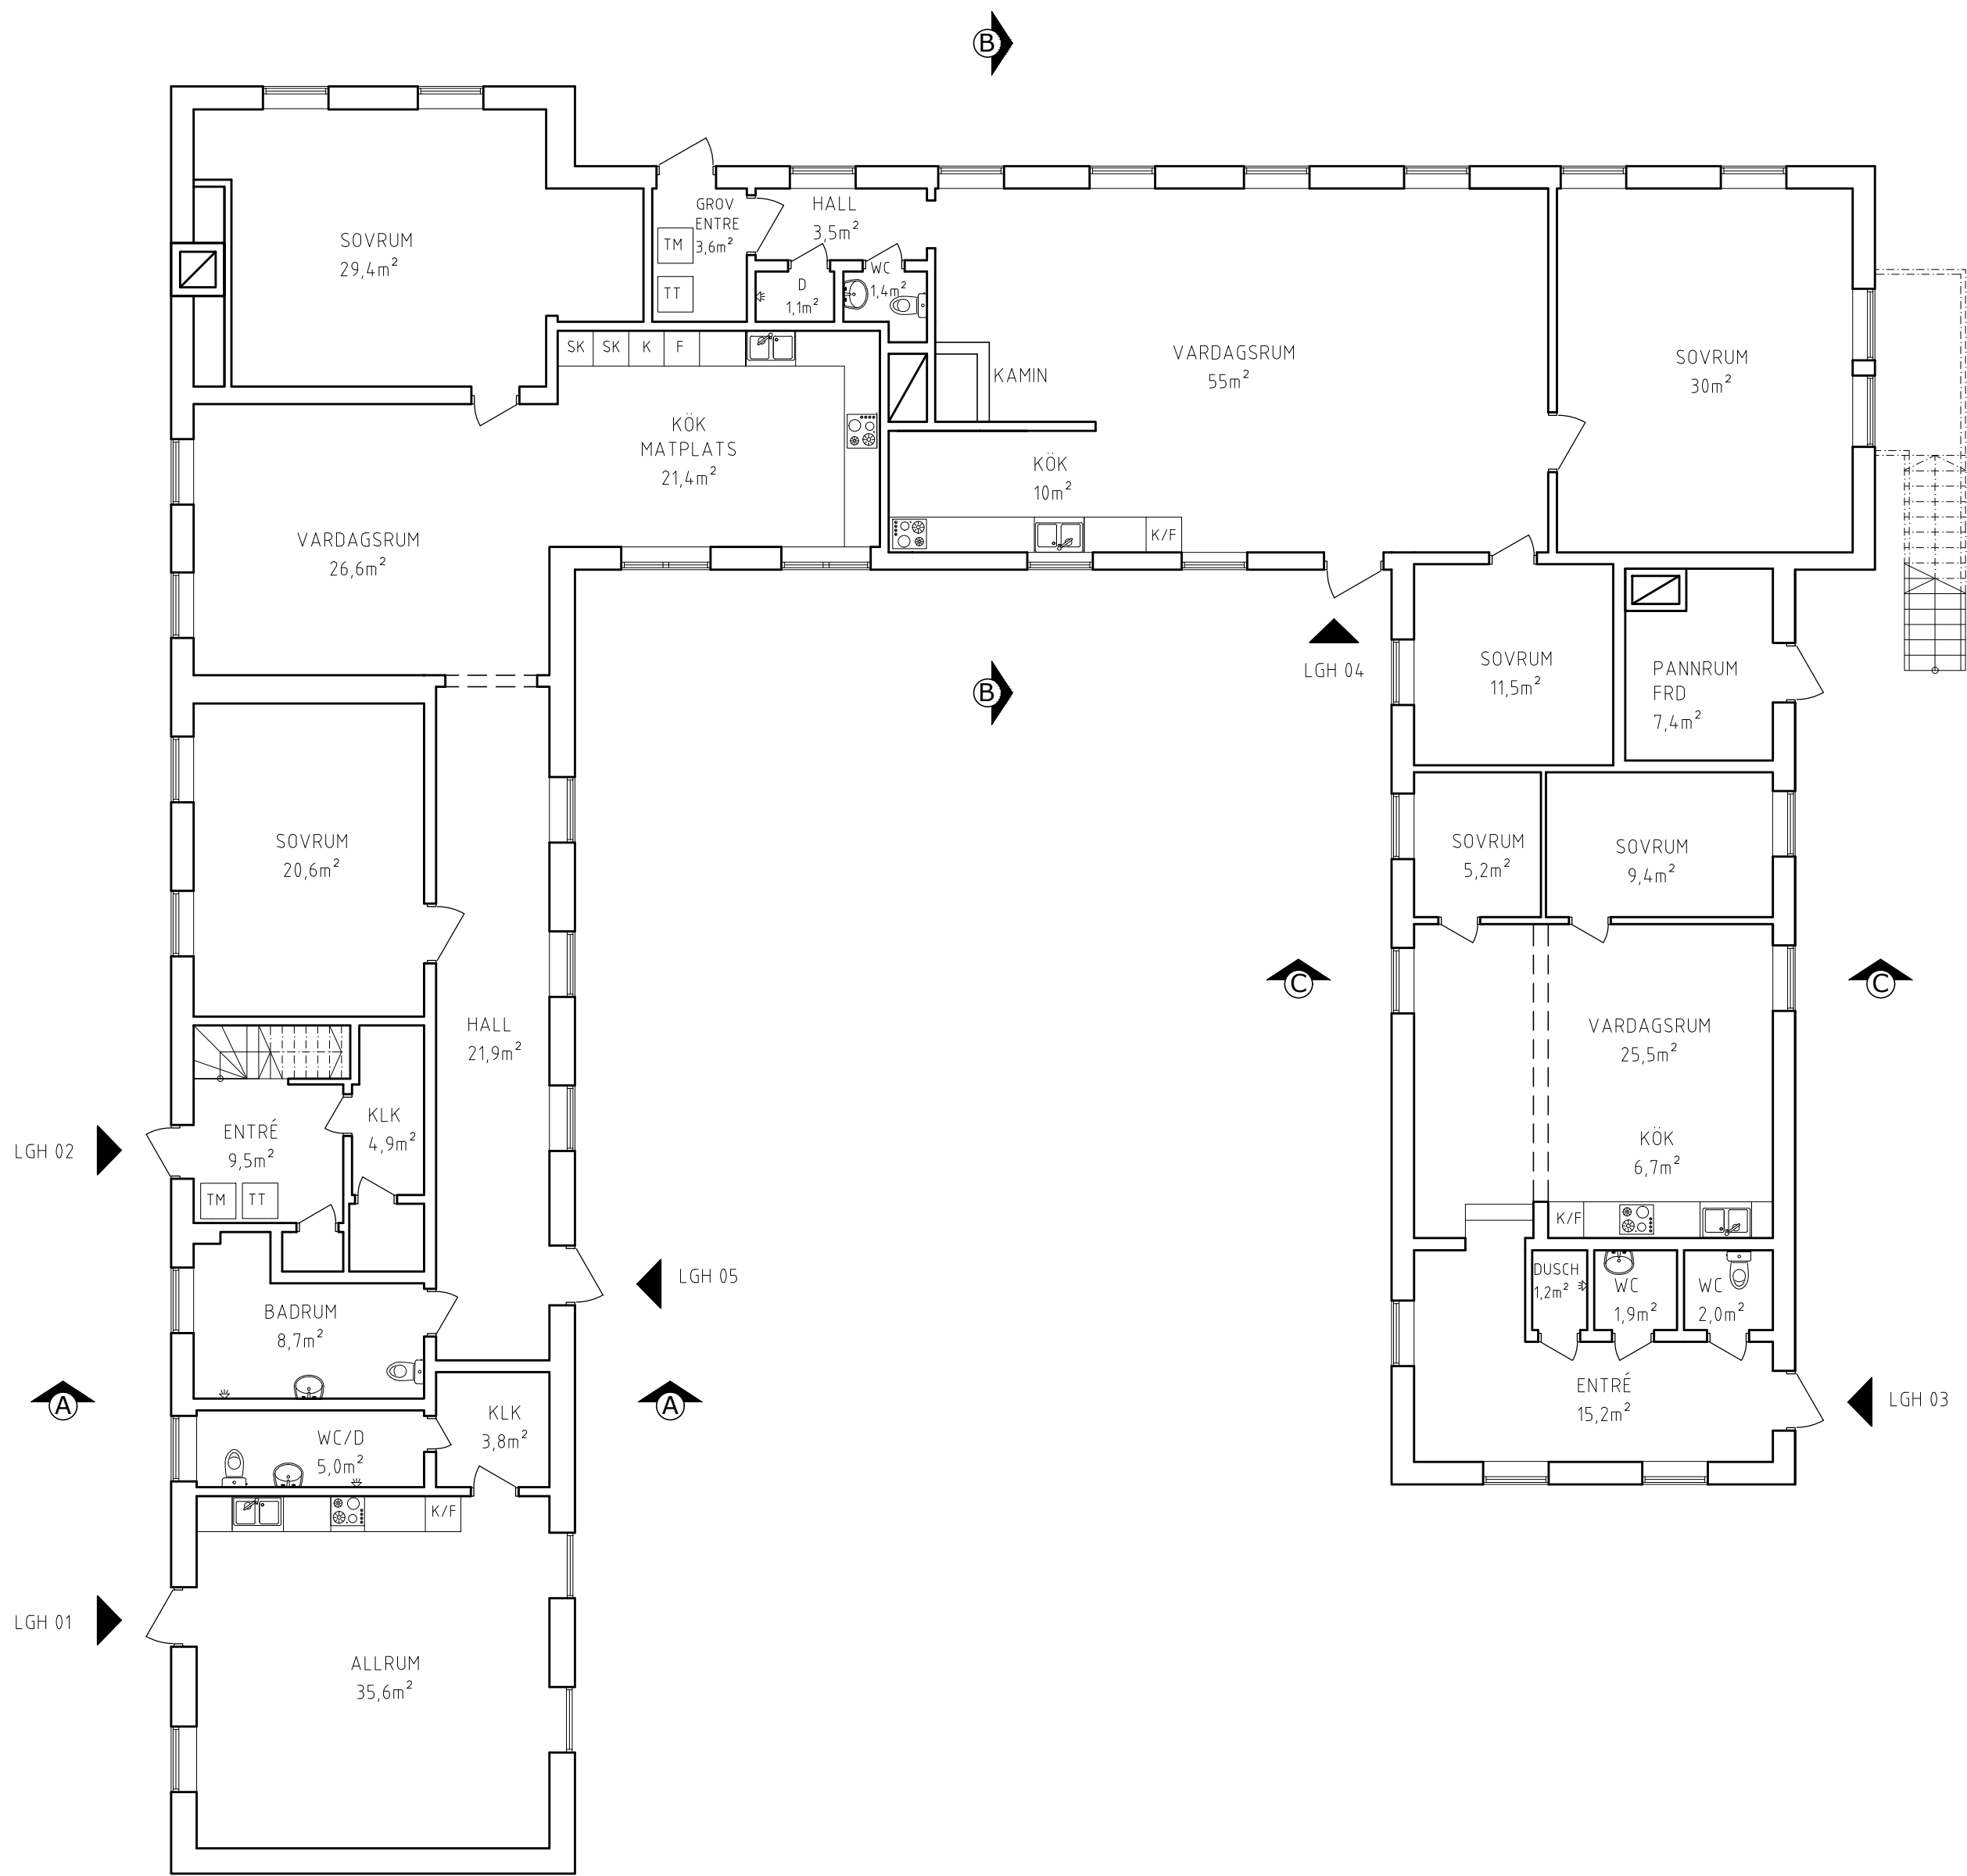

BOTTENPLAN

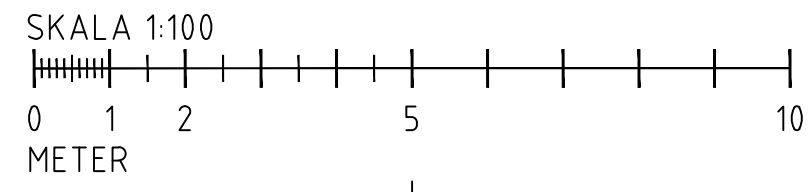

- LGH 01 - 44,4m²
- LGH 02 - 177m²
- LGH 03 - 67,1m²
- LGH 04 - 123,5m²
- LGH 05 - 128,6m²
- LGH 06 - 119,5m²

RELATIONSHANDLING	
OLOFSBO 1:43 FALKENBERG KOMMUN	
BOTTENPLAN	
RITAD AV: AS	DATUM: 2021-03-26
SKALA A2 1:100	RITNING NR. 1