

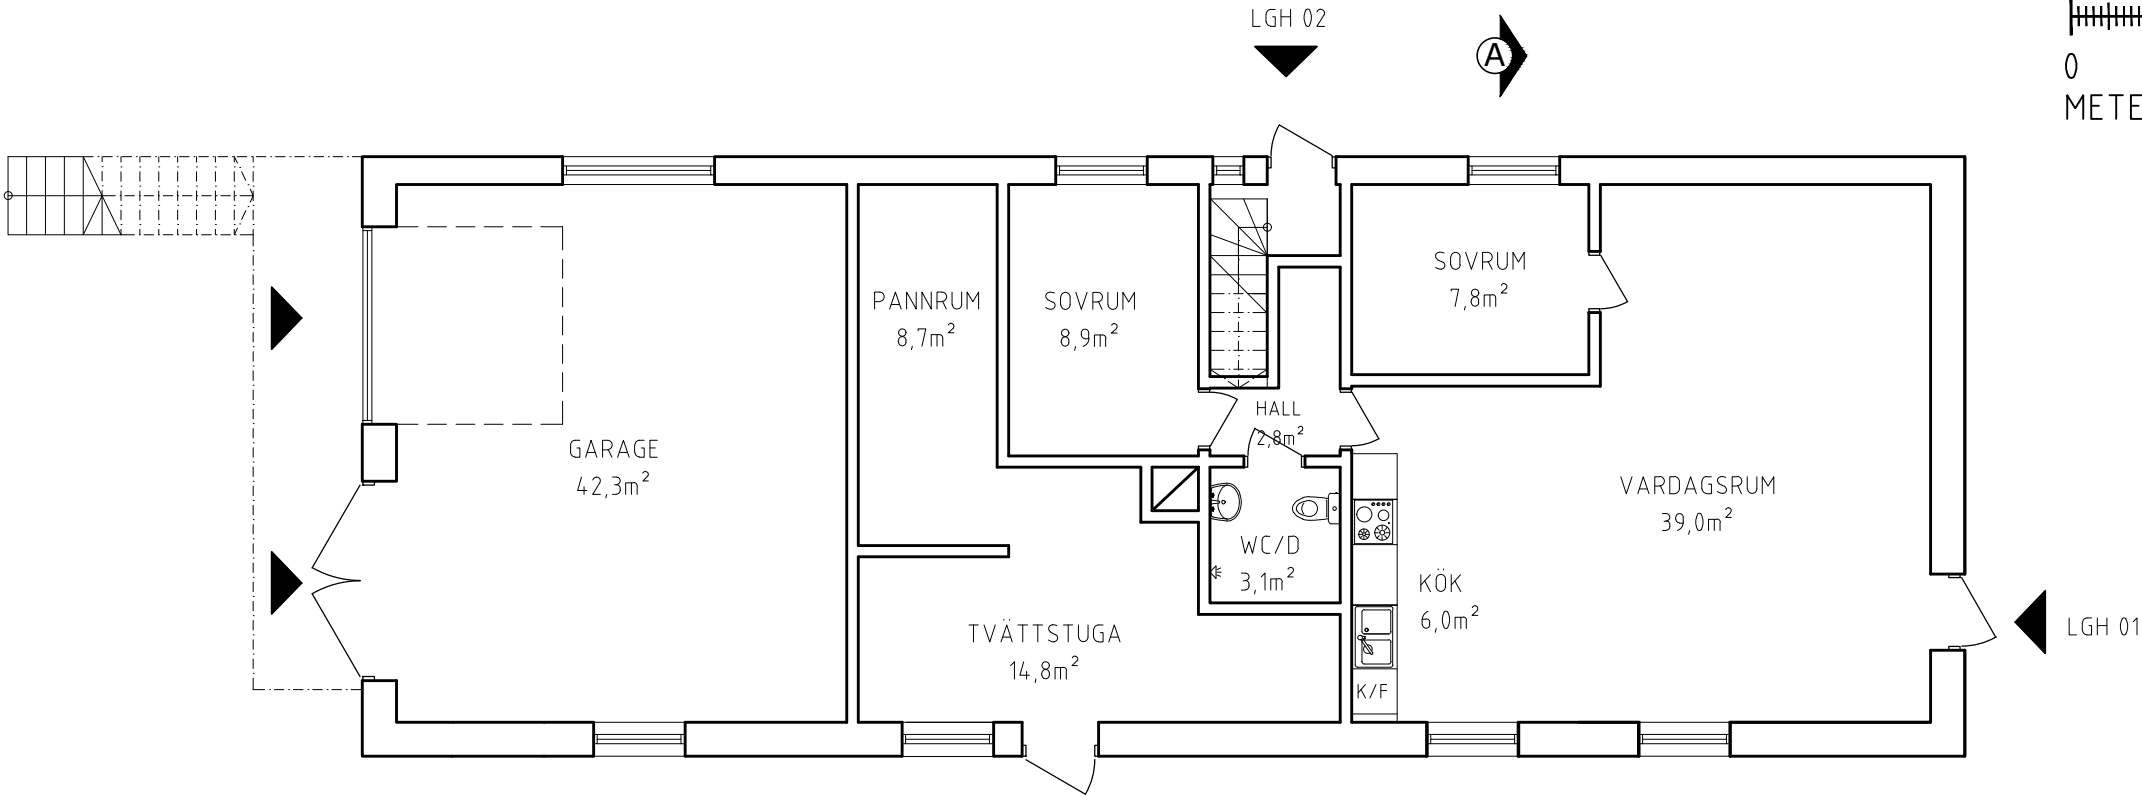


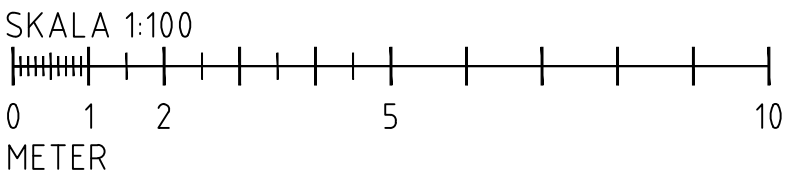

BOTTENPLAN

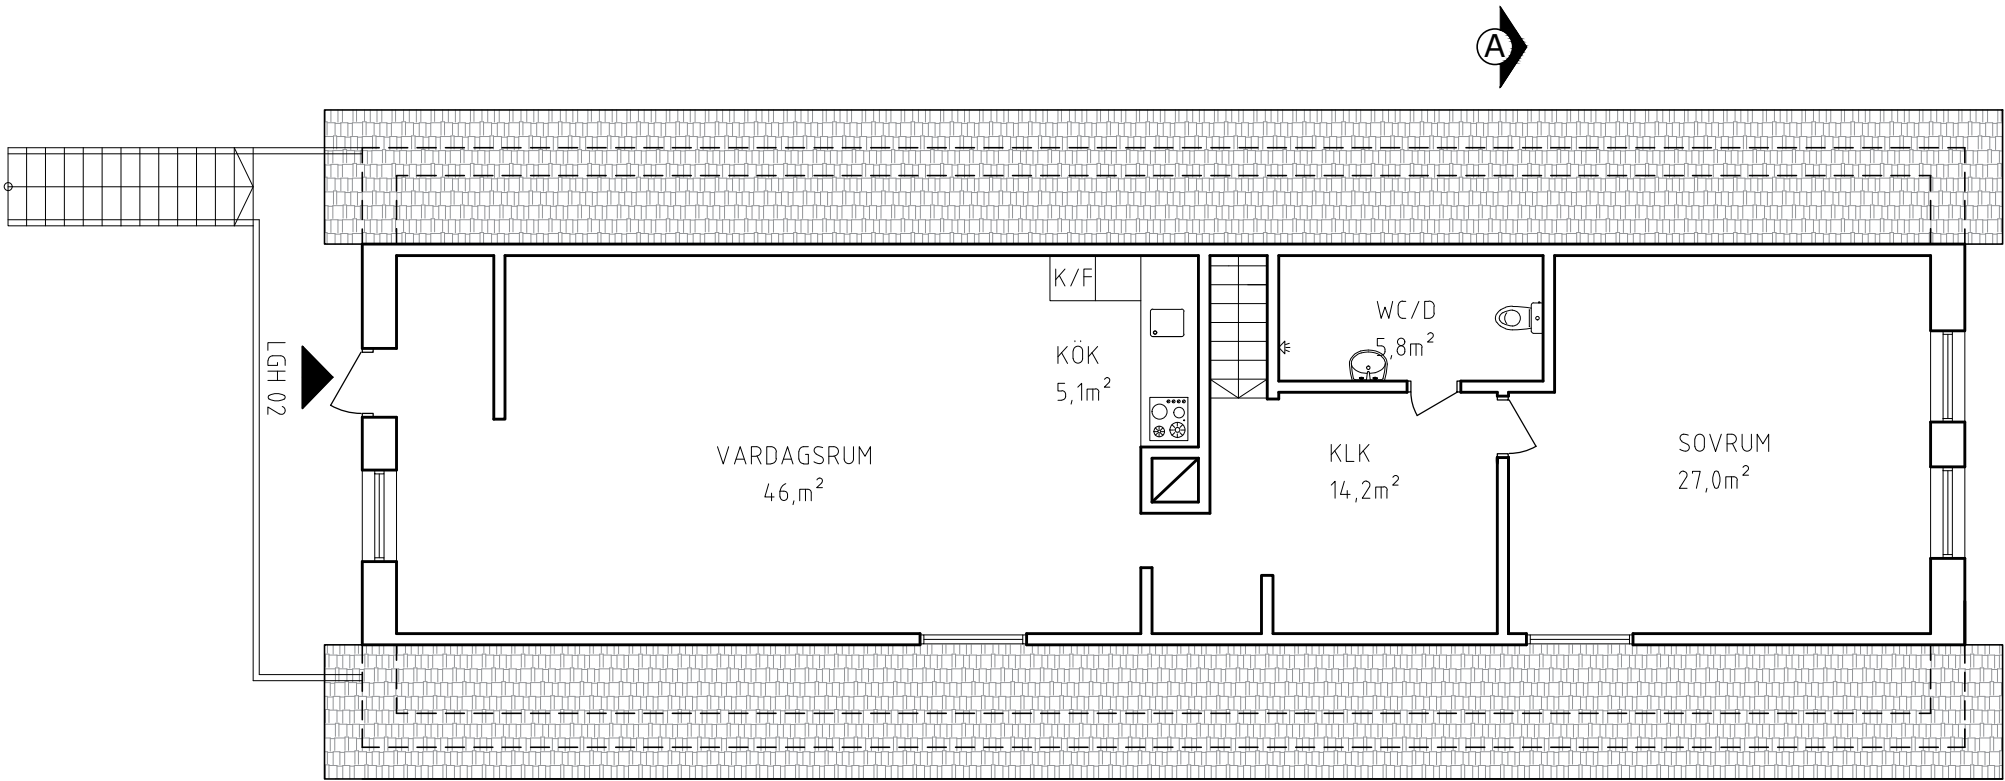

VINDSPLAN

LGH 01 - 67,6m²
LGH 02 - 98,5m²

RELATIONSHANDLING	
OLOFSBO 1:42 FALKENBERG KOMMUN	
BOTTENPLAN VINDSPLAN	
RITAD AV: AS	DATUM: 2021-03-26
SKALA A3 1:100	RITNING NR. 1