


5001, 45 m2 enligt FastNet.
Vilken del?/MK

210 kvm

317	101	INOMRÅD	2020	2020
RELATIONSHANDLING				

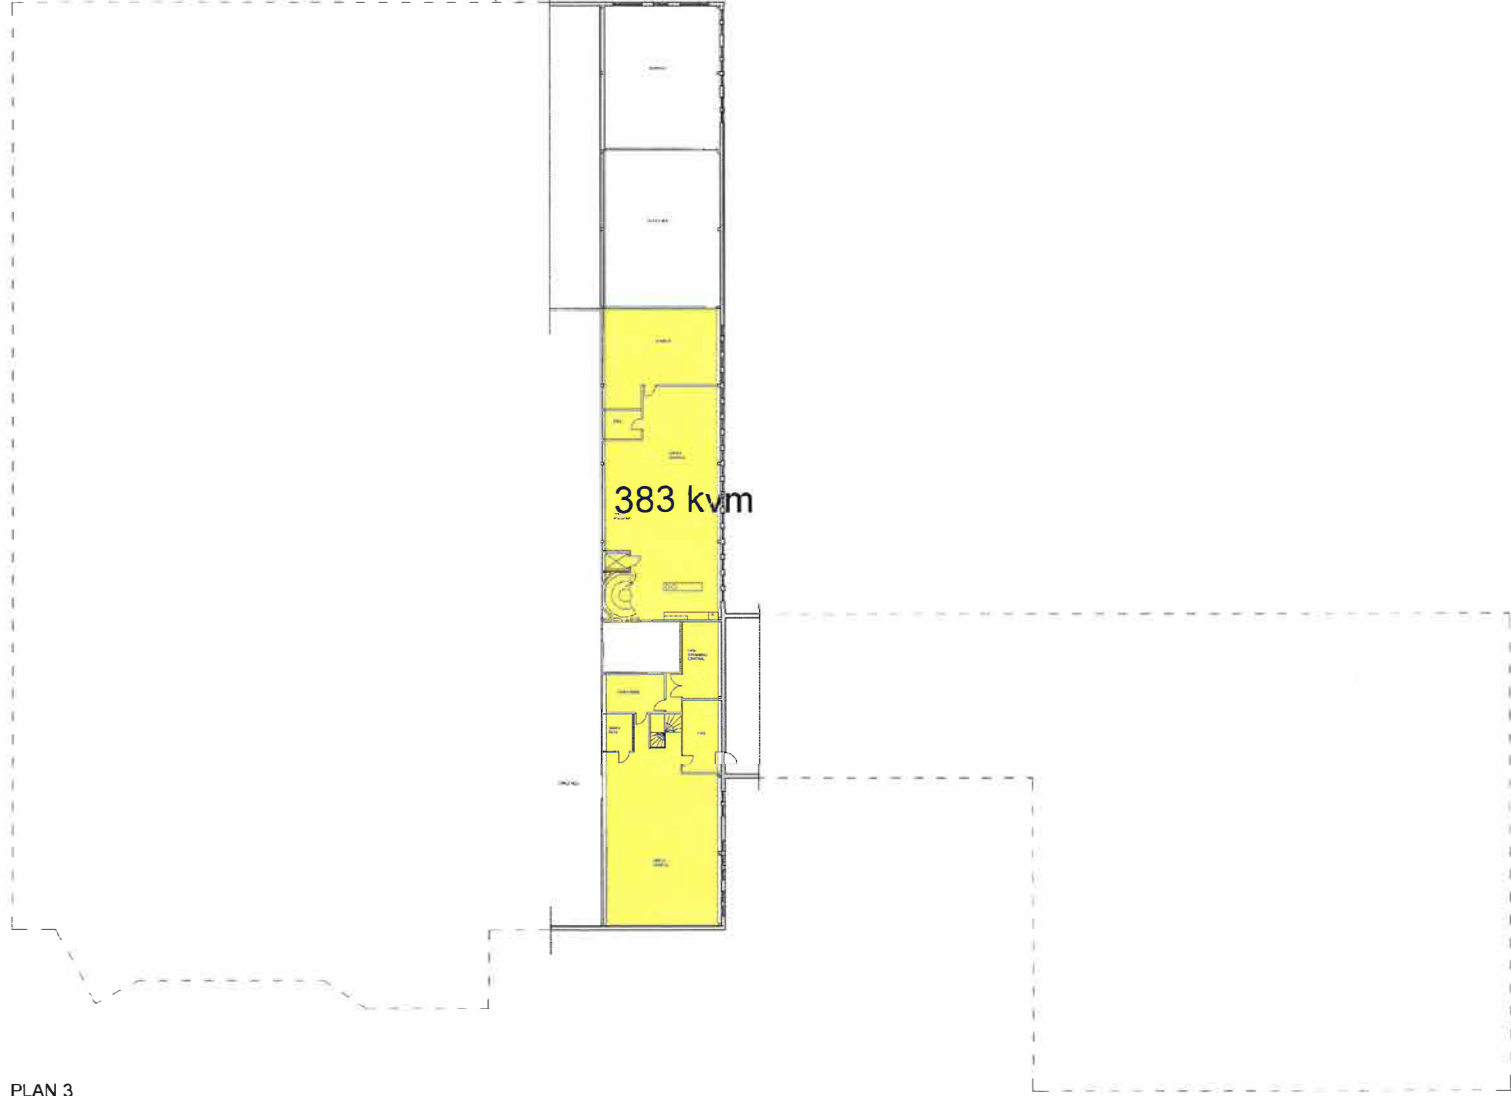

PLAN 3



ART	NET	KOD/NO
RELATIC		
 A R K I <small>Autonoomy 12 100 24 100 100 100 www.dic-arkki.com</small>		
PROJEKTINUMMI	PII	PII
160226	JH	PW
KV KOPPAHN 1. NO		
PLAN 3		
PAIKKA	PAIKKA	PAIKKA
AT 1:200		7