


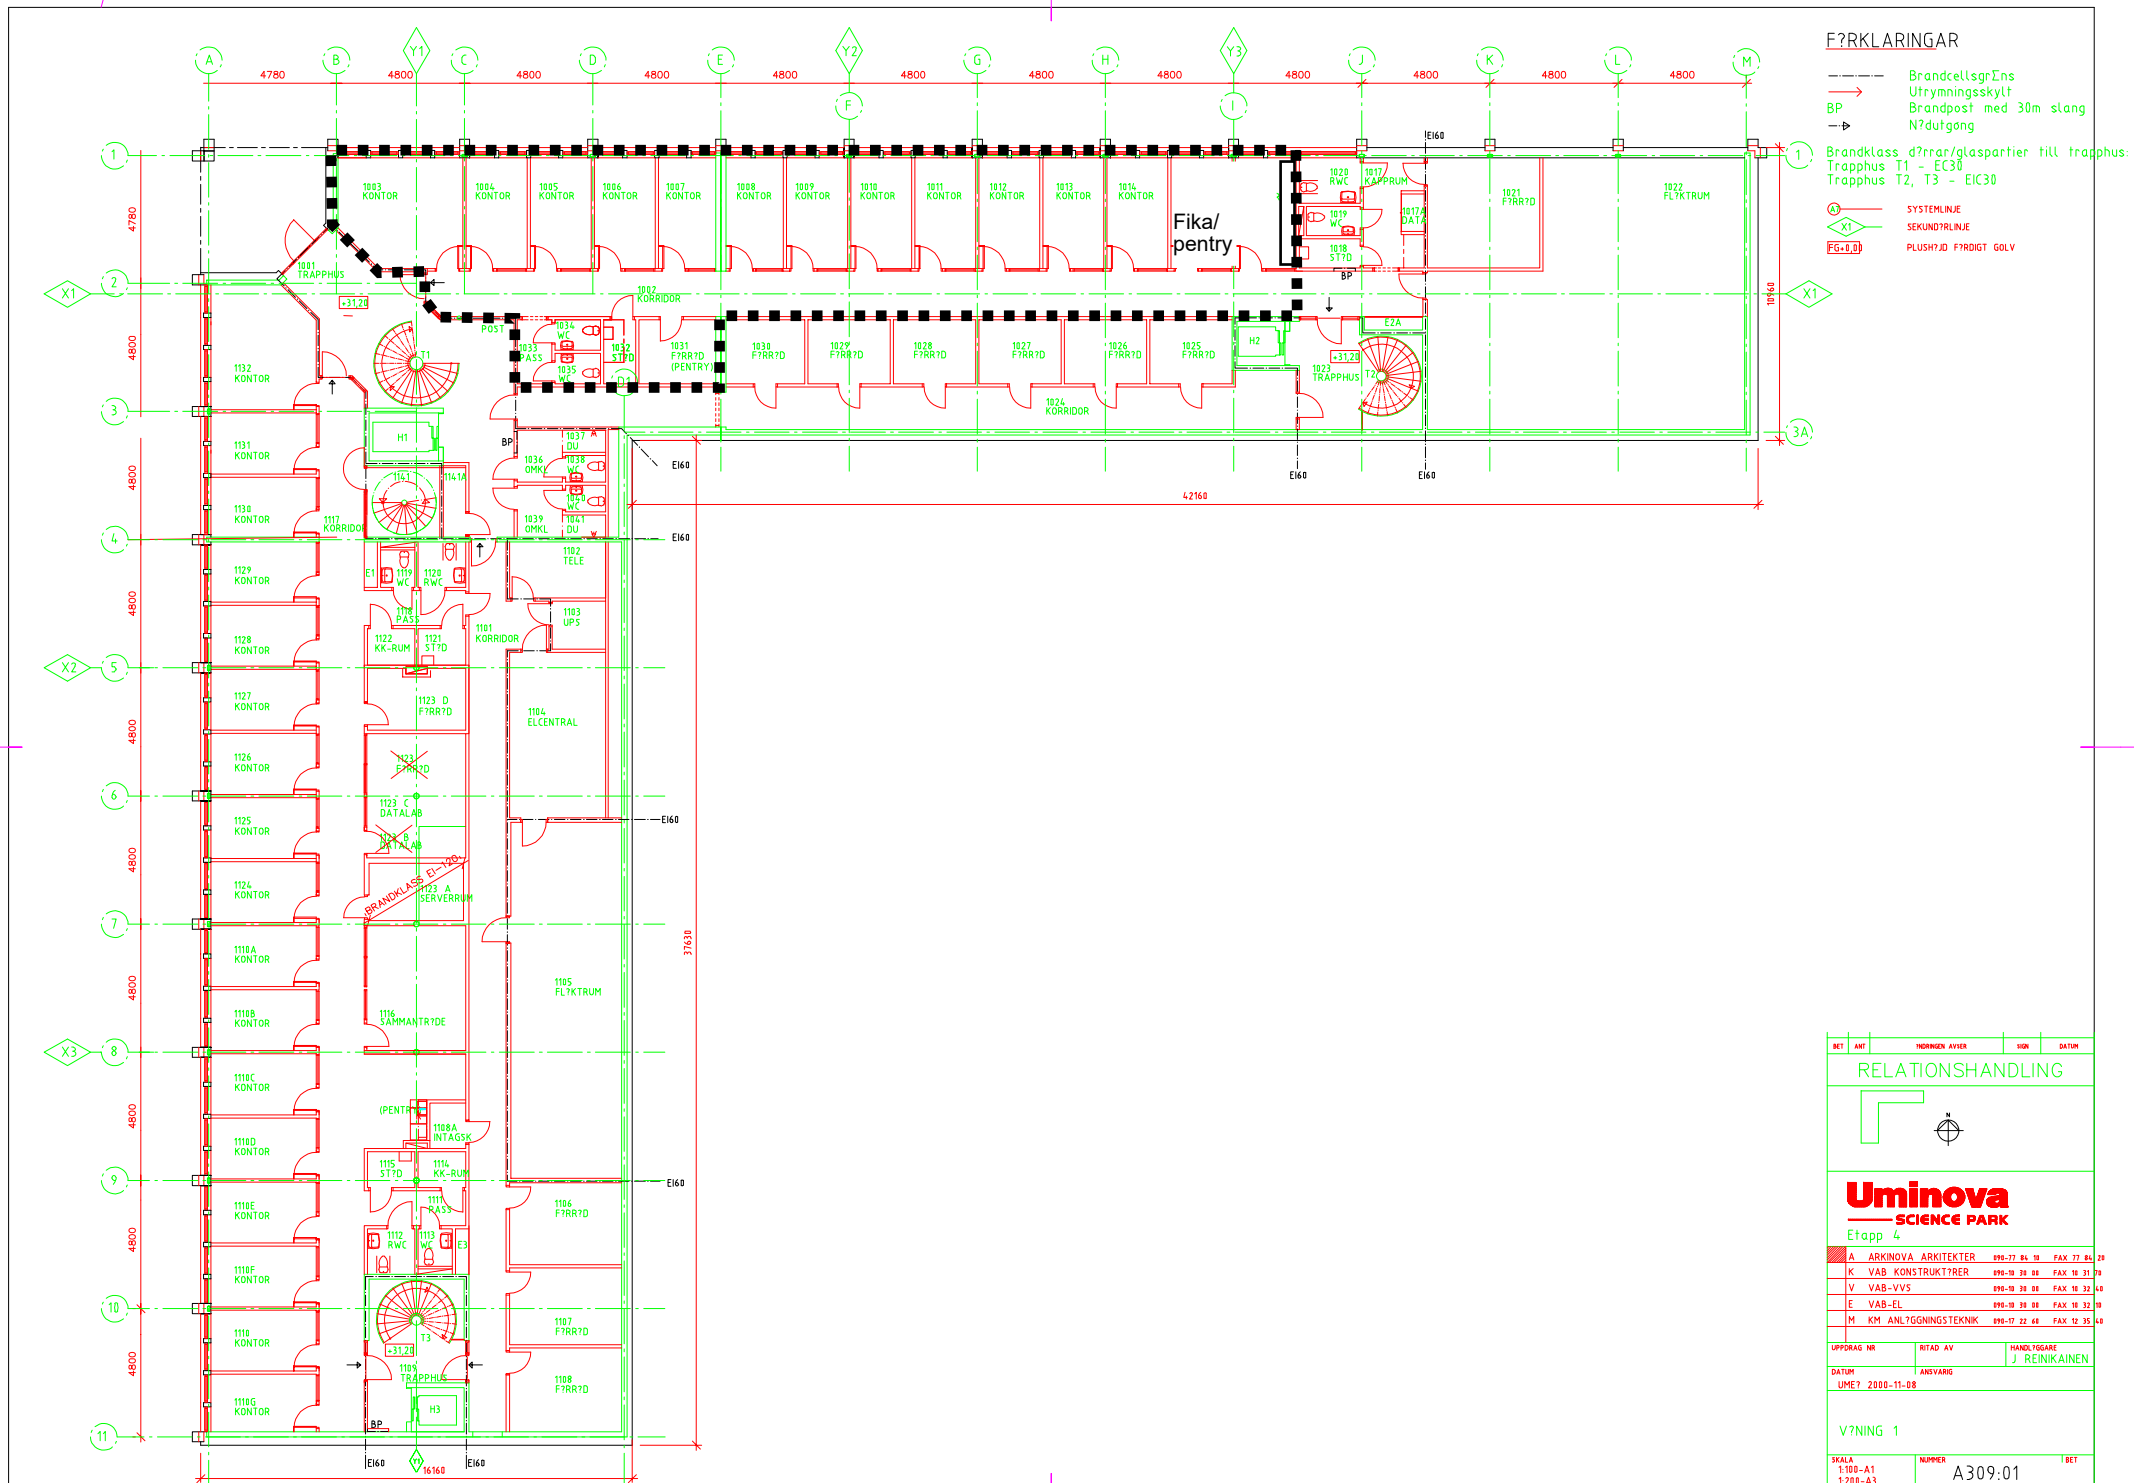

BET	ANT	INDBRINGER AYNER		SIGN	DATUM	
RELATIONSHANDLING						
 						
 Uminova SCIENCE PARK						
Etapp 4						
A	ARKINOVA ARKITEKTER		990-17 84 18	FAX 17 84 18		
	K VAB KONSTRUKTØRER		990-19 38 08	FAX 19 38 08		
	V VAB-VVS		990-19 38 08	FAX 19 38 08		
	E VAB-EL		990-19 38 08	FAX 19 38 08		
	M KM ANLÆGSGNINGS-TEKNIK		990-17 22 48	FAX 12 25 35		
UPDRAG NR			RITAD AV	HANDLINGSARE	J REINIKAINEN	
DATUM			ANSVARG			
UMET 2000-11-08						
V?NING 1						
SKALA	NUMMER				BET	
1:100-A1 1:200-A3	A309:01					