


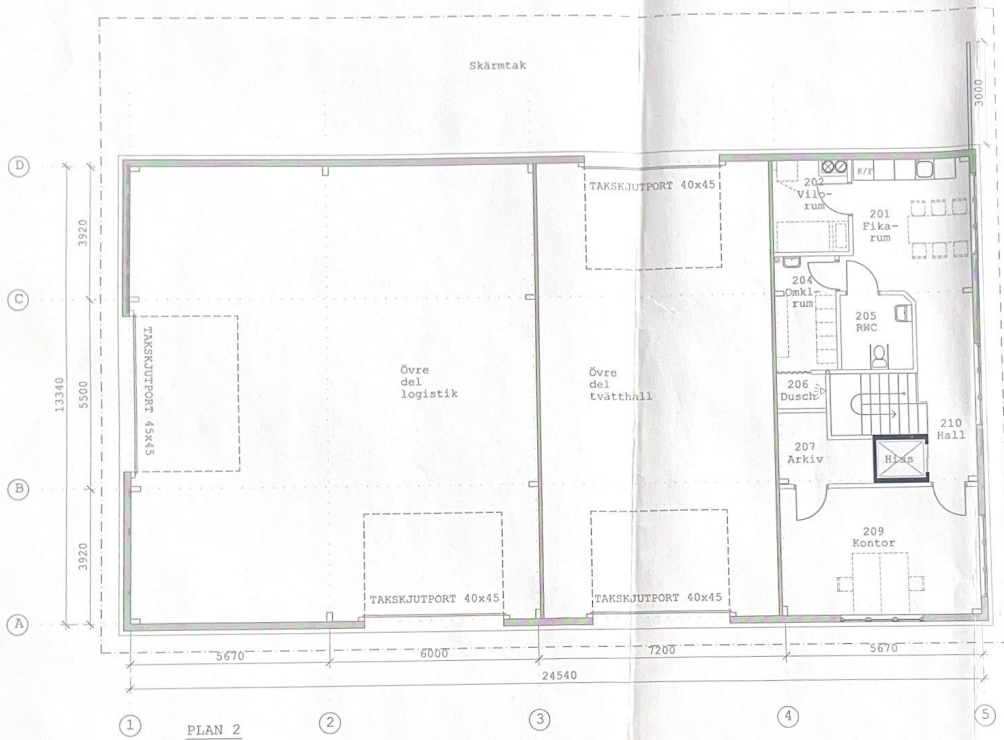

RELATIONSHANDLING			
AB LINDBORG & SÖNER Örnsköldsvik www.lindborgsoner.se			
Dalby Lots Libroback-Uppsala			
21000	ALL	ALL	ALL
2012-08-06	ALL		
HUSBYBORG 127			
PLAN 2			
1:100/ A3		A40:1-201	