


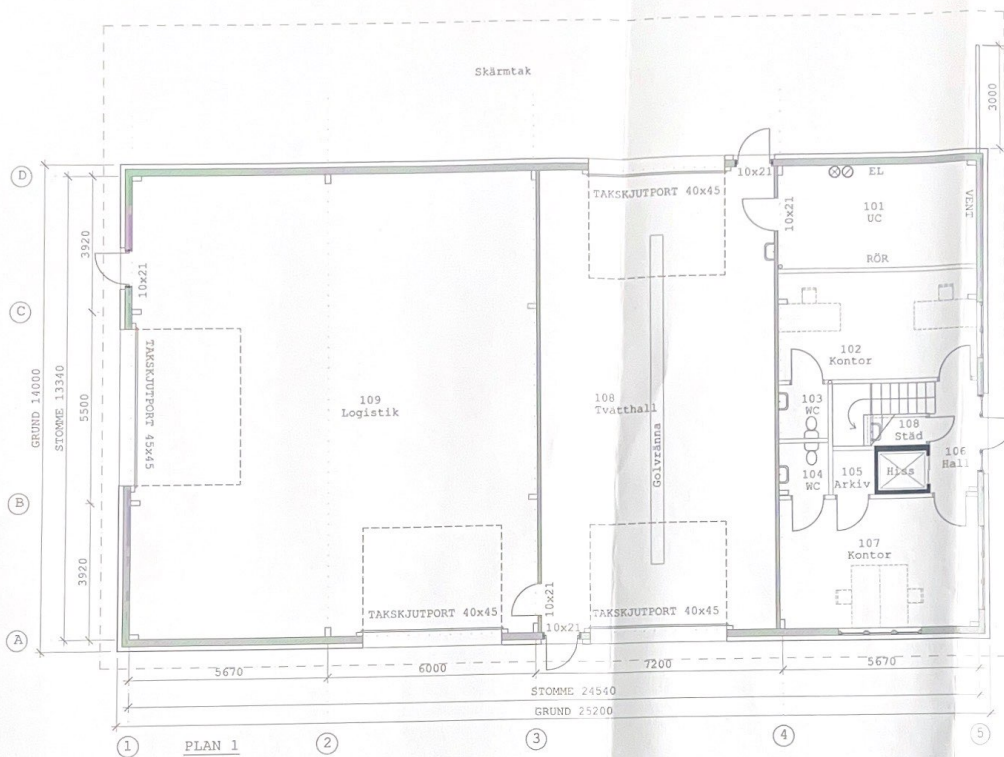

RELATIONSHANDLING			
AB LINDBORG & SÖNER Örnsundsbro www.lindborgsoner.se			
Dalby Lots Librobäck-Uppsala			
21005	ALU	ALU	
2012-06-05	ALU		
HUSBYBORG 127			
PLAN 1			
1:100/A3		A 40.1.101	