


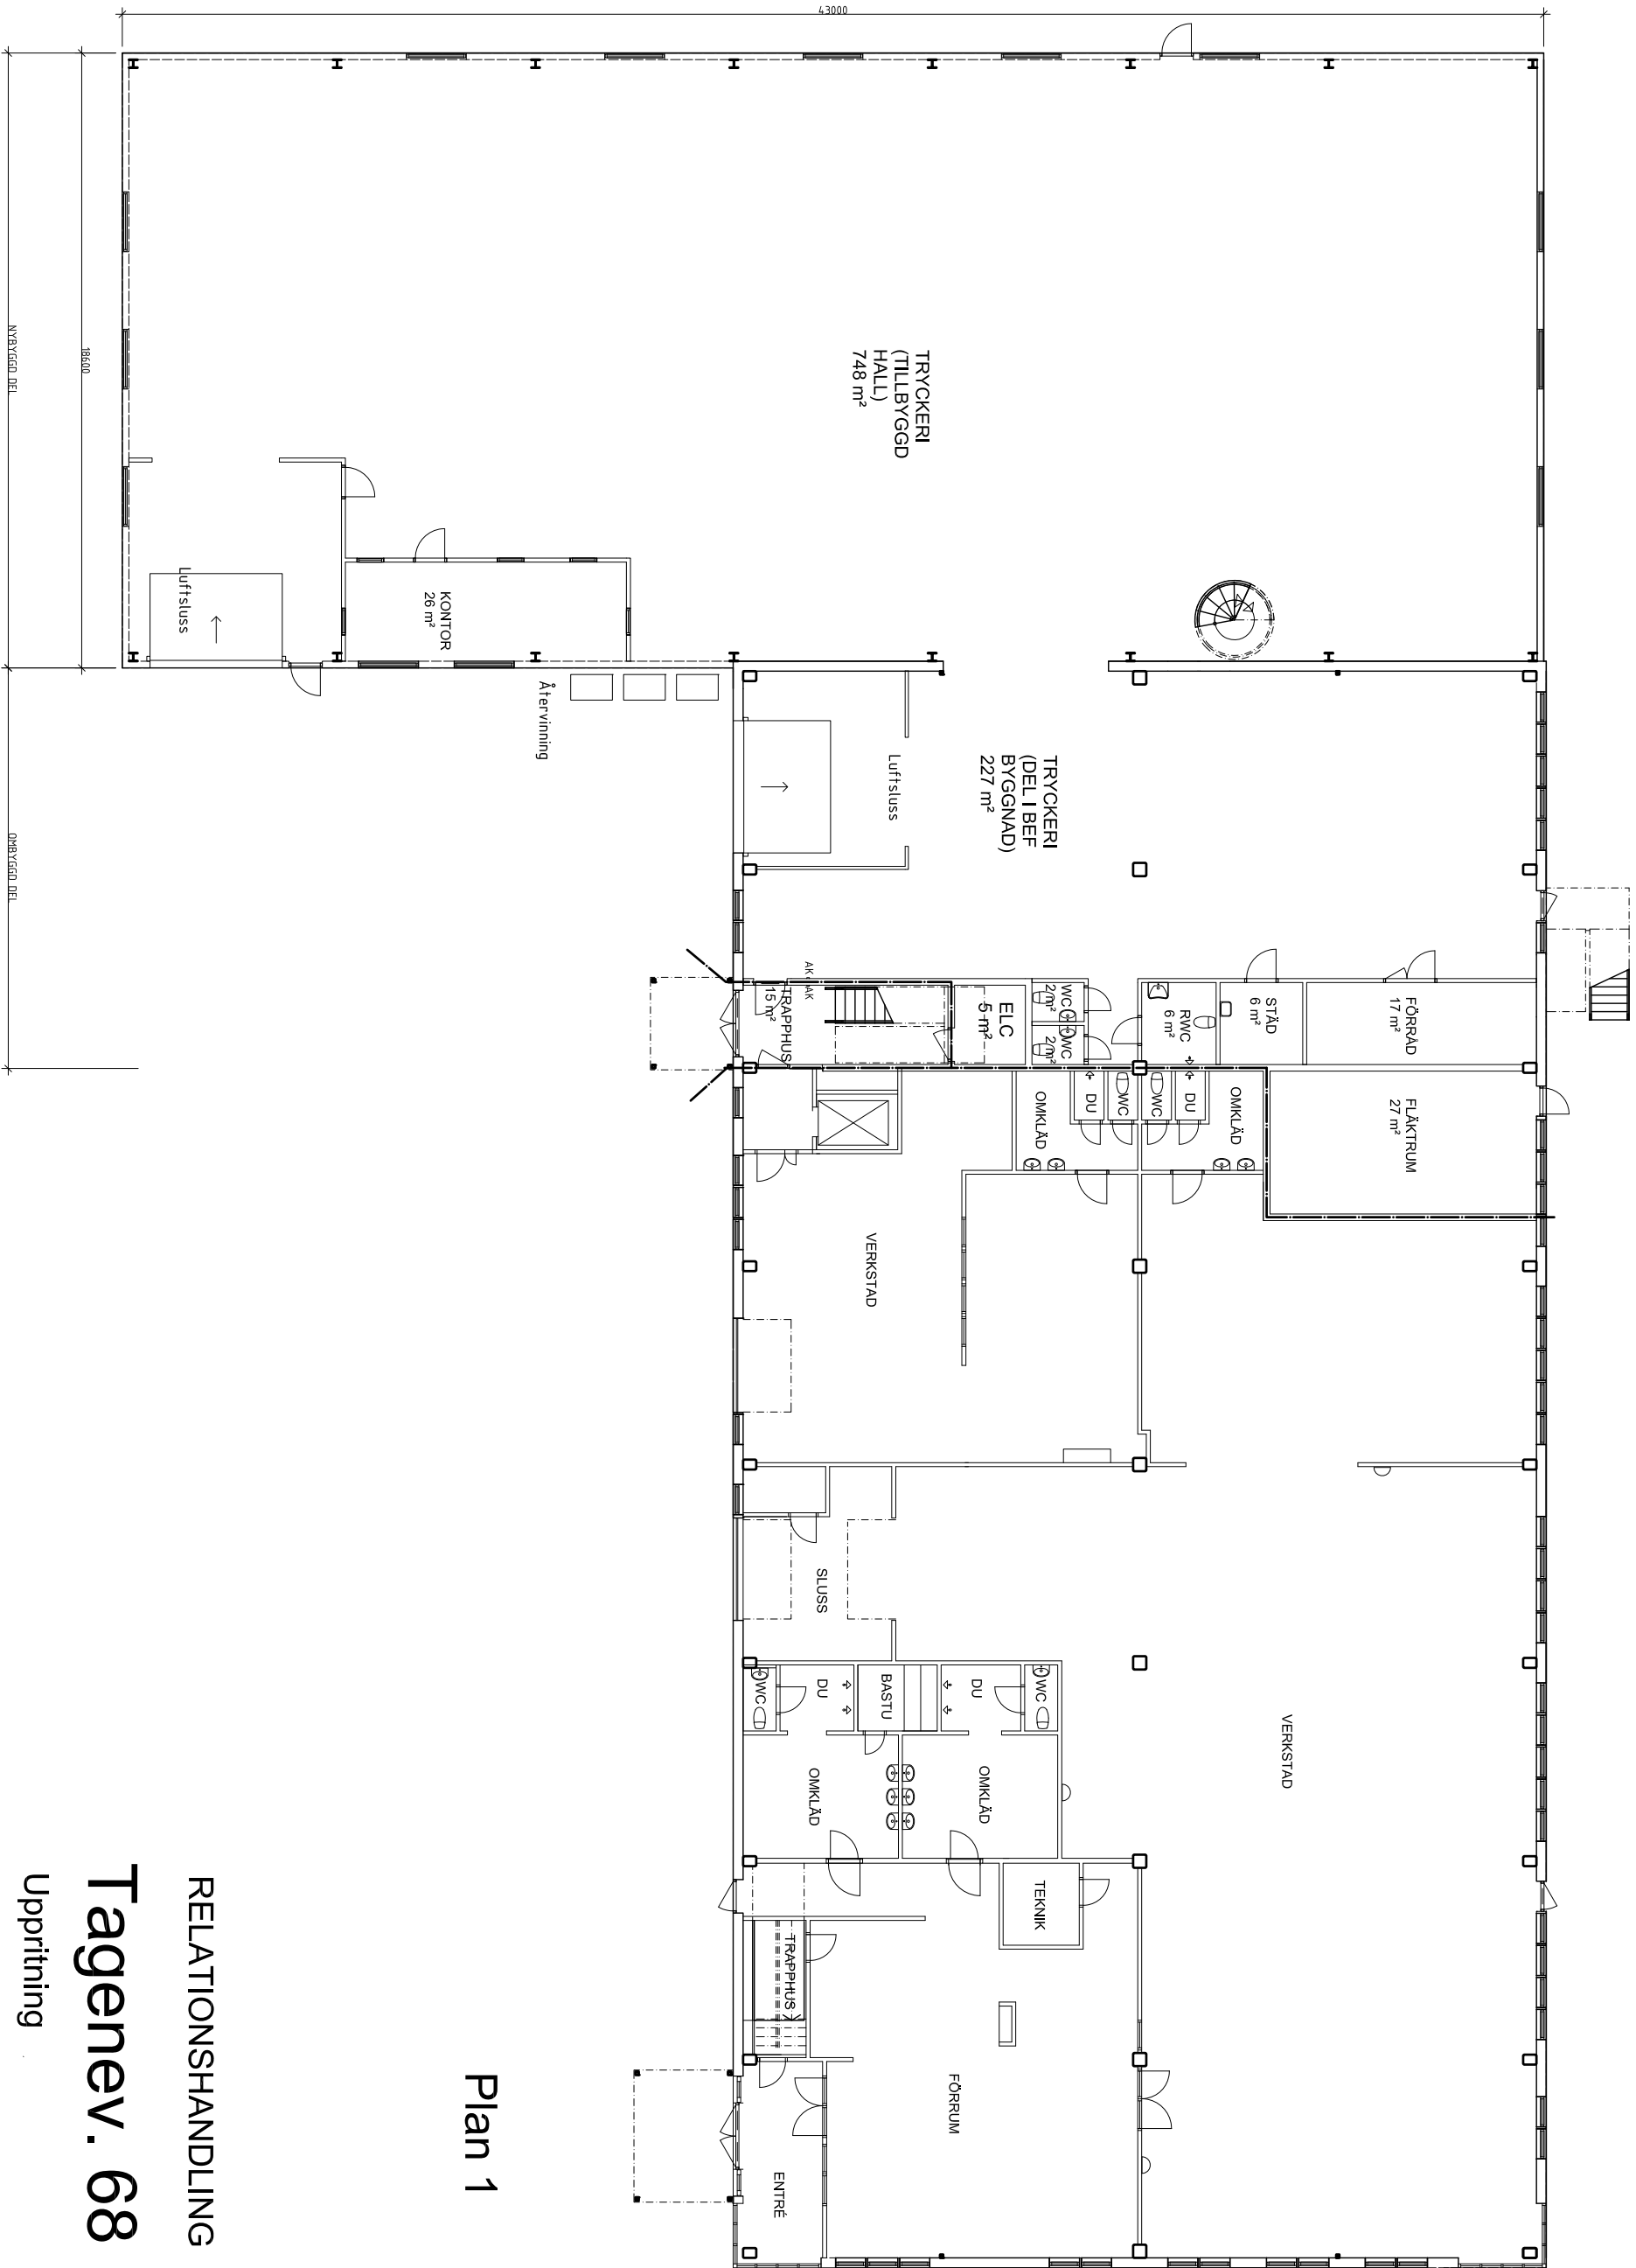

Plan 1

RELATIONSHANDLING

Tagenev. 68

Uppritning

2021 10 05

0704 - 00 71 00

ARKITEKTHIILEN AB