




KV SKYTTE 2 - SOLNA
RELATIONSHANDLING PLAN 5

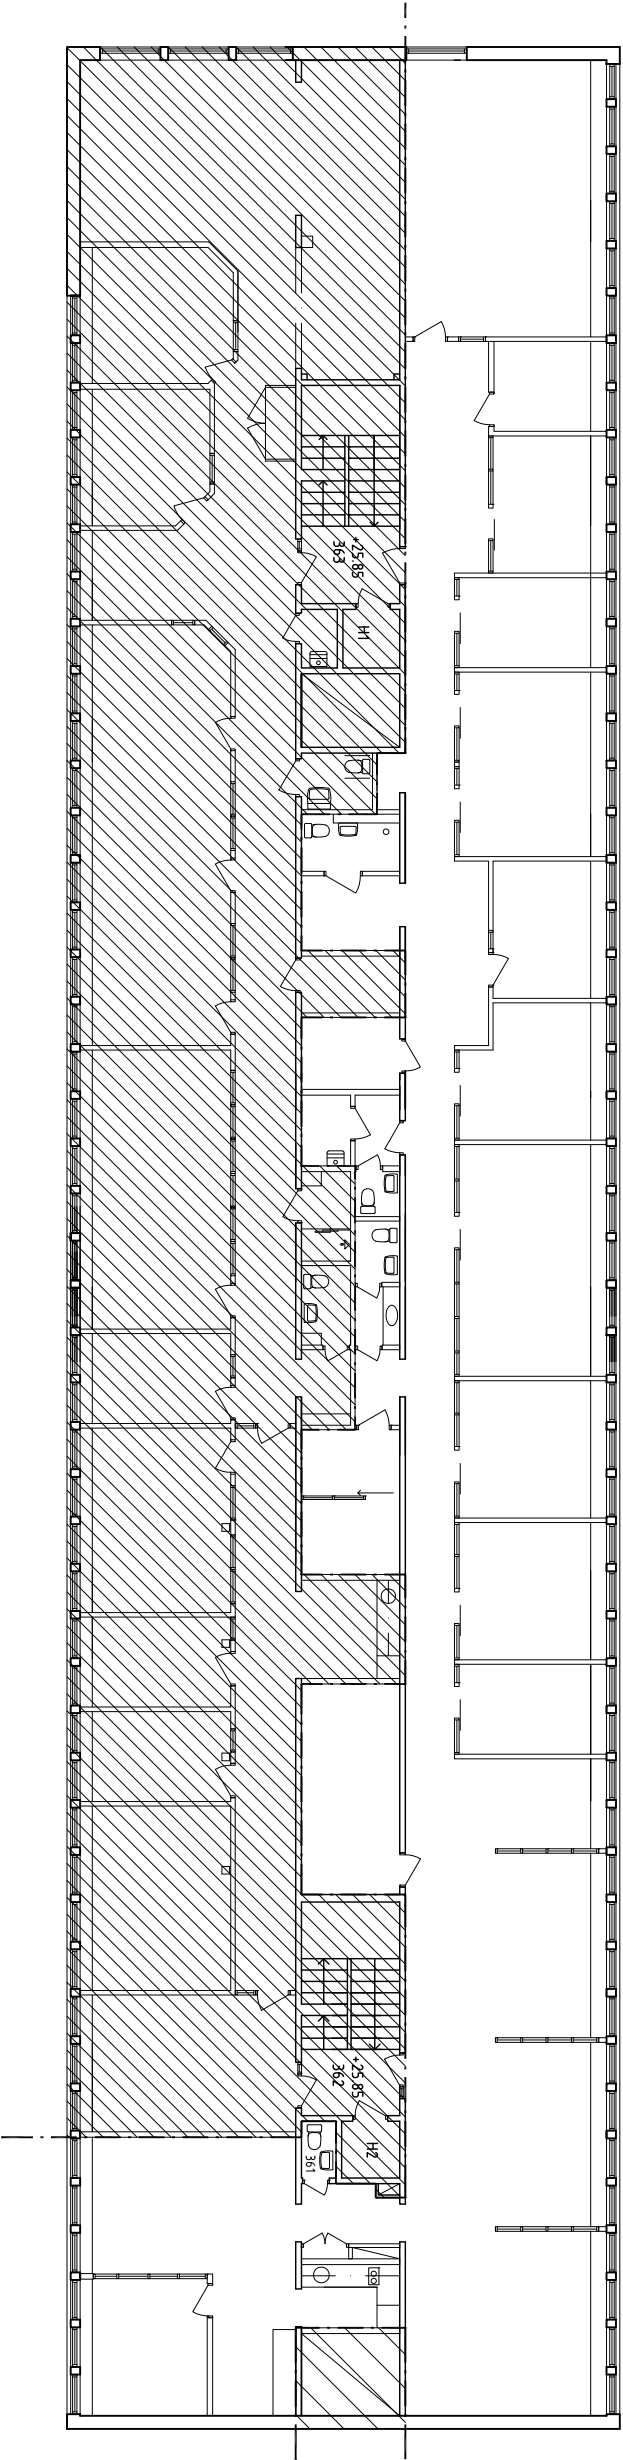