




Unit 5 - 633 kvm

METER

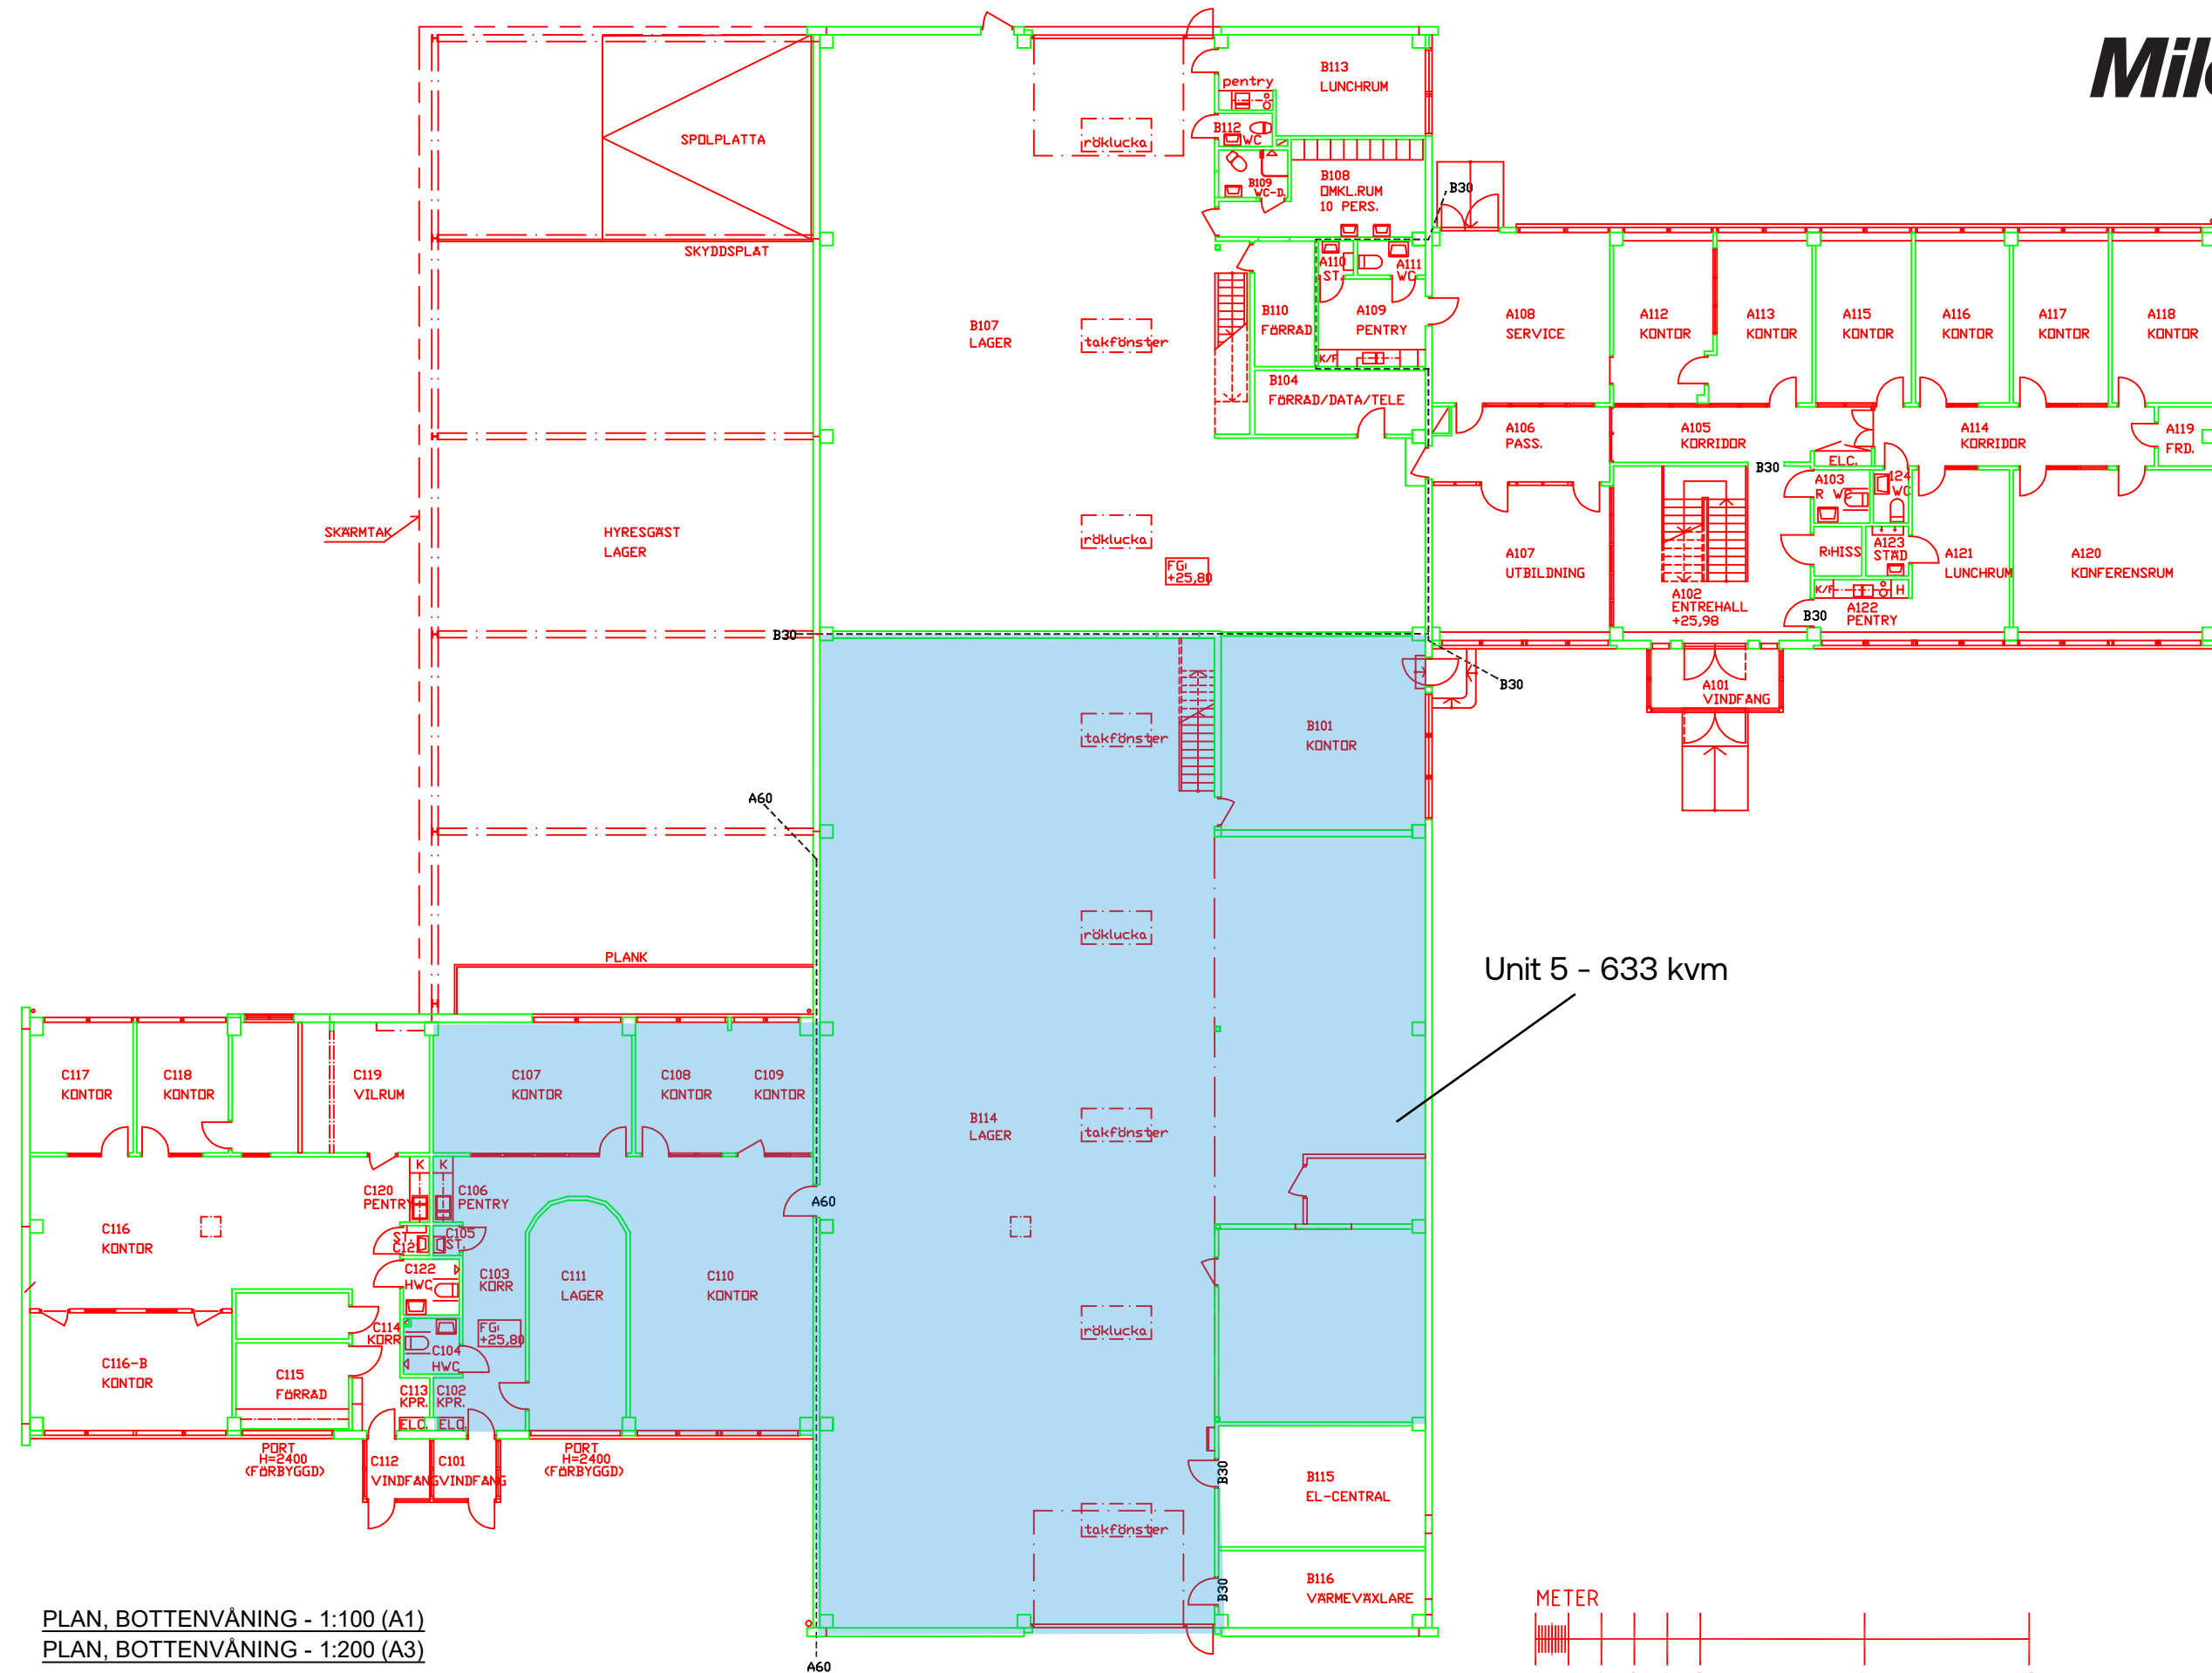

FORMAT A1: SKALA 1:100
FORMAT A3: SKALA 1:200

REF	DATE	ZACHAROV CYRUS	DATUM	NAME
RELATIONSHANDLING				
BH				
A	CASTELLINI			
K				
V				
VS				
SFPA				
E				
H				
DISPOSABLE	STUD AY	DISEL PRAISE		
ACTION	ANYTARD			
2078-04-12				
PLAN 1				
SCALE	NUMBER		NET	
1:100	A-40-P-0100			

PLAN, BOTTENVÅNING - 1:100 (A1)
PLAN, BOTTENVÅNING - 1:200 (A3)