



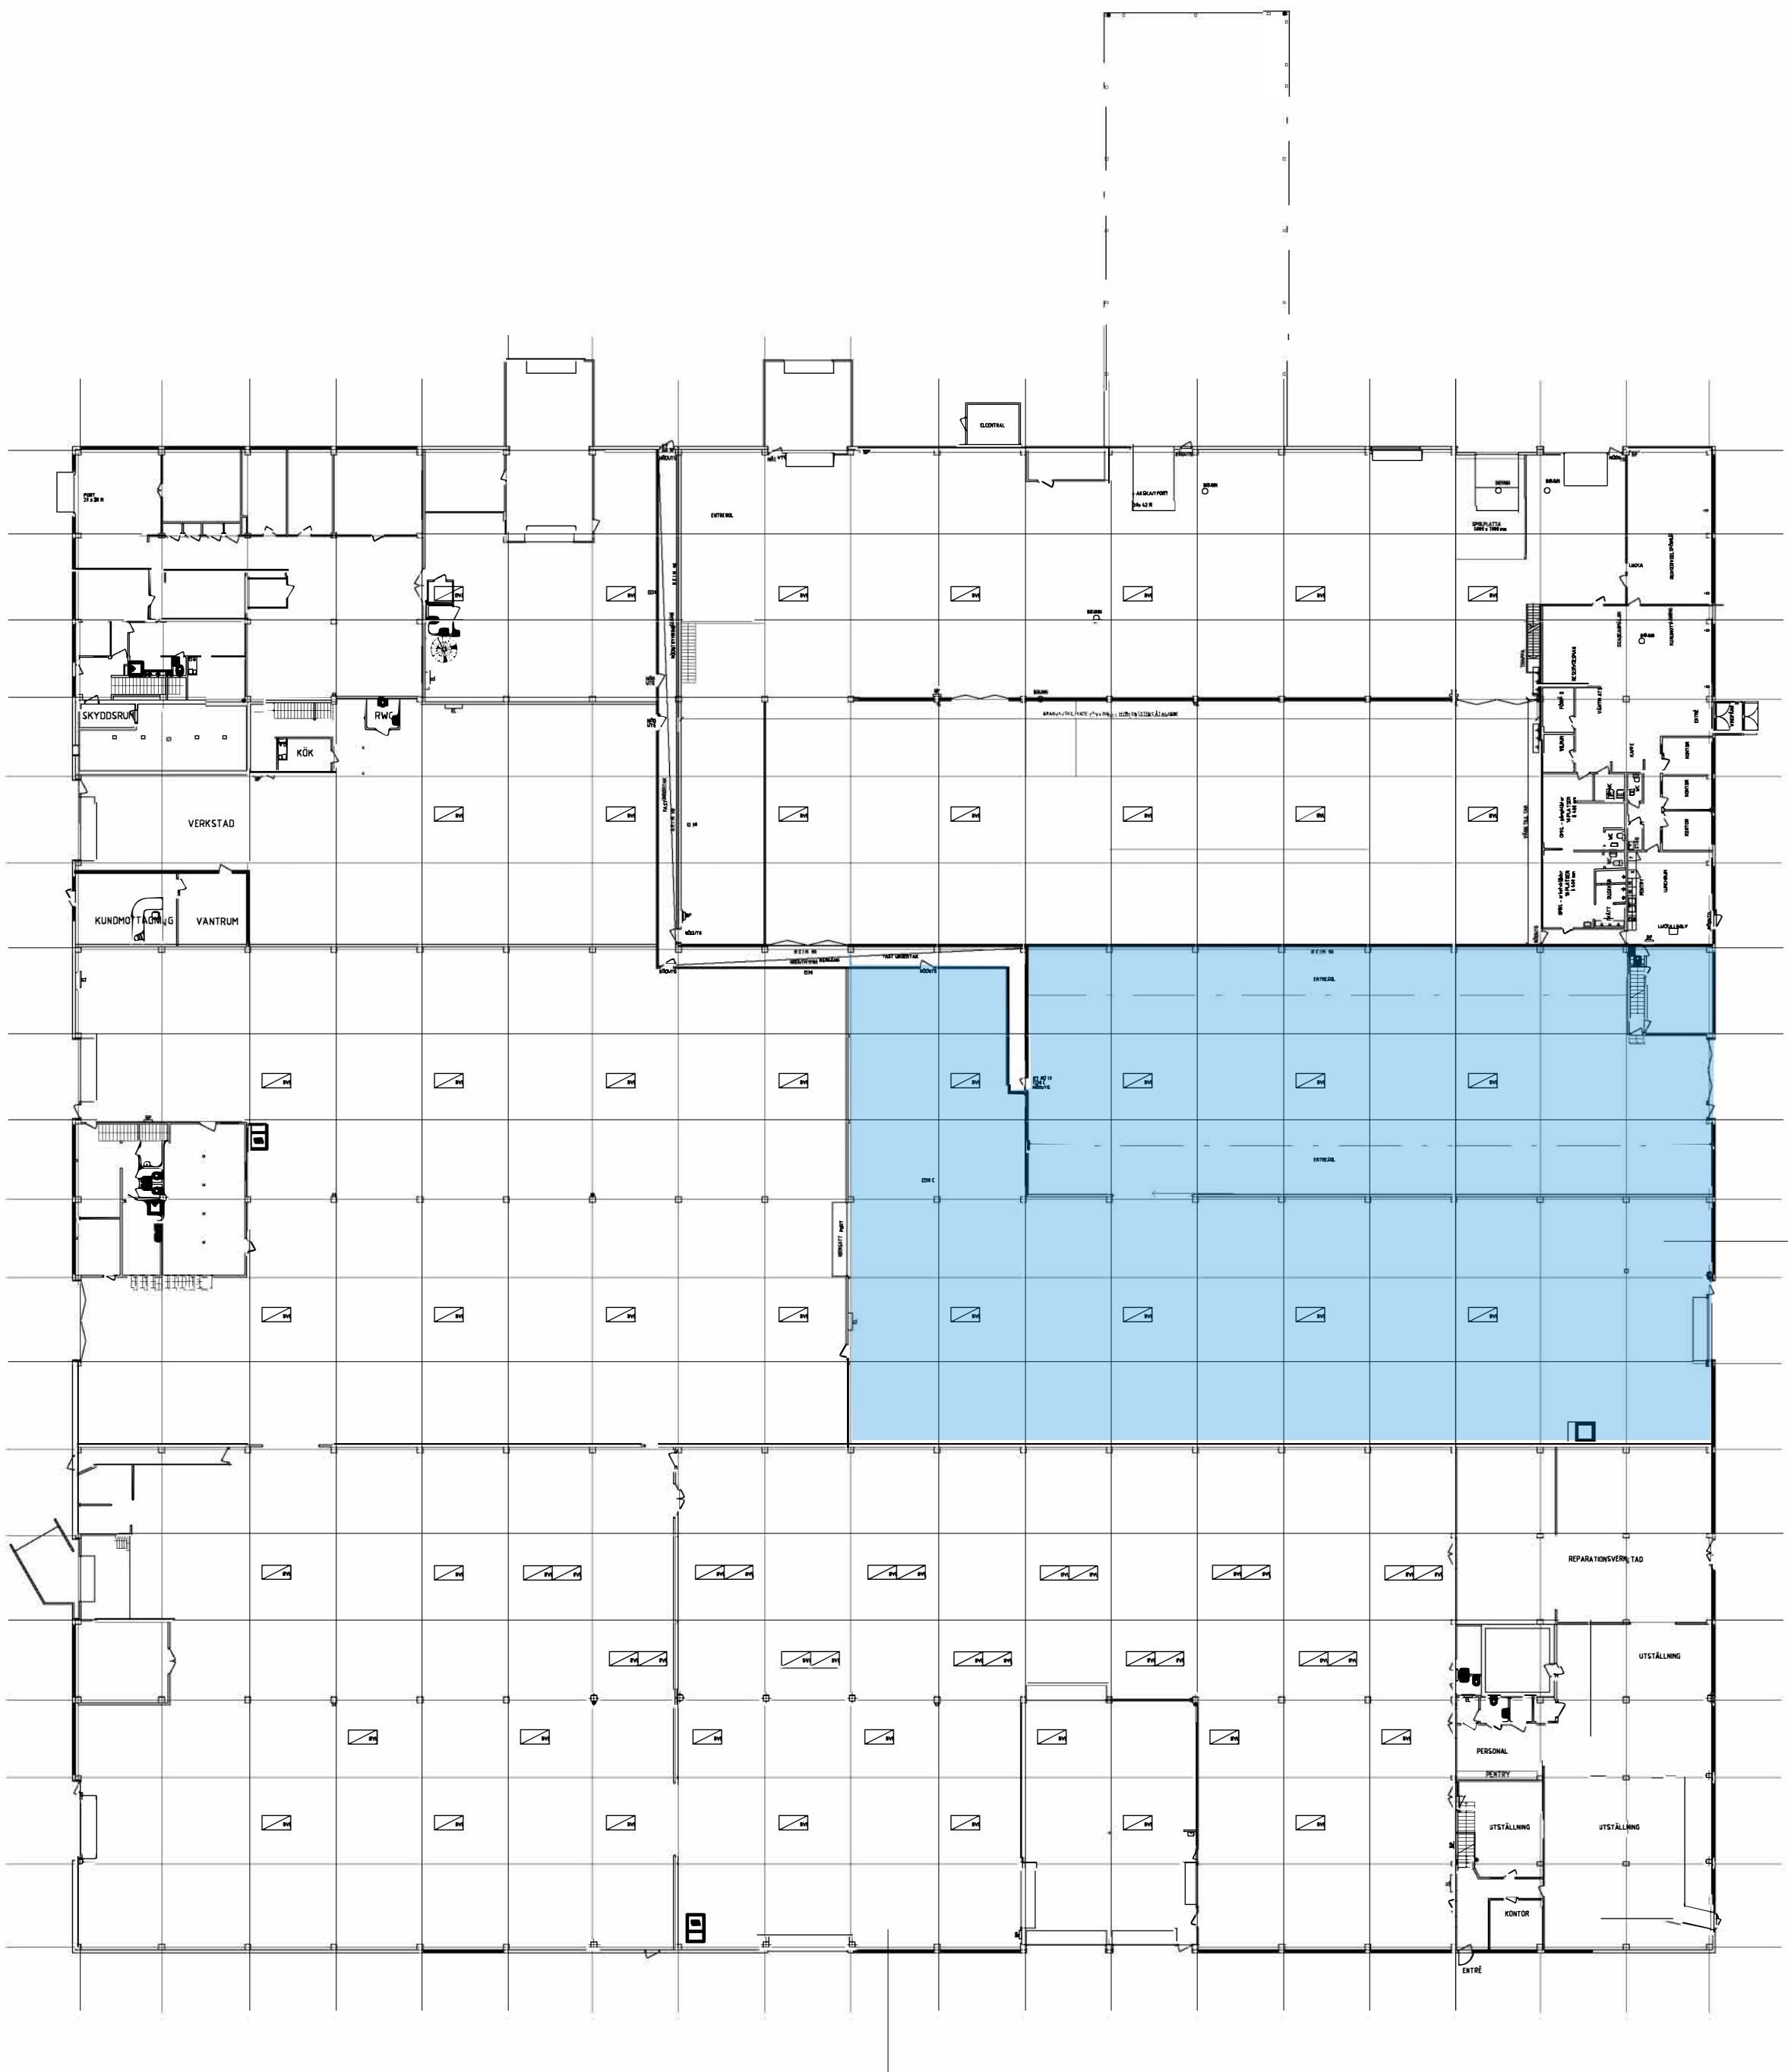


Unit 8 - 2 016 kvm

PLAN 1

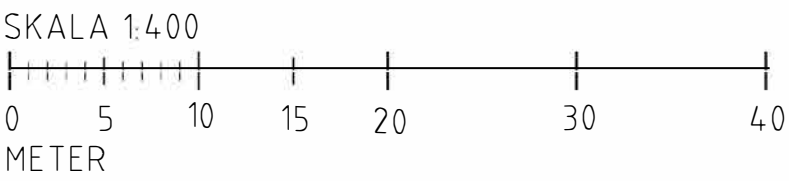


BET	ANT	ÄNDRINGEN AVSER	SIGN	DATUM
RELATIONSHANDLING				
TAGENEVÄGEN 21				
PLAN 1				
SKALA	1:400(A1)	NU	T	
	1:800(A3)			

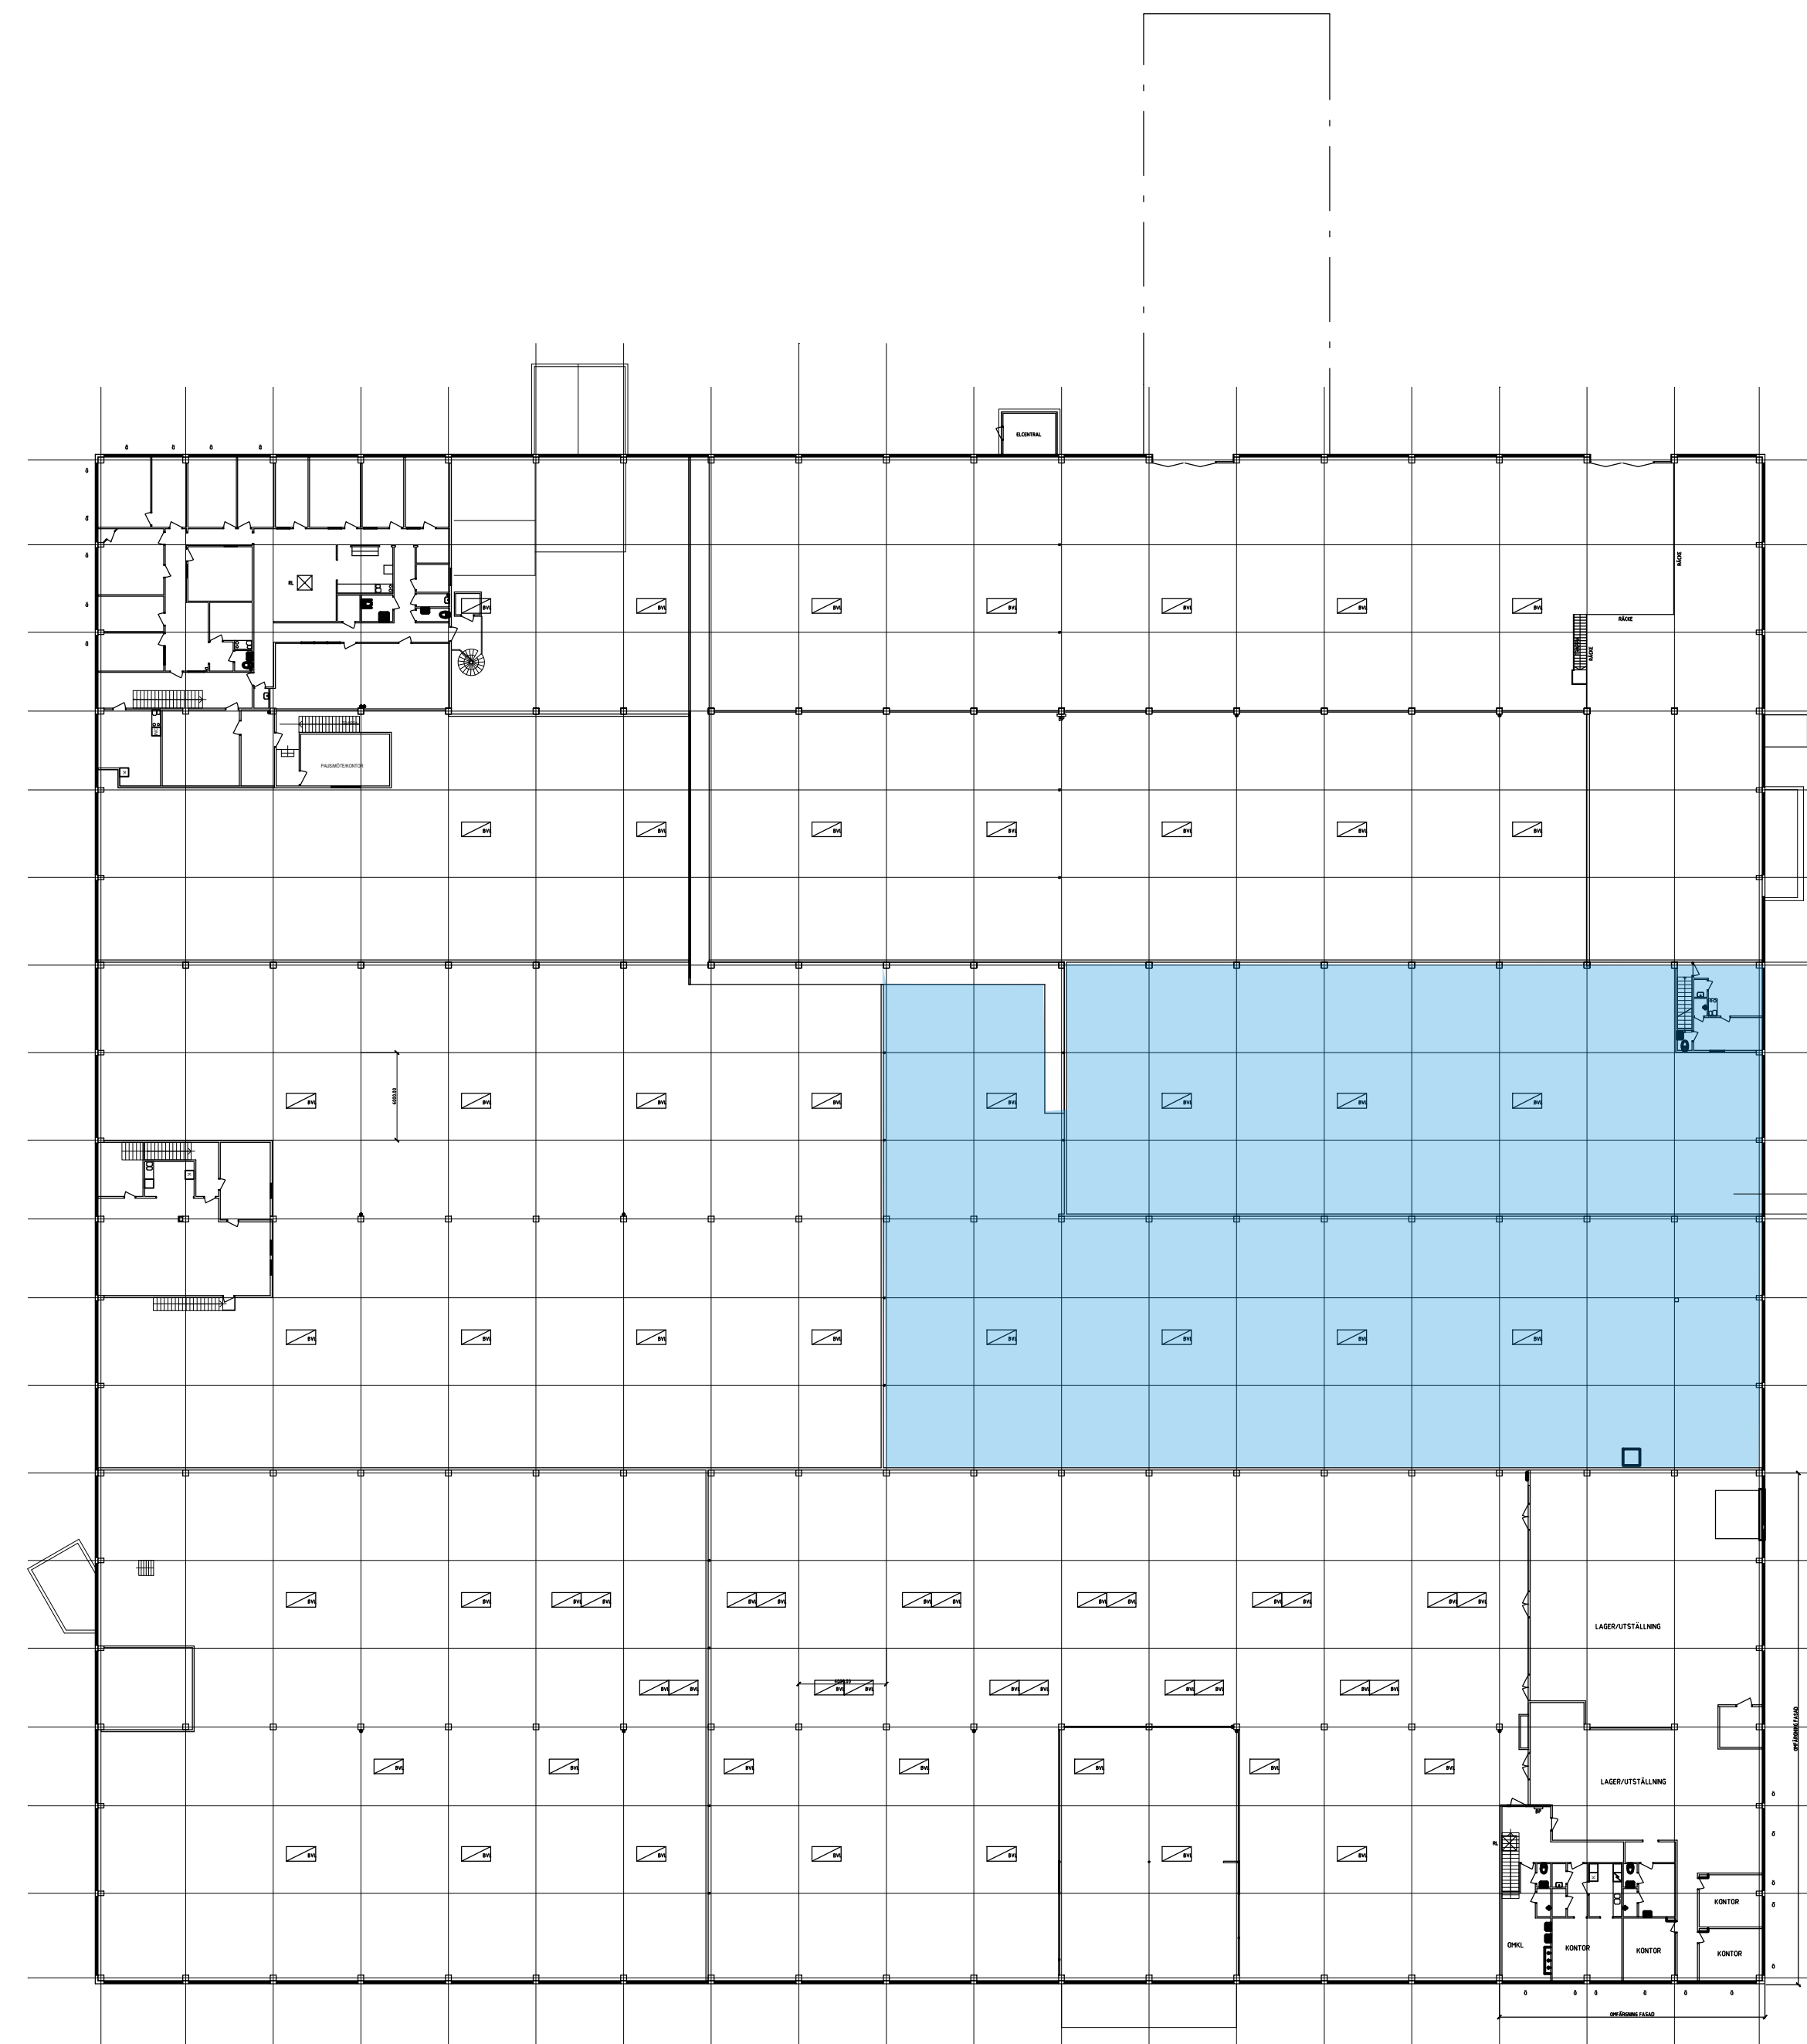

Unit 8 - 2 016 kvm

PLAN 2

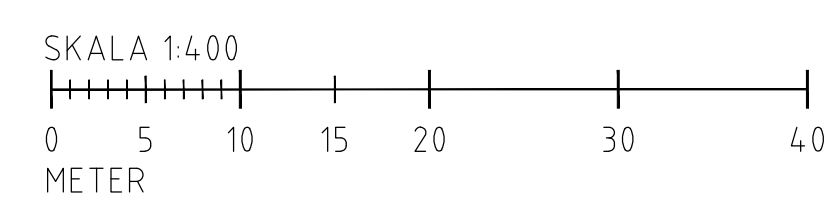

BET	ANT	ÄNDRINGEN AVSER	SIGN	DATUM
RELATIONSHANDLING				
TAGENEVÄGEN 21				
KÄRRA 37:4, GÖTEBORG				
PLAN 2				
SKALA	1:400(A1)	NU		
	1:800(A3)			