


Unit 12 + 14 - 2 036 kvm

SKALA 1:400

0 5 10 15 20 30 40
METER

BET	ANT	ÄNDRINGEN AVSEER	SIGN	DATUM
RELATIONSHANDLING				
TAGENEVÄGEN 21				
PLAN 1				
SKALA	1:400(A1) 1:800(A3)		NU	T

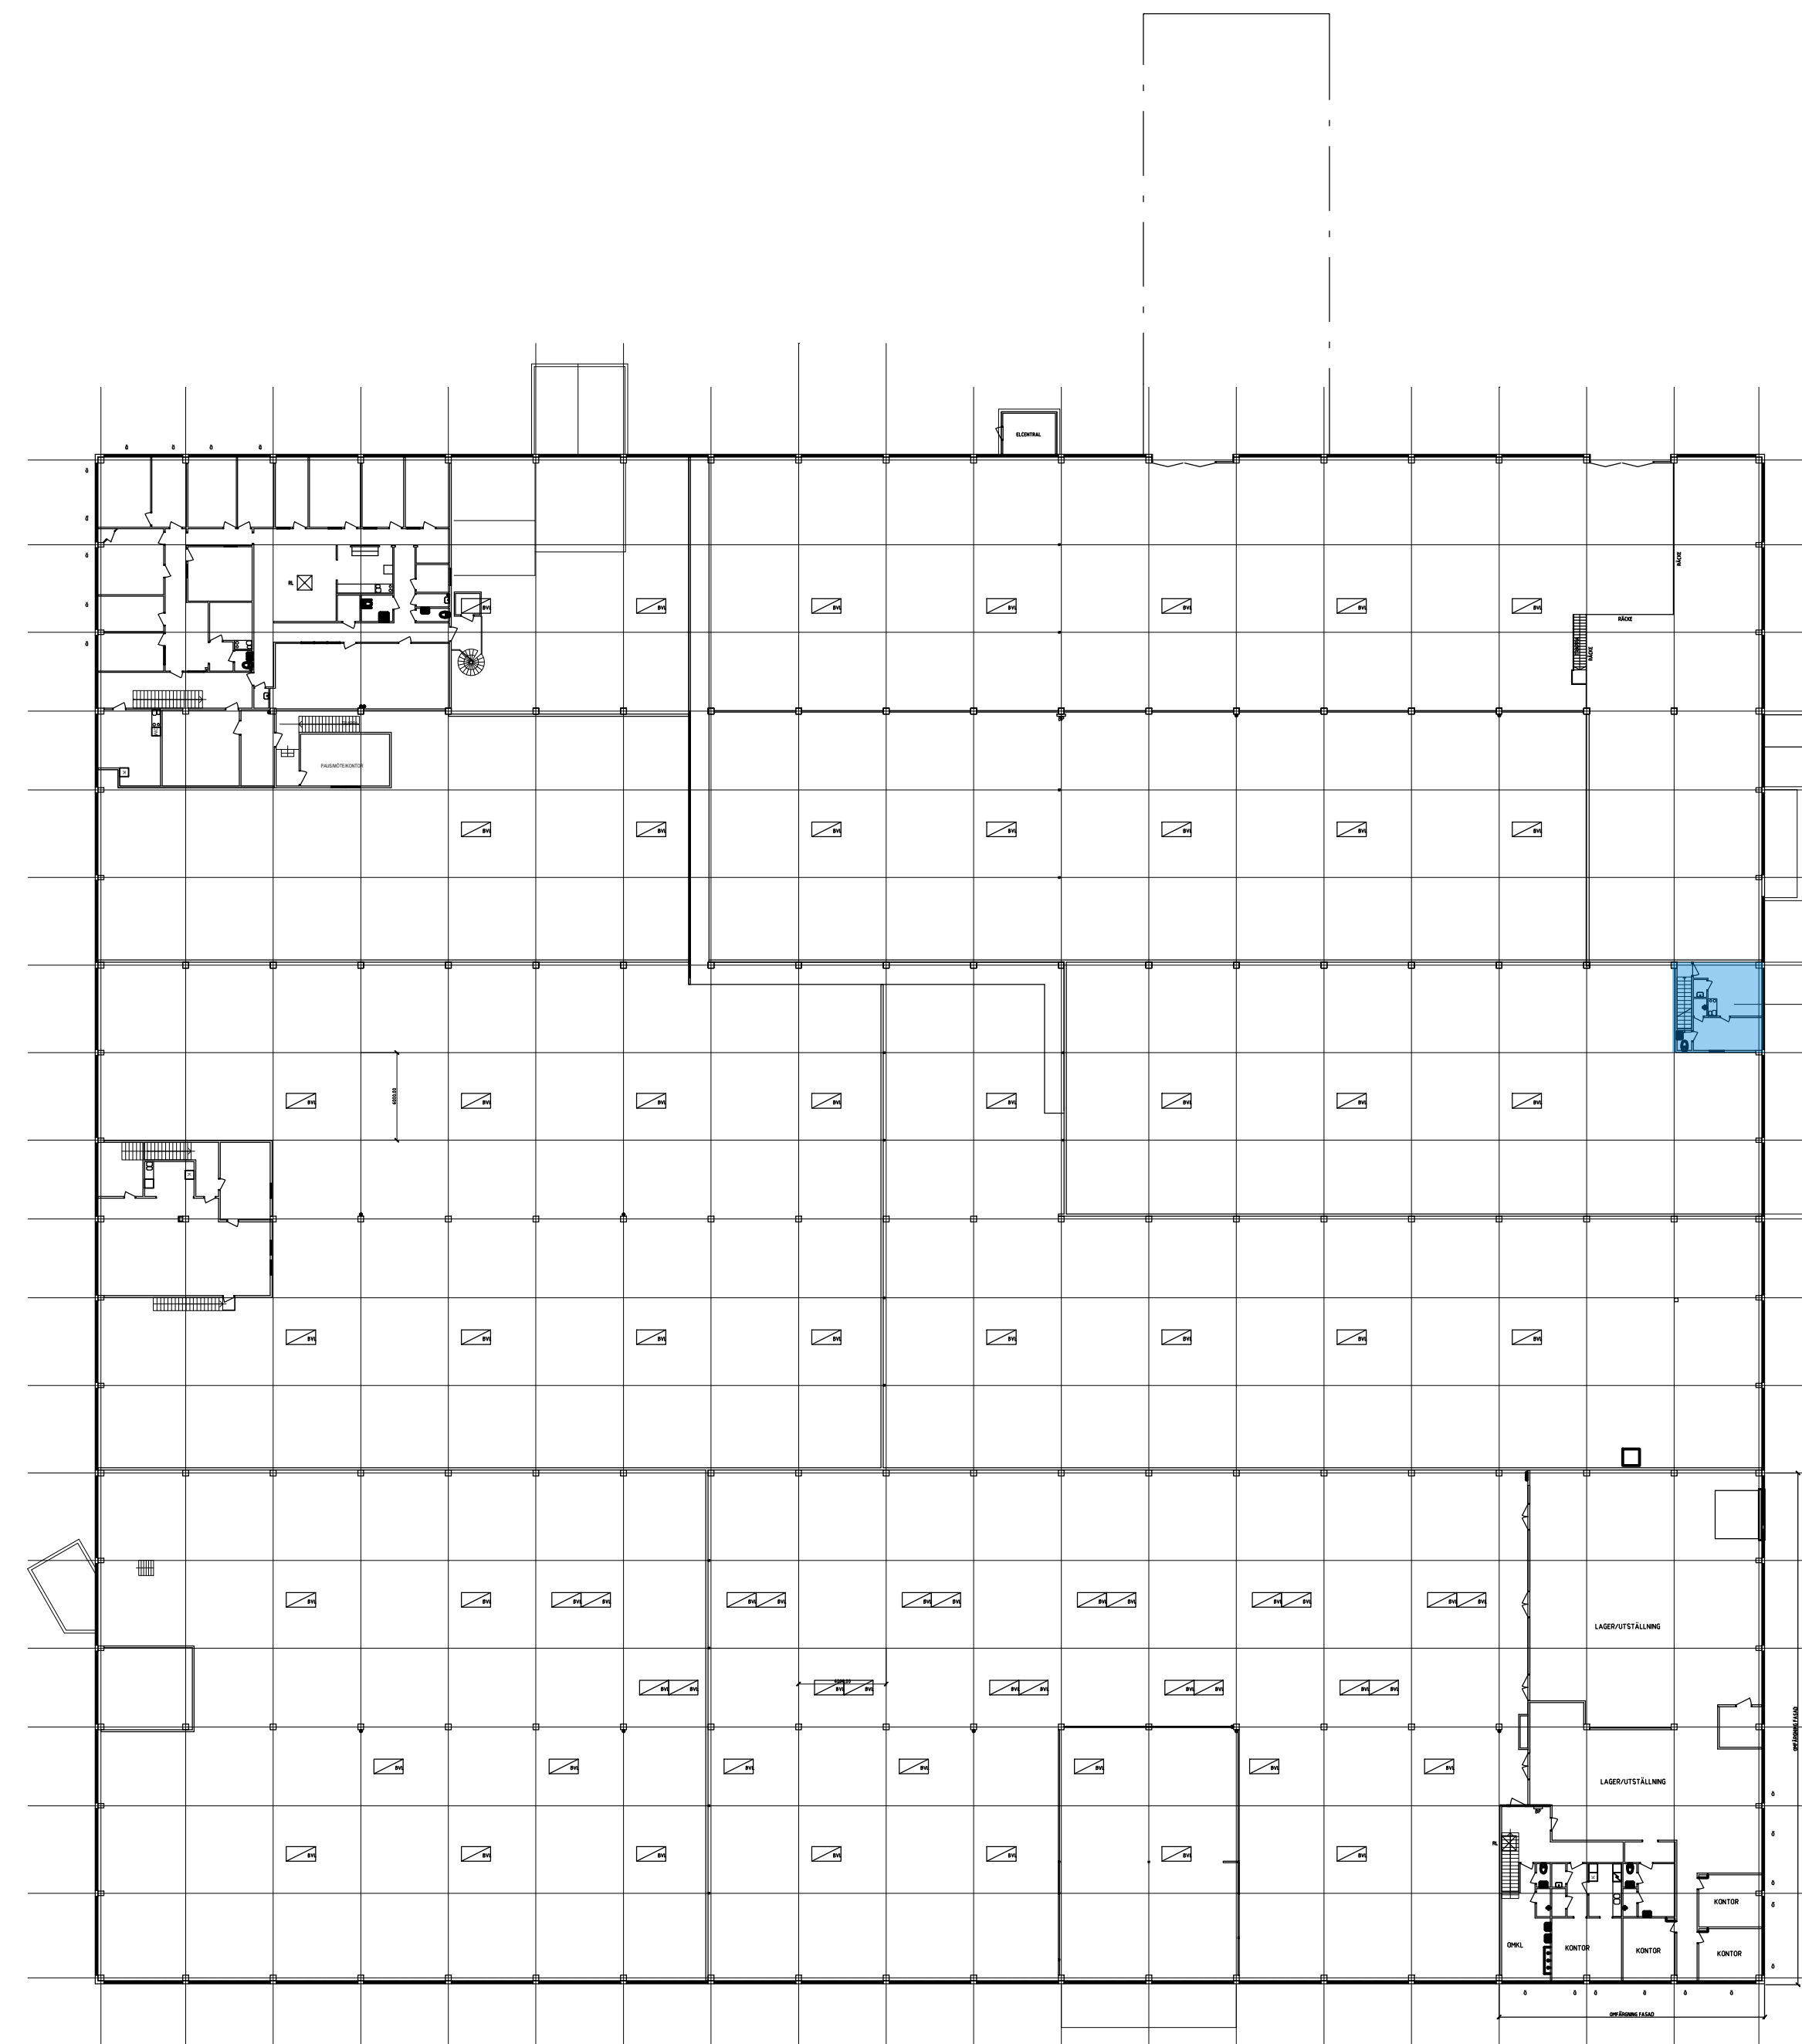

Unit 8 - 2 016 kvm

PLAN 2

SKALA 1:400
0 5 10 15 20 30 40
METER

BET	ANT	ÄNDRINGEN AVSER	SIGN	DATUM
RELATIONSHANDLING				
TAGENEVÄGEN 21				
KÄRRA 37:4, GÖTEBORG				
PLAN 2				
SKALA	1:400(A1)	NU		
	1:800(A3)			