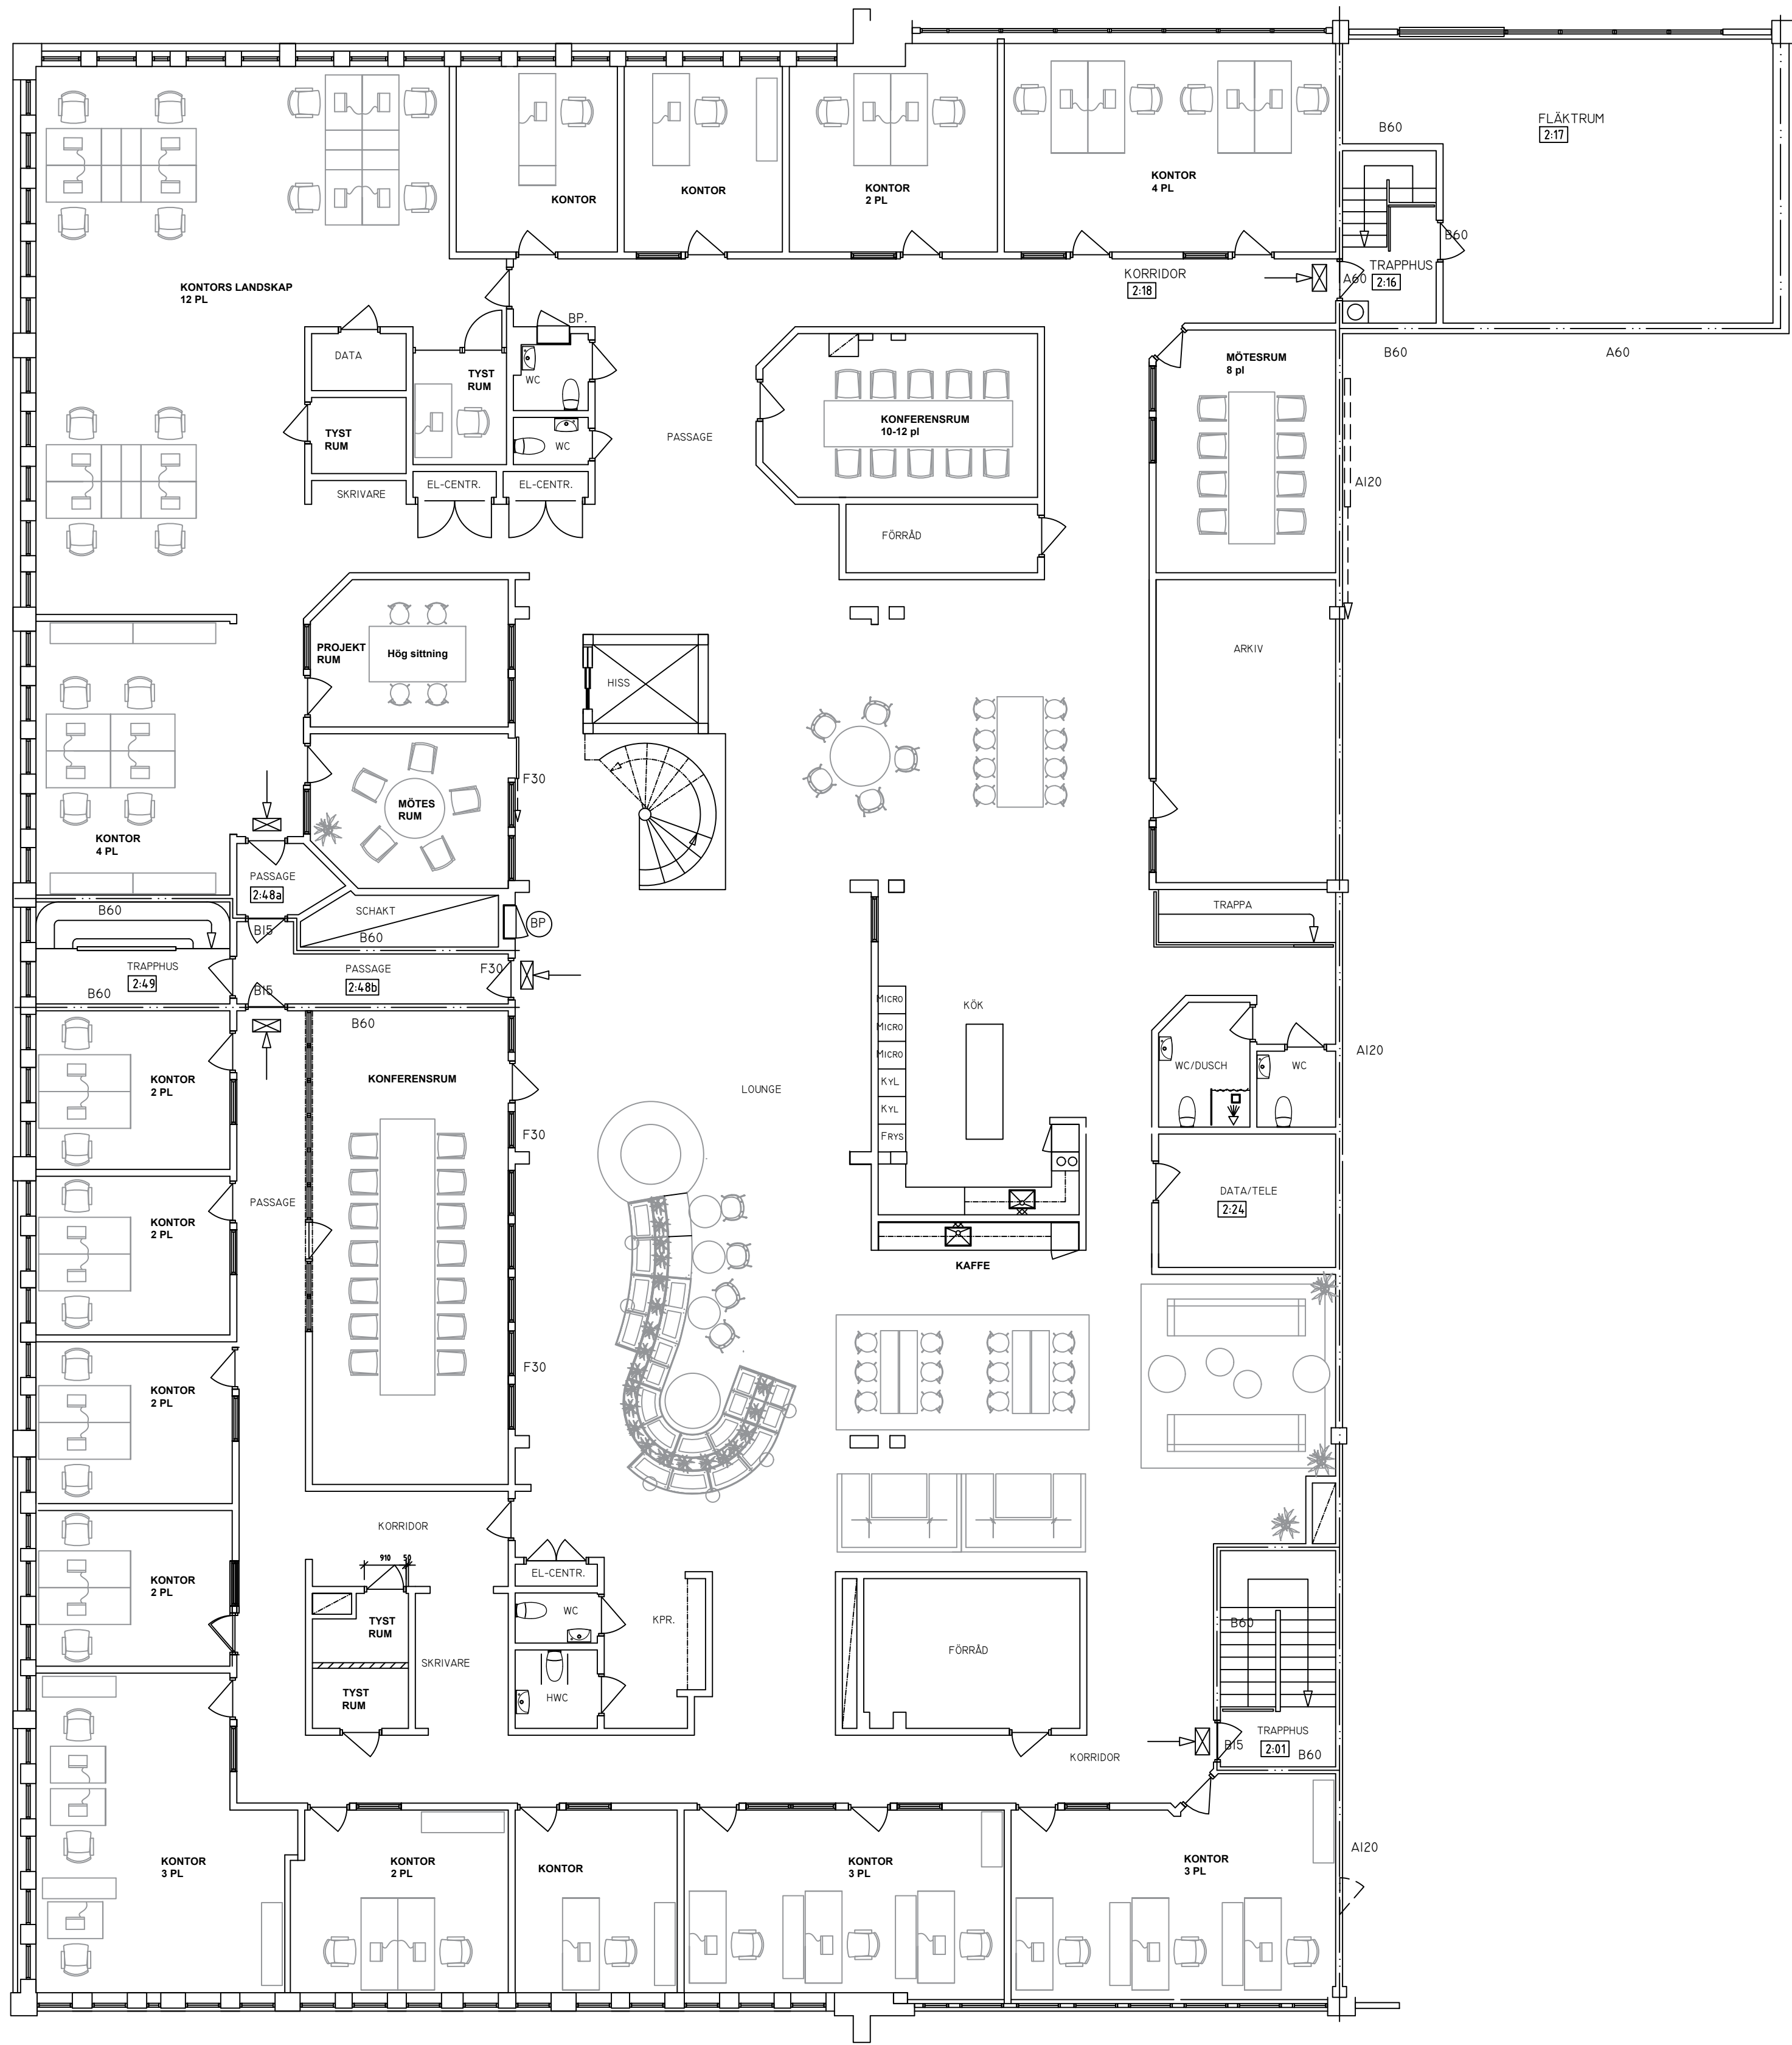


REV	ANT	REVIDERINGEN AVSER		DATUM	SIGN
RELATIONSHANDLING					
Joy Of Plenty AB					
I	Joy Of Plenty AB		TEL. 033-141001		
UPPDRAK NR		RITAD/KONSTR AV			
DATUM		ANSVARIG			
2024-02-07		ÖW			
Ramirent Göteborg					
RELATIONSRTNING					
PLAN 2					
SKALA		NUMMER		REV	
1:100 (A1)		R305-02			
1:200 (A3)					