


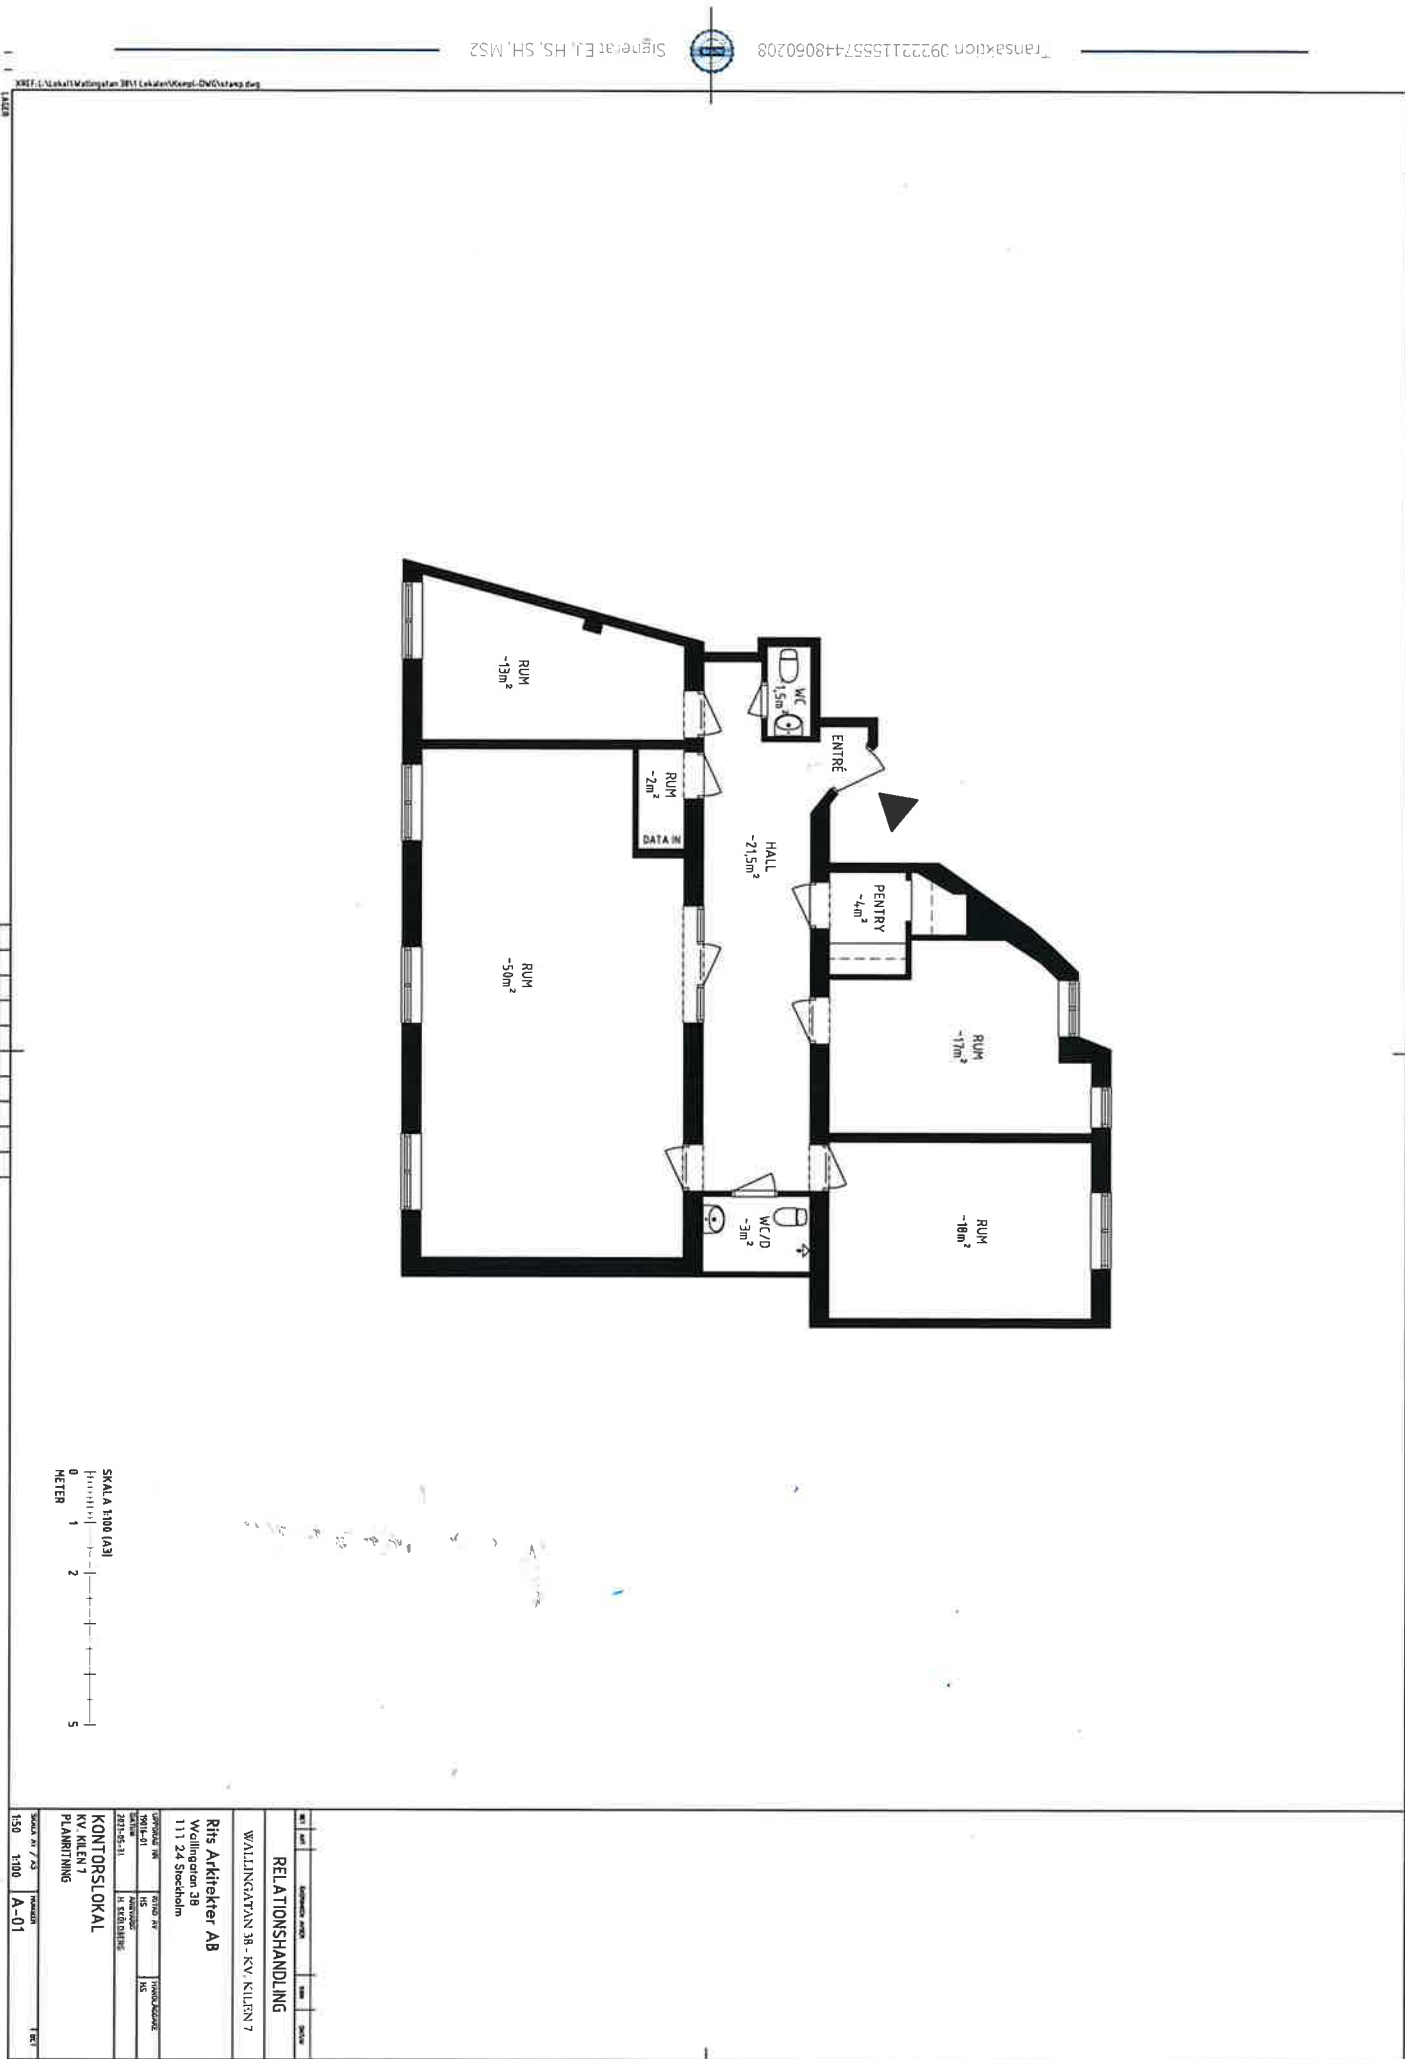

NO	ART	BESKRIVNING	REMARK	STATUS
RELATIONSHANDLING				
WALLINGATAN 3B - KV. KILLEN 7				
Rits Arkitekt AB				
Wallingatan 3B				
111 24 Stockholm				
UPPLAG 01	DATE 2021-05-31	PROJECT 111 24	PROJECT 111 24	PROJECT 111 24
DATE 2021-05-31	DATE 2021-05-31	DATE 2021-05-31	DATE 2021-05-31	DATE 2021-05-31
KONTORSLOKAL				
KV. KILLEN 7				
PLANERING				
SCALE 1:100	SCALE 1:100	SCALE 1:100	SCALE 1:100	SCALE 1:100
1:100	1:100	1:100	1:100	1:100
A-01				