


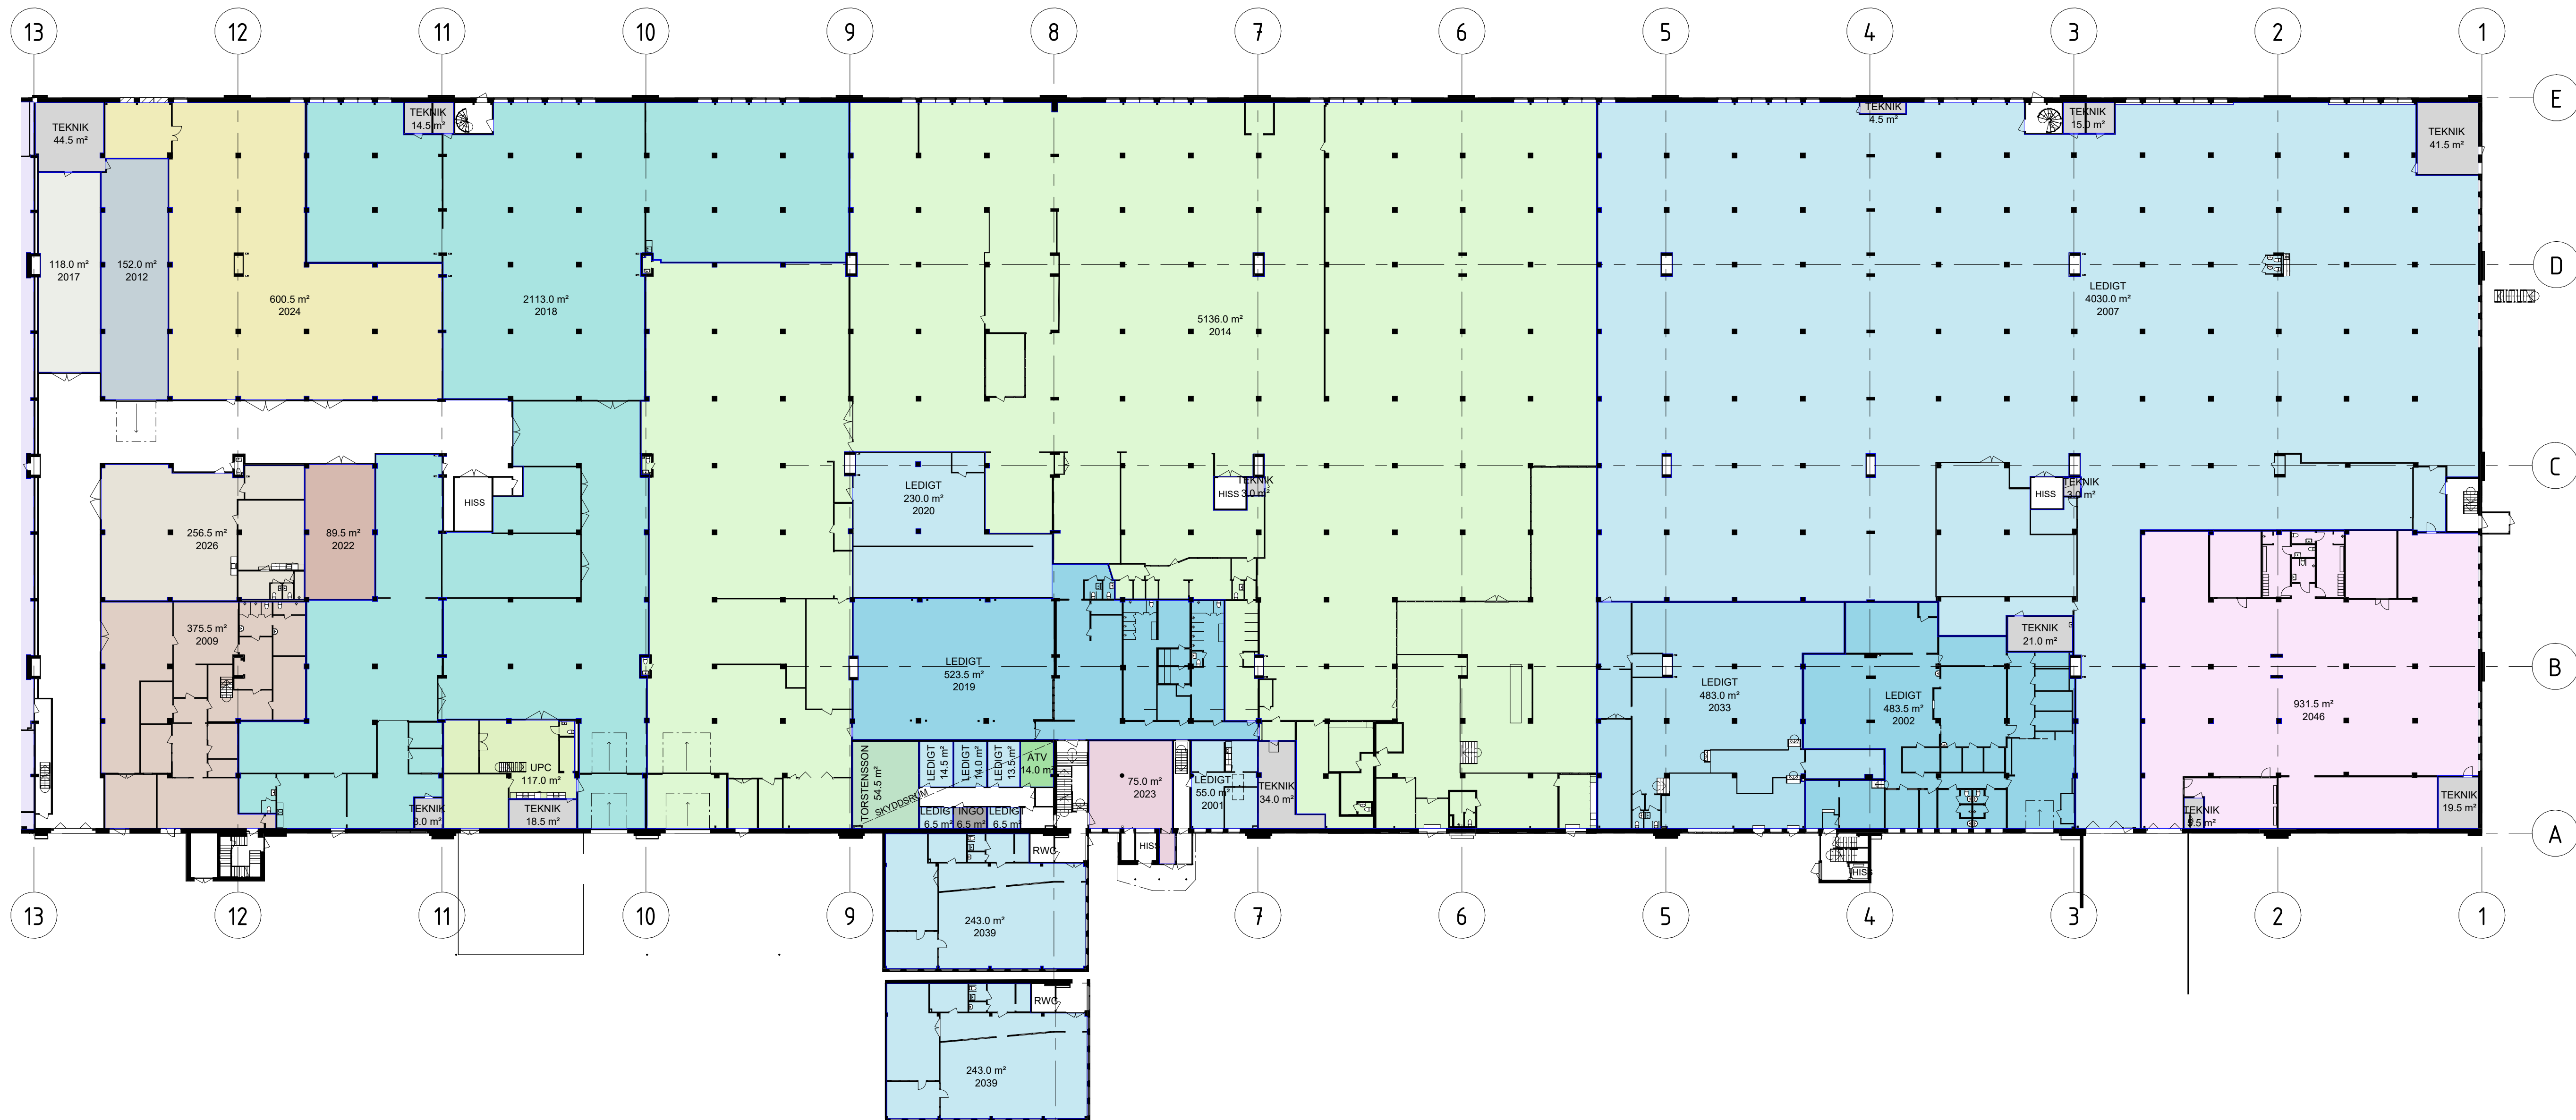

LOA, PLAN 1

OBJEKTNUMMER	ANMÄRKNINGAR	AREA	
	TORSTENSSON	54.5 m²	
	ATV	14.0 m²	
	LEDIGT	13.5 m²	
	LEDIGT	14.0 m²	
	LEDIGT	14.5 m²	
	INGO	6.5 m²	
	LEDIGT	6.5 m²	
	LEDIGT	6.5 m²	
2001	LEDIGT	55.0 m²	
2002	LEDIGT	483.5 m²	
2004	LEDIGT	4190.0 m²	
2007	LEDIGT	4030.0 m²	
2009	ELINO	375.5 m²	(353)
2012	ER BYGG	152.0 m²	
2014	GRANIT & MARMOR	5136.0 m²	(3771)
2017	LOGIDE	118.0 m²	(108)
2018	MOTION & FITNESS	2113.0 m²	
2019	LEDIGT	523.5 m²	(400)
2020	LEDIGT	230.0 m²	
2022	RELINO	89.5 m²	
2023	R DESIGN	75.0 m²	(70)
2024	SCANDMETAL	600.5 m²	(578)
2026	TANKEREDS BYGGSERVICE	256.5 m²	(2016)
2030	UPC	117.0 m²	(106)
2033	LEDIGT	483.0 m²	
2039	LEDIGT	243.0 m²	
2046	MEKONOMEN	931.5 m²	
2051	WERKSTA	2825.5 m²	
TOTALT		23157.0 m²	

BTA TOTALT

Plan 10	24920.5 m²
Plan 11	17646.0 m²
Plan 12	1760.5 m²
TOTALT	44327.0 m²

2024-06-12

BET	ANT	ÄNDRINGEN AVSER	DATUM	SIGN
RELATIONSHANDLING				
Regulatorn 4				
Regulatorn 4, Norrköpings Kommun				
PL	-	-	-	-
A	Arqly Sverige AB	-	010-516 26 00	-
K	-	-	-	-
VVS	-	-	-	-
E	-	-	-	-
M	-	-	-	-
UPPDRAG NR	A220464	RITAD/KONSTR AV	JL/SA	HAN
DATUM	2022-10-06	ANSVARIG	HAn	-
BEFINTLIGT				
PLAN 1, DEL 2				
SKALA	A1 1:350	NUMMER	A-40-1-102	BET
	A3 1:700			

ARQLY

