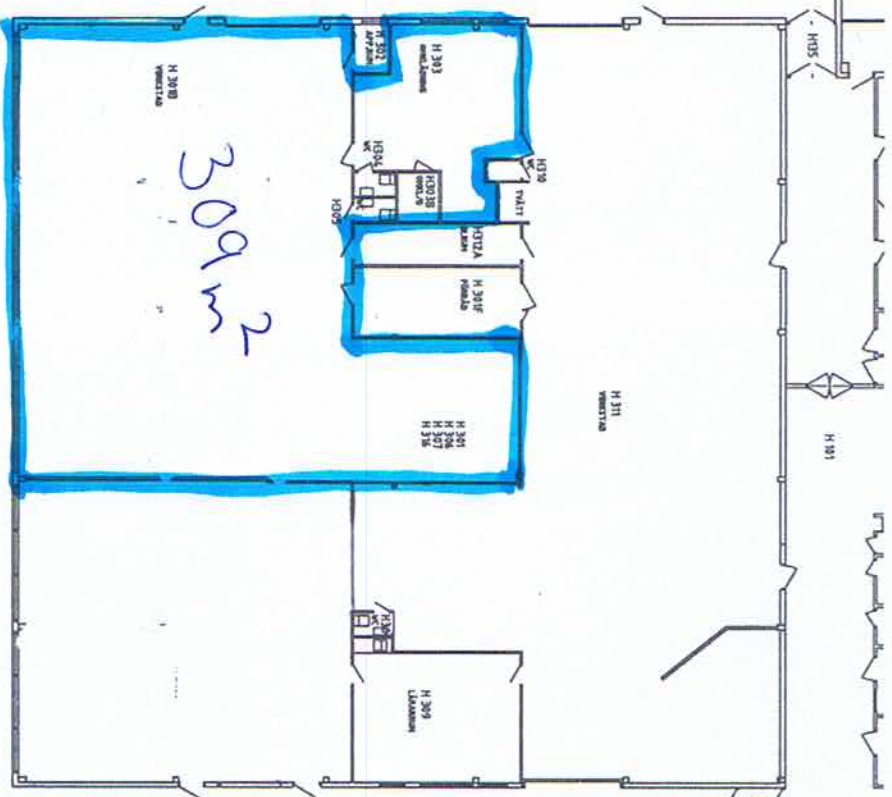


RELATIONSHANDLING	
TUVEJYCKAN	
RONNEBY KOMMUN	
BONNERY UTVEJNINGSCENTRUM	
FOGELBERG	
GILLESBERG	
2008.03.24	
RELATIONSHANDLING	
OFF-SCHEMATIC	
PLAN 1. HUSOR 1H	
1980 / 1285	
A 00:70:19	