


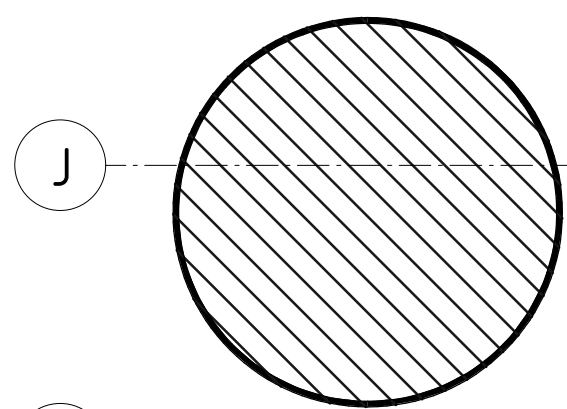

J

K

L

M

N

O

P


Q

R

S

Konnektionslinje

ENTRESOL
5690,9 m²

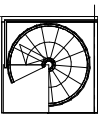

E130

E130

Plan 2
1 : 200

1

2

3

4

5

6

7

8

9

10

11

12

13

7500

15000

7500

7500

90400

Sektion A-A
A-40-2-101

Konnektionslinje

A

B

RELATIONSHANDLING



Logistikhall KION
Del av Stödorp 2:1

A YLAB tel. 036-800 87

UPPDRAG NR 186 RITAD/KONSTR. AV AG HANDLÄGGARE OG

DATUM 2023-10-30 ANSVÄRIG OH

Nybyggnation
Delplan 2 B

SKALA A1 1:200 A3 1:400 NUMMER A-40-1-211 BET

SKALA 1:200

0 1 2 5 10 15 20
METER

