

AREA VOLYM
BTA 1433,4 m³
BTJ 4928,2 m³


ANTAL GÅVARETARER TOTALT: 13 ST

LOKALISERING

PLANERINGSSKEDUL NLE

UNDERVISNING

INDEL EJ I BEHÖRIGHET

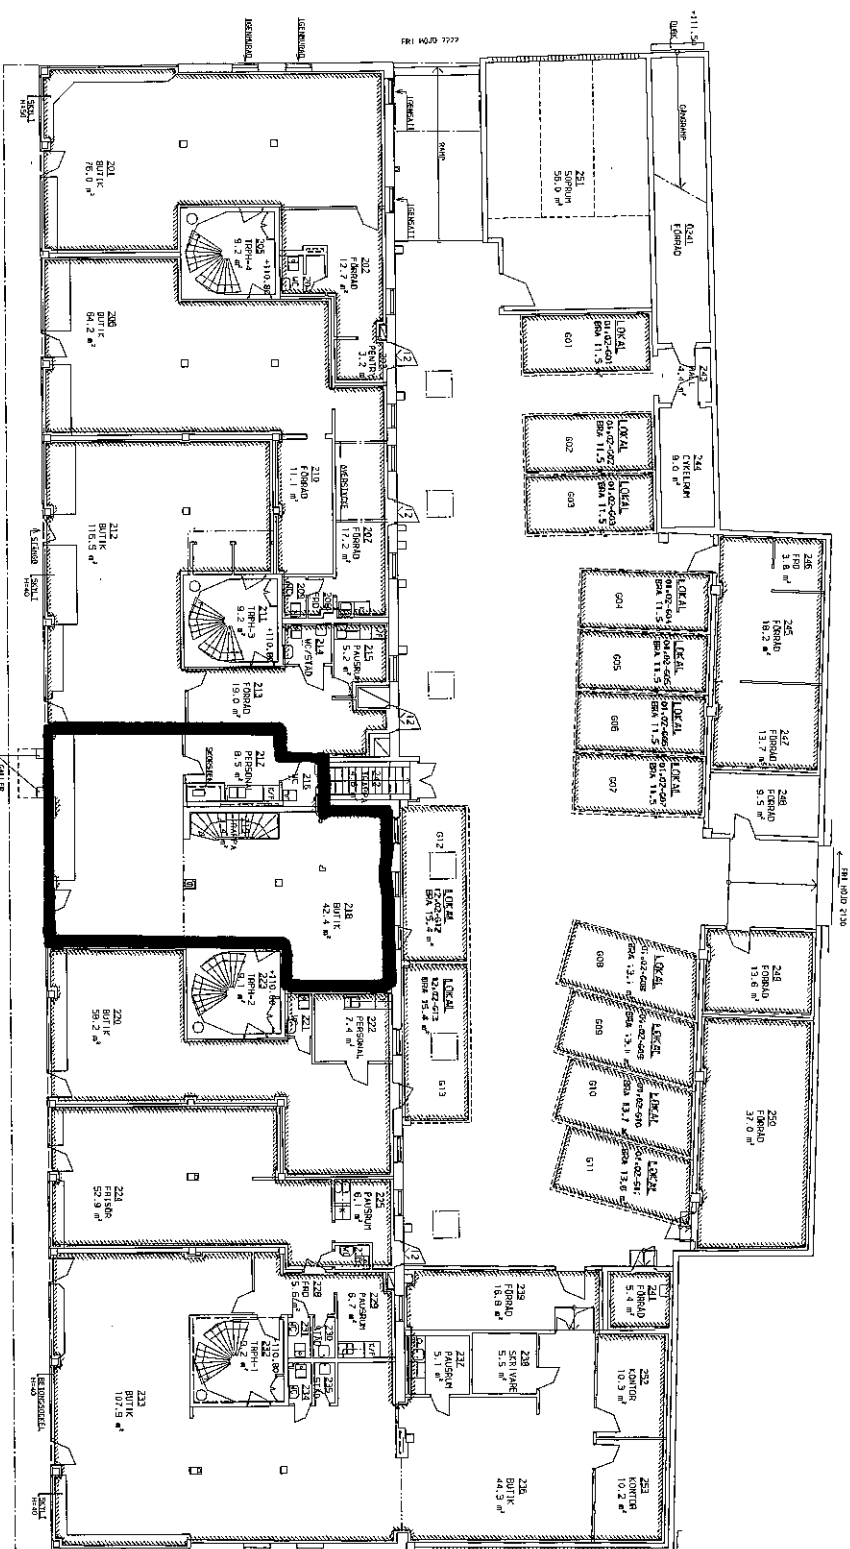

LOKAL
01-02-07
BRA 36,3 m²

LOKAL
01-02-08
BRA 13,6 m²

LOKAL
01-02-09
BRA 37,0 m²

LOKAL
01-02-10
BRA 5,4 m²

LOKAL
01-02-01
BRA 95,8 m²

LOKAL
01-02-02
BRA 96,9 m²

LOKAL
01-02-11
BRA 203,8 m²

LOKAL
01-02-12
BRA 67,6 m²

LOKAL
01-02-04
BRA 90,8 m²

LOKAL
01-02-05
BRA 225,6 m²


0 1 2 3 4 5
10 Meter




REF	ART	BESTÄMMELSE	AREAL	STORLEK
1	LOKAL	LOKAL 01-02-01	95,8	150
2	LOKAL	LOKAL 01-02-02	96,9	150
3	LOKAL	LOKAL 01-02-04	90,8	150
4	LOKAL	LOKAL 01-02-05	225,6	150
5	LOKAL	LOKAL 01-02-11	203,8	150
6	LOKAL	LOKAL 01-02-12	67,6	150
7	LOKAL	LOKAL 01-02-07	36,3	150
8	LOKAL	LOKAL 01-02-08	13,6	150
9	LOKAL	LOKAL 01-02-09	37,0	150
10	LOKAL	LOKAL 01-02-10	5,4	150

RELATIONSHANDLING

MÄSTÄJAREN FASTIGHETER AB
Box 1005, 701 10 Falun
VIA ARCHITECTURE AB

SPARBANKEN 6, FALUN
HUS 01
PLAN 02 (BY) -118,80
PLANERING LAGERHETTER
SKALA 1:100
A-48-11-01-021

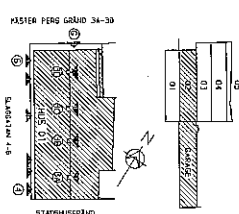

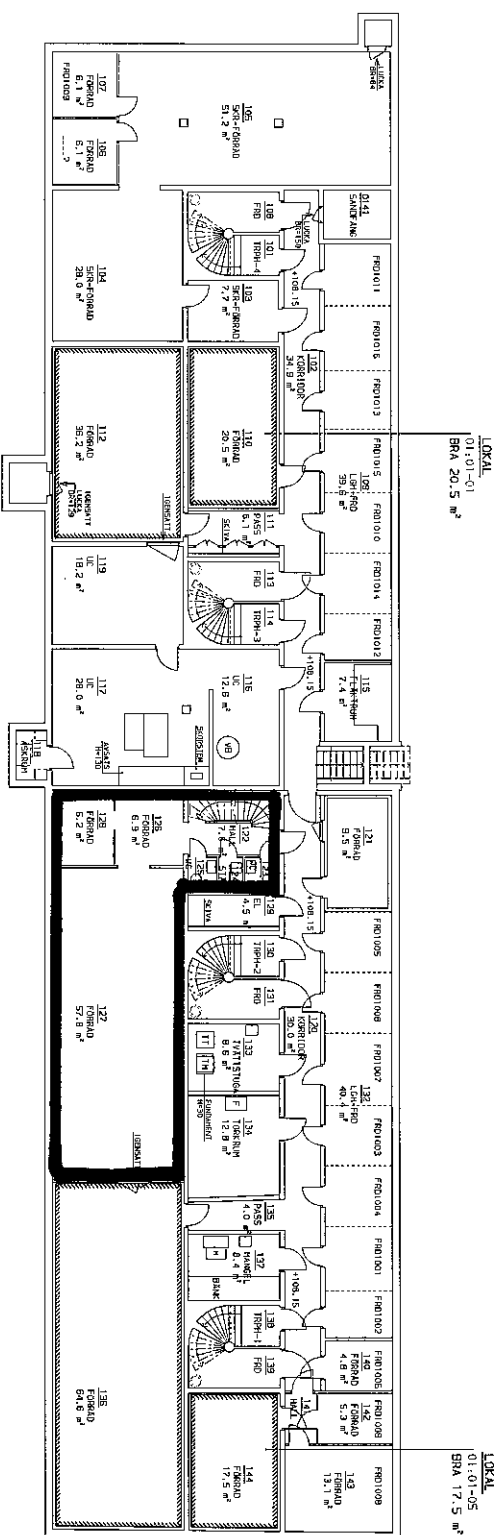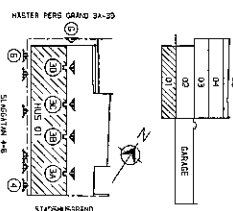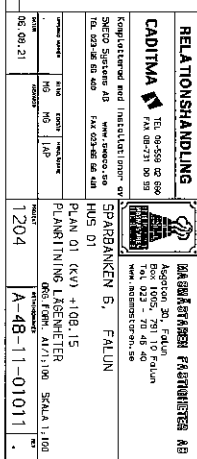

AREÅ, VOLYM
BTA 740.3 m²
BTV 1983.1 m³

FÖRKLARINGAR

----- RINNEBÄCKENINÖS INJAB
===== LÄGNETSERÄRIS
..... INJAB ELLI BRUKSÄREAN