


sign.	sign.
-------	-------



№	Имя	Фамилия	Инициалы	Дата
1	Иванов	Иван	И.И.	01.01.2020
2	Петров	Петр	П.П.	02.02.2020
3	Сидоров	Сидор	С.С.	03.03.2020
4	Смирнов	Смирнов	С.С.	04.04.2020
5	Климов	Климов	К.К.	05.05.2020
6	Куликов	Куликов	К.К.	06.06.2020
7	Левин	Левин	Л.Л.	07.07.2020
8	Морозов	Морозов	М.М.	08.08.2020
9	Мухоморов	Мухоморов	М.М.	09.09.2020
10	Новиков	Новиков	Н.Н.	10.10.2020
11	Попов	Попов	П.П.	11.11.2020
12	Рябинин	Рябинин	Р.Р.	12.12.2020
13	Соловьев	Соловьев	С.С.	13.01.2021
14	Тихонов	Тихонов	Т.Т.	14.02.2021
15	Федотов	Федотов	Ф.Ф.	15.03.2021
16	Харин	Харин	Х.Х.	16.04.2021
17	Цыганков	Цыганков	Ц.Ц.	17.05.2021

РЕЛАЦИОНСКОЕ	
COREM	
BACKA 2017	
COREM	
№	Имя
1	Иванов И.И.
2	Петров П.П.
3	Сидоров С.С.
4	Смирнов С.С.
5	Климов К.К.
6	Куликов К.К.
7	Левин Л.Л.
8	Морозов М.М.
9	Мухоморов М.М.
10	Новиков Н.Н.
11	Попов П.П.
12	Рябинин Р.Р.
13	Соловьев С.С.
14	Тихонов Т.Т.
15	Федотов Ф.Ф.
16	Харин Х.Х.
17	Цыганков Ц.Ц.

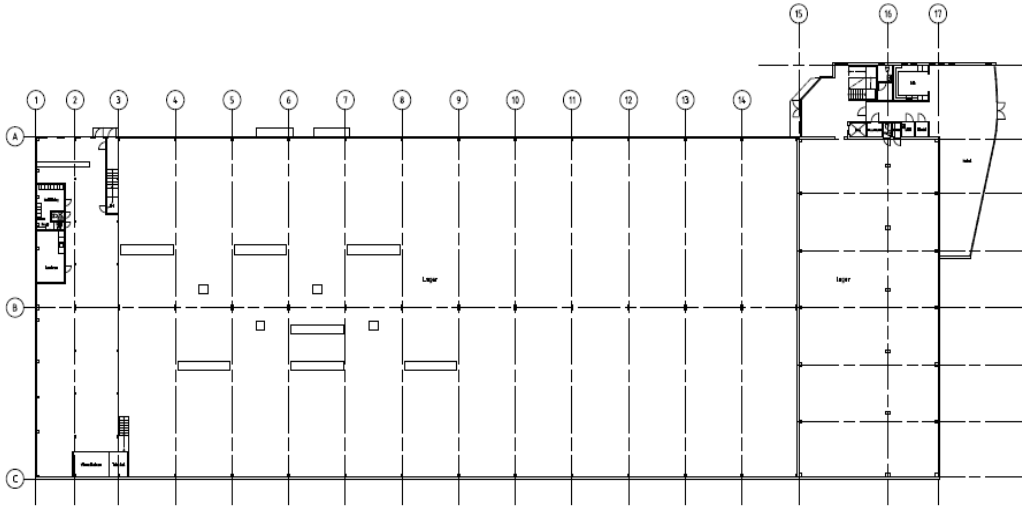
  

ИЗДАНИЕ	ИЗМЕНЕНИЯ	ИЗМЕНЕНИЯ
№	№	№
1	1	1
2	2	2
3	3	3
4	4	4
5	5	5
6	6	6
7	7	7
8	8	8
9	9	9
10	10	10
11	11	11
12	12	12
13	13	13
14	14	14
15	15	15
16	16	16
17	17	17


№	Имя	Фамилия	Инициалы	Дата
1	Иванов	Иван	И.И.	01.01.2020
2	Петров	Петр	П.П.	02.02.2020
3	Сидоров	Сидор	С.С.	03.03.2020
4	Смирнов	Смирнов	С.С.	04.04.2020
5	Климов	Климов	К.К.	05.05.2020
6	Куликов	Куликов	К.К.	06.06.2020
7	Левин	Левин	Л.Л.	07.07.2020
8	Морозов	Морозов	М.М.	08.08.2020
9	Мухоморов	Мухоморов	М.М.	09.09.2020
10	Новиков	Новиков	Н.Н.	10.10.2020
11	Попов	Попов	П.П.	11.11.2020
12	Рябинин	Рябинин	Р.Р.	12.12.2020
13	Соловьев	Соловьев	С.С.	13.01.2021
14	Тихонов	Тихонов	Т.Т.	14.02.2021
15	Федотов	Федотов	Ф.Ф.	15.03.2021
16	Харин	Харин	Х.Х.	16.04.2021
17	Цыганков	Цыганков	Ц.Ц.	17.05.2021

sign.	sign.
-------	-------

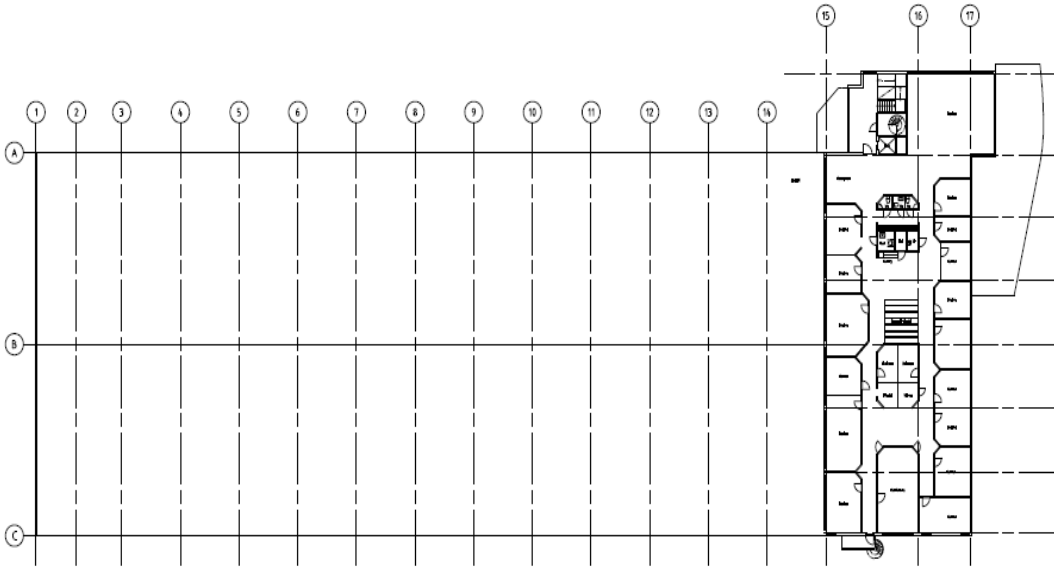

NO	REV	ÄNDRINGEN	ORSAK	DATE
RELATIONSHANDLING				
COREM BACKA 72:17				
COREM				
X/A	ARBETAD	2008-05-05		
B	-	-		
C	-	-		
D	-	-		
E	-	-		
F	-	-		
G	-	-		
H	-	-		
I	-	-		
J	-	-		
K	-	-		
L	-	-		
M	-	-		
N	-	-		
O	-	-		
P	-	-		
Q	-	-		
R	-	-		
S	-	-		
T	-	-		
U	-	-		
V	-	-		
W	-	-		
X	-	-		
Y	-	-		
Z	-	-		
AA	-	-		
AB	-	-		
AC	-	-		
AD	-	-		
AE	-	-		
AF	-	-		
AG	-	-		
AH	-	-		
AI	-	-		
AJ	-	-		
AK	-	-		
AL	-	-		
AM	-	-		
AN	-	-		
AO	-	-		
AP	-	-		
AQ	-	-		
AR	-	-		
AS	-	-		
AT	-	-		
AU	-	-		
AV	-	-		
AW	-	-		
AX	-	-		
AY	-	-		
AZ	-	-		
BA	-	-		
BB	-	-		
BC	-	-		
BD	-	-		
BE	-	-		
BF	-	-		
BG	-	-		
BH	-	-		
BI	-	-		
BJ	-	-		
BK	-	-		
BL	-	-		
BM	-	-		
BN	-	-		
BO	-	-		
BP	-	-		
BQ	-	-		
BR	-	-		
BS	-	-		
BT	-	-		
BU	-	-		
BV	-	-		
BW	-	-		
BX	-	-		
BY	-	-		
BZ	-	-		
CA	-	-		
CB	-	-		
CC	-	-		
CD	-	-		
CE	-	-		
CF	-	-		
CG	-	-		
CH	-	-		
CI	-	-		
CJ	-	-		
CK	-	-		
CL	-	-		
CM	-	-		
CN	-	-		
CO	-	-		
CP	-	-		
CQ	-	-		
CR	-	-		
CS	-	-		
CT	-	-		
CU	-	-		
CV	-	-		
CW	-	-		
CX	-	-		
CY	-	-		
CZ	-	-		
DA	-	-		
DB	-	-		
DC	-	-		
DD	-	-		
DE	-	-		
DF	-	-		
DG	-	-		
DH	-	-		
DI	-	-		
DJ	-	-		
DK	-	-		
DL	-	-		
DM	-	-		
DN	-	-		
DO	-	-		
DP	-	-		
DQ	-	-		
DR	-	-		
DS	-	-		
DT	-	-		
DU	-	-		
DV	-	-		
DW	-	-		
DX	-	-		
DY	-	-		
DZ	-	-		
EA	-	-		
EB	-	-		
EC	-	-		
ED	-	-		
EE	-	-		
EF	-	-		
EG	-	-		
EH	-	-		
EI	-	-		
EJ	-	-		
EK	-	-		
EL	-	-		
EM	-	-		
EN	-	-		
EO	-	-		
EP	-	-		
EQ	-	-		
ER	-	-		
ES	-	-		
ET	-	-		
EU	-	-		
EV	-	-		
EW	-	-		
EX	-	-		
EY	-	-		
EZ	-	-		
FA	-	-		
FB	-	-		
FC	-	-		
FD	-	-		
FE	-	-		
FF	-	-		
FG	-	-		
FH	-	-		
FI	-	-		
FJ	-	-		
FK	-	-		
FL	-	-		
FM	-	-		
FN	-	-		
FO	-	-		
FP	-	-		
FQ	-	-		
FR	-	-		
FS	-	-		
FT	-	-		
FU	-	-		
FV	-	-		
FW	-	-		
FX	-	-		
FY	-	-		
FZ	-	-		
GA	-	-		
GB	-	-		
GC	-	-		
GD	-	-		
GE	-	-		
GF	-	-		
GG	-	-		
GH	-	-		
GI	-	-		
GJ	-	-		
GK	-	-		
GL	-	-		
GM	-	-		
GN	-	-		
GO	-	-		
GP	-	-		
GQ	-	-		
GR	-	-		
GS	-	-		
GT	-	-		
GU	-	-		
GV	-	-		
GW	-	-		
GX	-	-		
GY	-	-		
GZ	-	-		
HA	-	-		
HB	-	-		
HC	-	-		
HD	-	-		
HE	-	-		
HF	-	-		
HG	-	-		
HH	-	-		
HI	-	-		
HJ	-	-		
HK	-	-		
HL	-	-		
HM	-	-		
HN	-	-		
HO	-	-		
HP	-	-		
HQ	-	-		
HR	-	-		
HS	-	-		
HT	-	-		
HU	-	-		
HV	-	-		
HW	-	-		
HX	-	-		
HY	-	-		
HZ	-	-		
IA	-	-		
IB	-	-		
IC	-	-		
ID	-	-		
IE	-	-		
IF	-	-		
IG	-	-		
IH	-	-		
II	-	-		
IJ	-	-		
IK	-	-		
IL	-	-		
IM	-	-		
IN	-	-		
IO	-	-		
IP	-	-		
IQ	-	-		
IR	-	-		
IS	-	-		
IT	-	-		
IU	-	-		
IV	-	-		
IW	-	-		
IX	-	-		
IY	-	-		
IZ	-	-		
JA	-	-		
JB	-	-		
JC	-	-		
JD	-	-		
JE	-	-		
JF	-	-		
JG	-	-		
JH	-	-		
JI	-	-		
I	-	-		

sign.	sign.
-------	-------

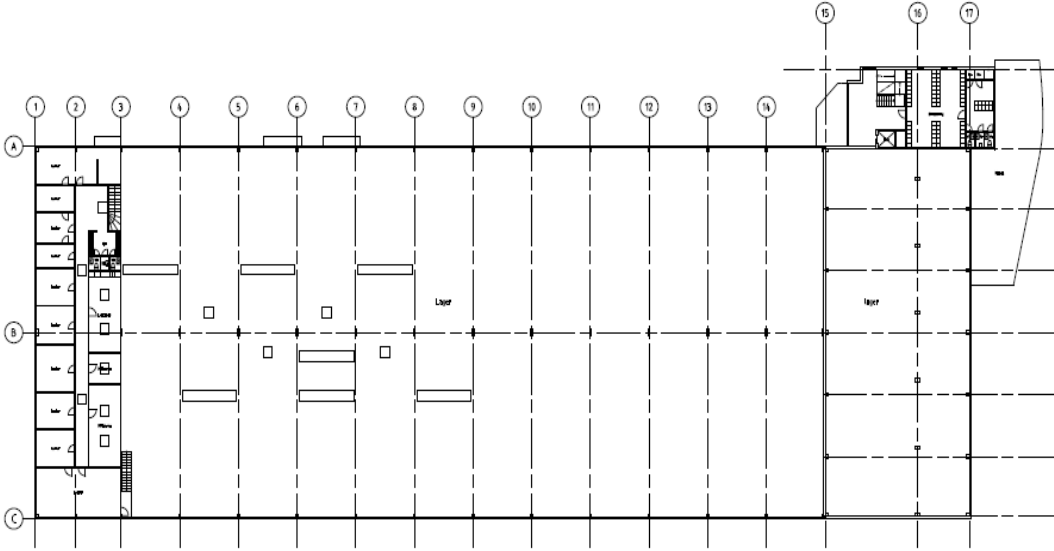

nr	nr	nr	nr
nr	nr	nr	nr

RELATIONSHANDLING

COREM  
BACKA 22:17

COREM

X	A	Arkiv 10	2008-03-26 15:16

OPPRÄTTAD	REVISORIS P. S. BY	REVISORIS DATUM
UTGIV	REVISORIS	
UTGIV	REVISORIS	

Befälhavare  
Plan 14  
Göteborgs Stad  
Exportgatan 65

PROJEKT	PROJEKT	PROJEKT
nr 1000	nr 1000	nr 1000
nr 1000	A-10.1-202	

sign.	sign.
-------	-------