


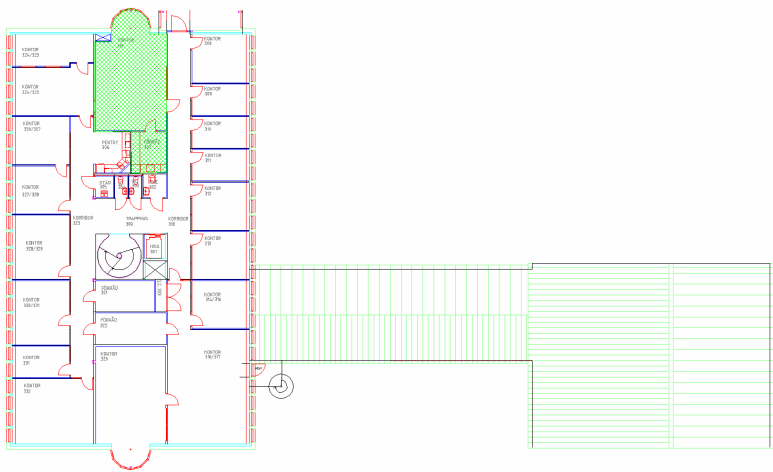

PLAN 3

C	Nytt forråd 324/325	MMe	20090804
B	Nytt kontor 330/331	MMe	20030423
A	Allmän revidering	MMe	20030401
Rev.	Revideringen avser	Sign.	Datum

RELATIONSRITNING

Soft Center

4

RONNEBY

Plan 3

Ritad	Datum	Skala	Ritn.nr	Rev.
Fogelberg	1991	1:200	A:430	c