


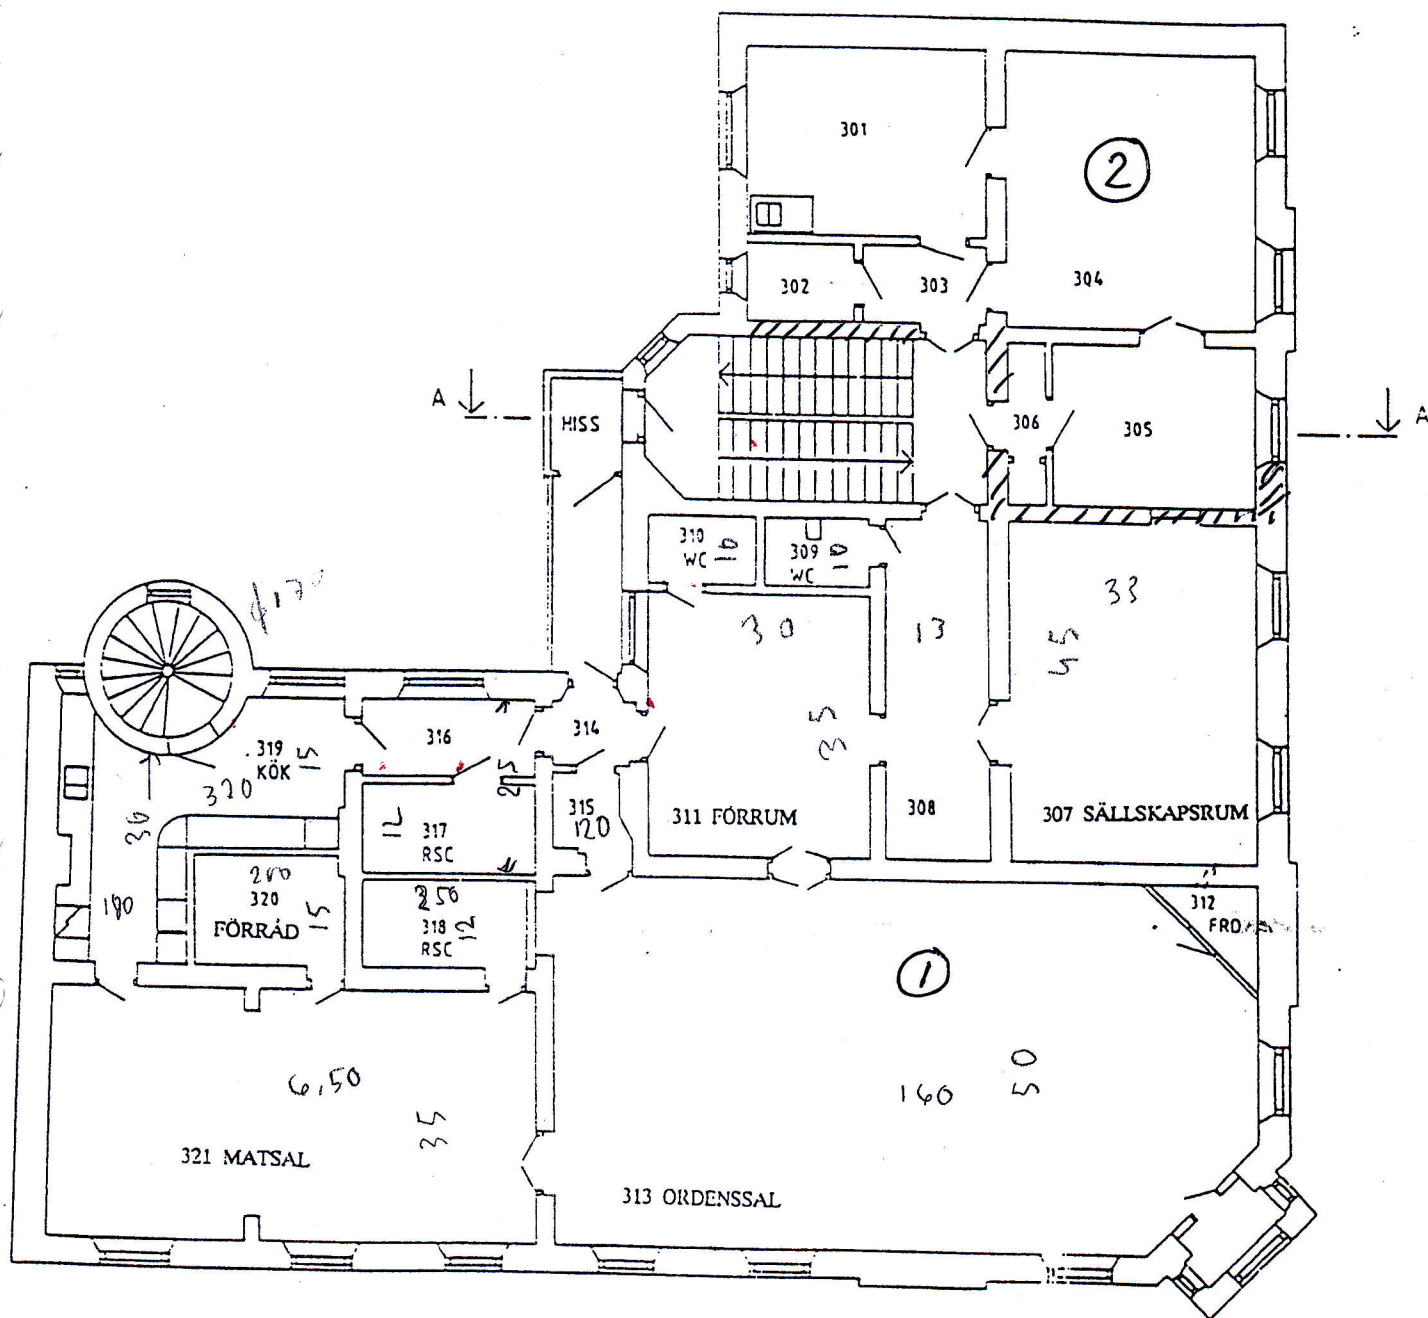

TRB
 SHELDON 5
 PLAN 3.

- ① TR
- ② NBV studie