


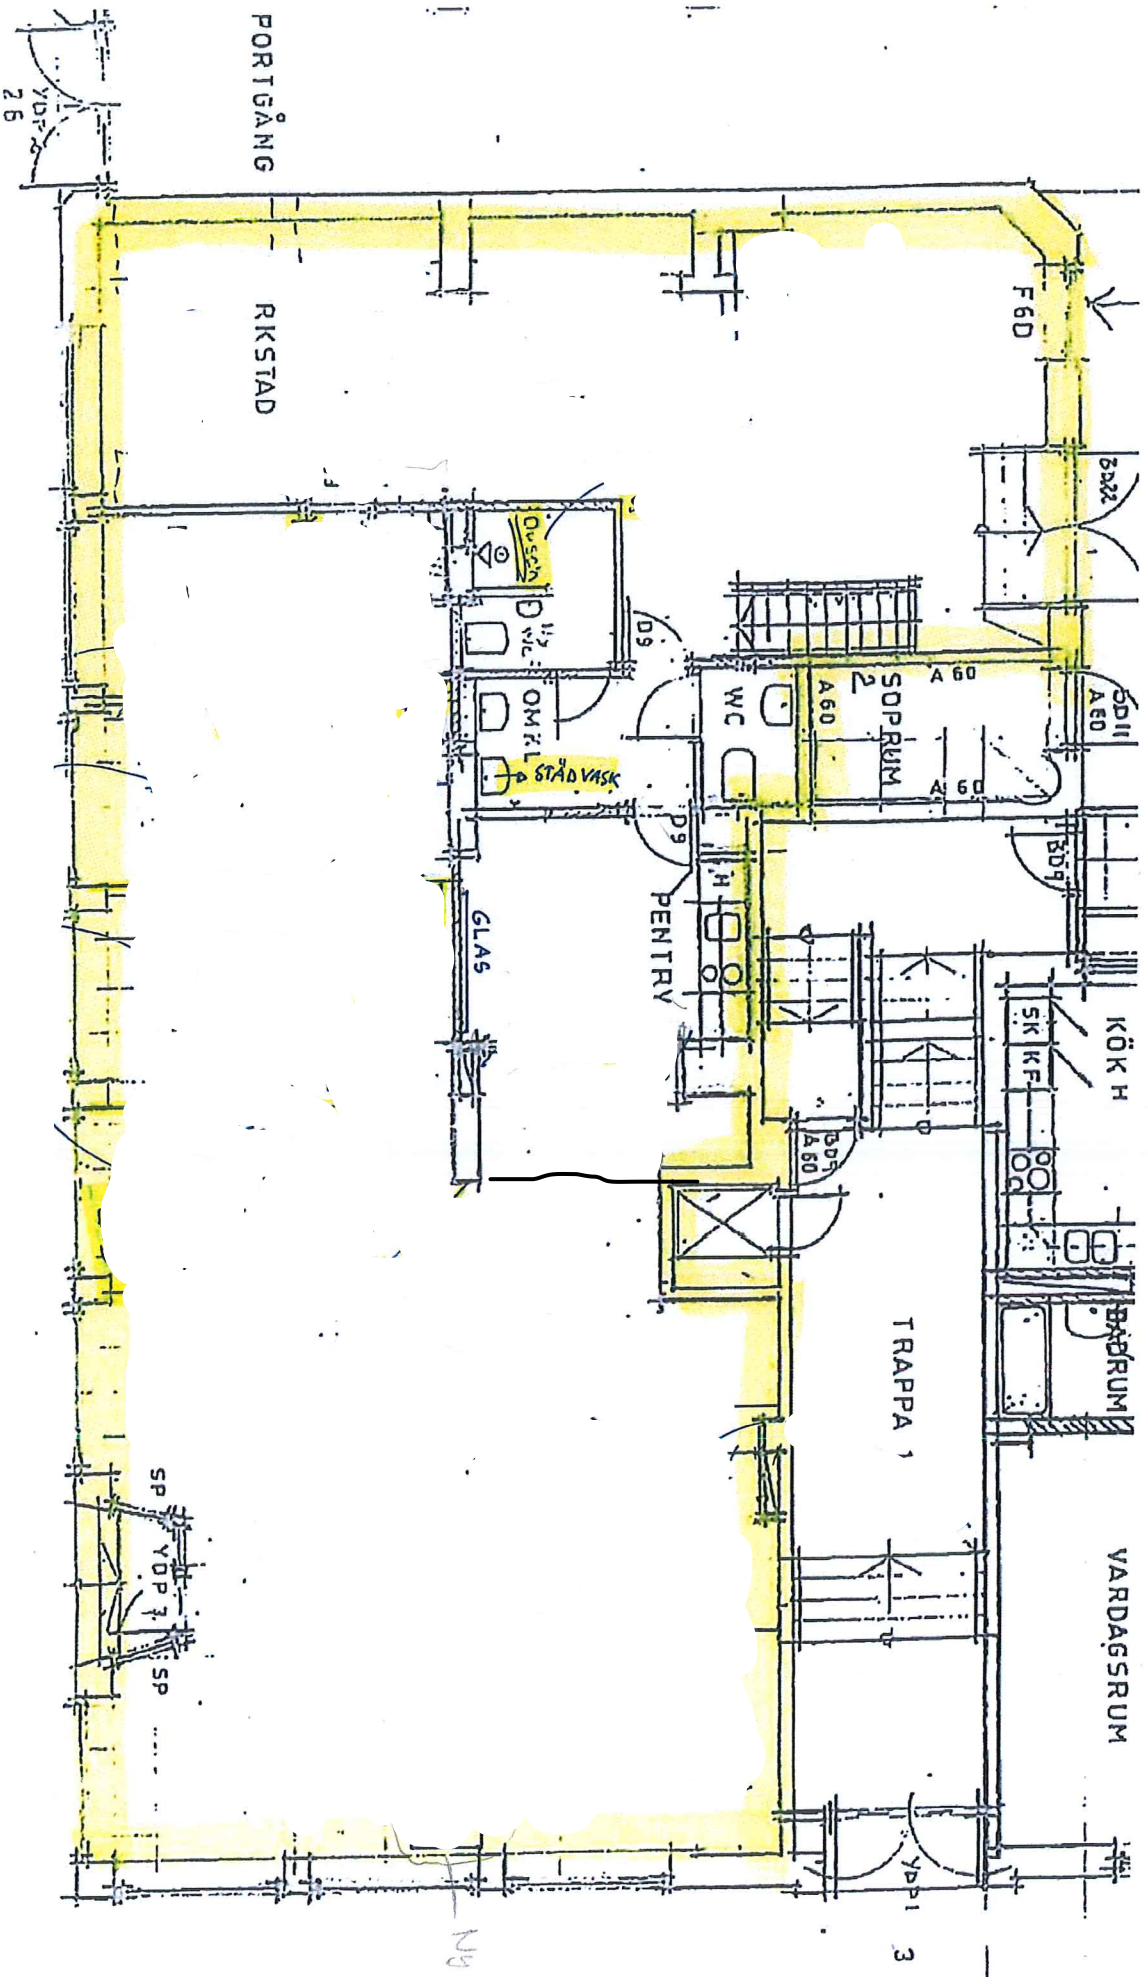

Ny dän



