


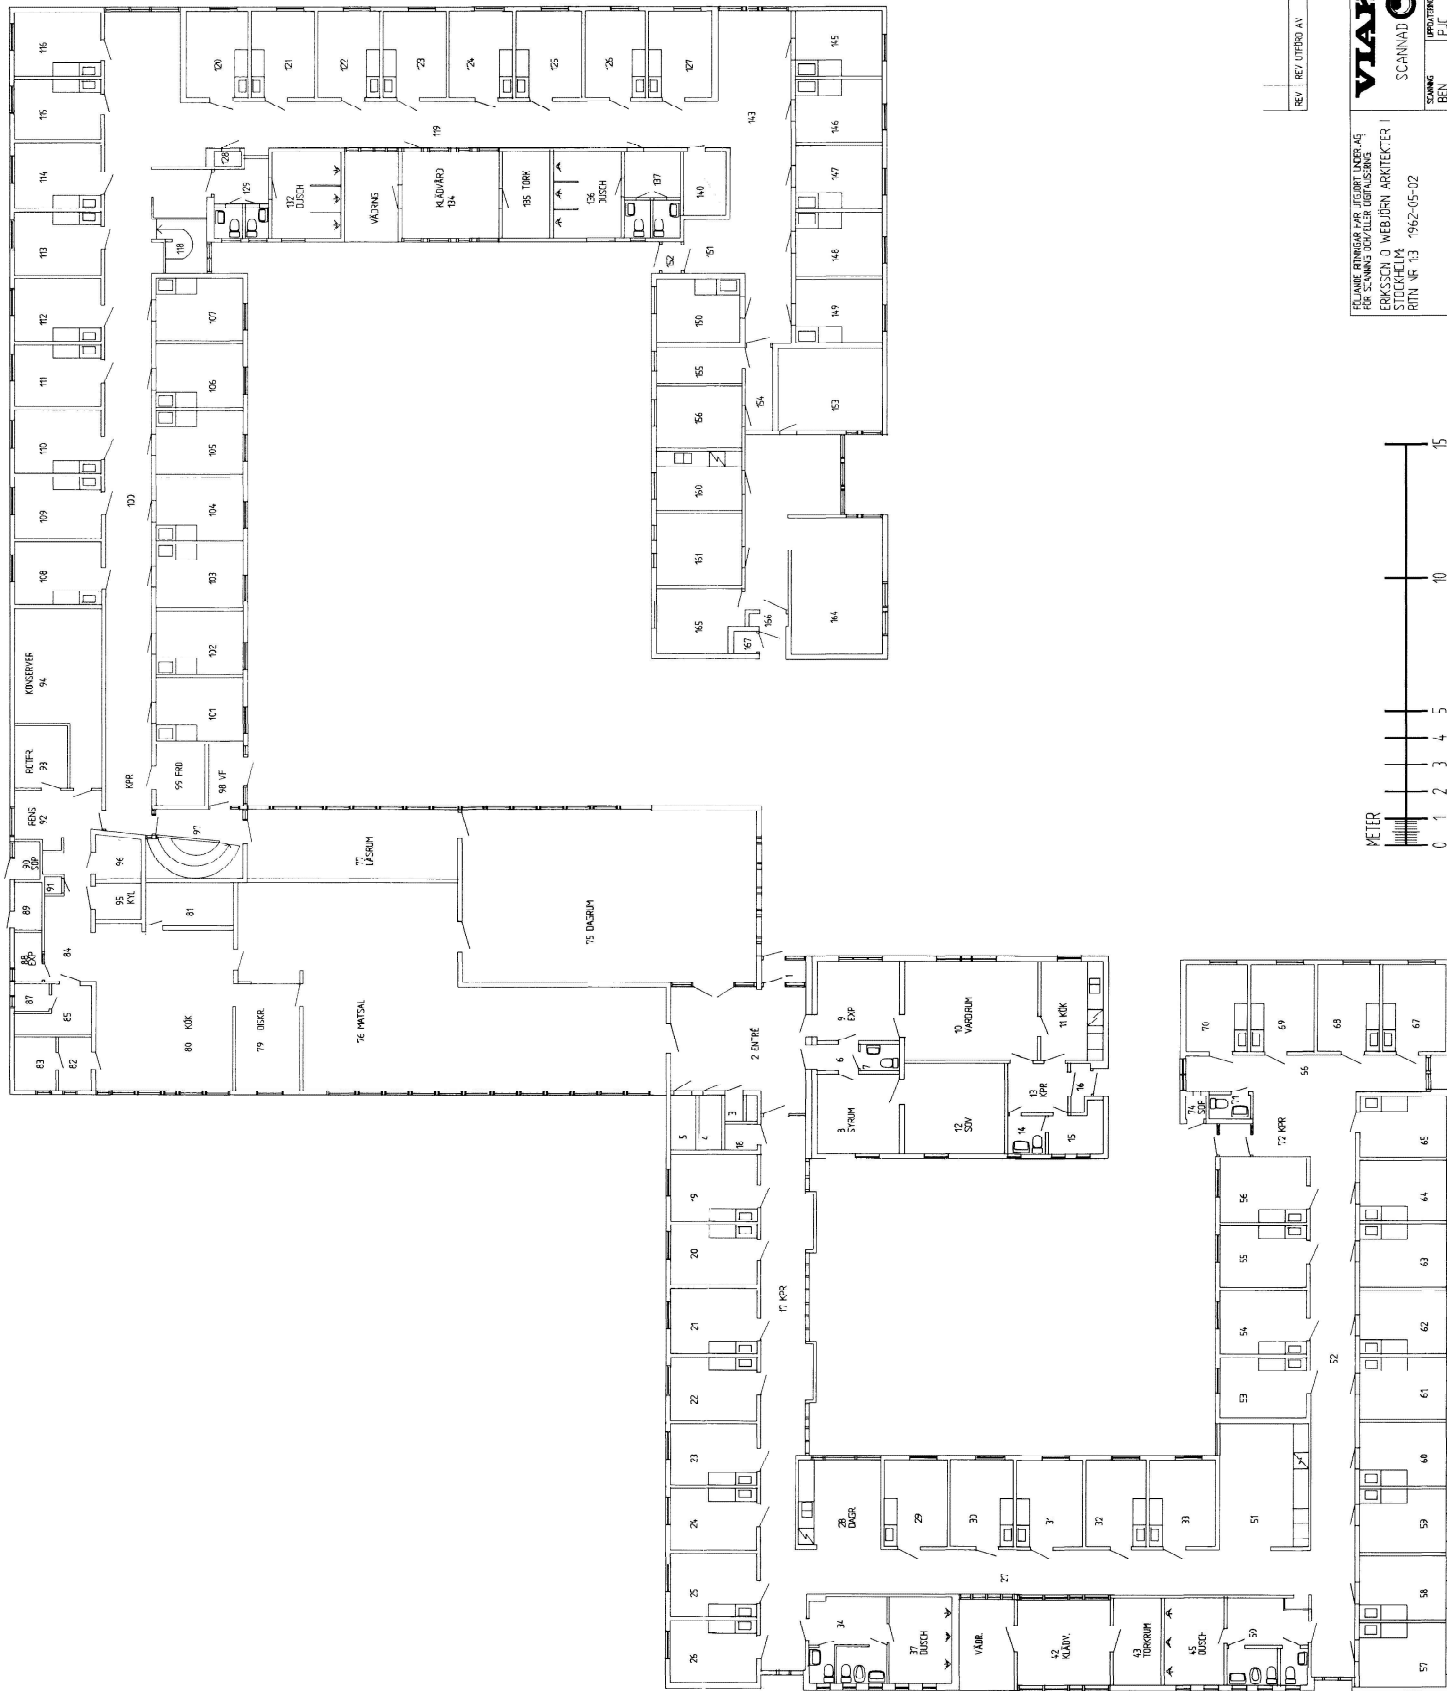

REV	REV	UTP	AV	DATUM
RELÄNDE RINGBORG PAR. JULENT LINDER A/S PER SCANNING OG/ELLER UDFÅLSNING STICKEHJEM RITN. NR. 13	RELATIONS RITNING	JANTLANDS LING LANCSTING ELEVHEMMET SÖRGÅRD I STRÖMSUND	PLAN 2	8/4/10/12
