


Bil3

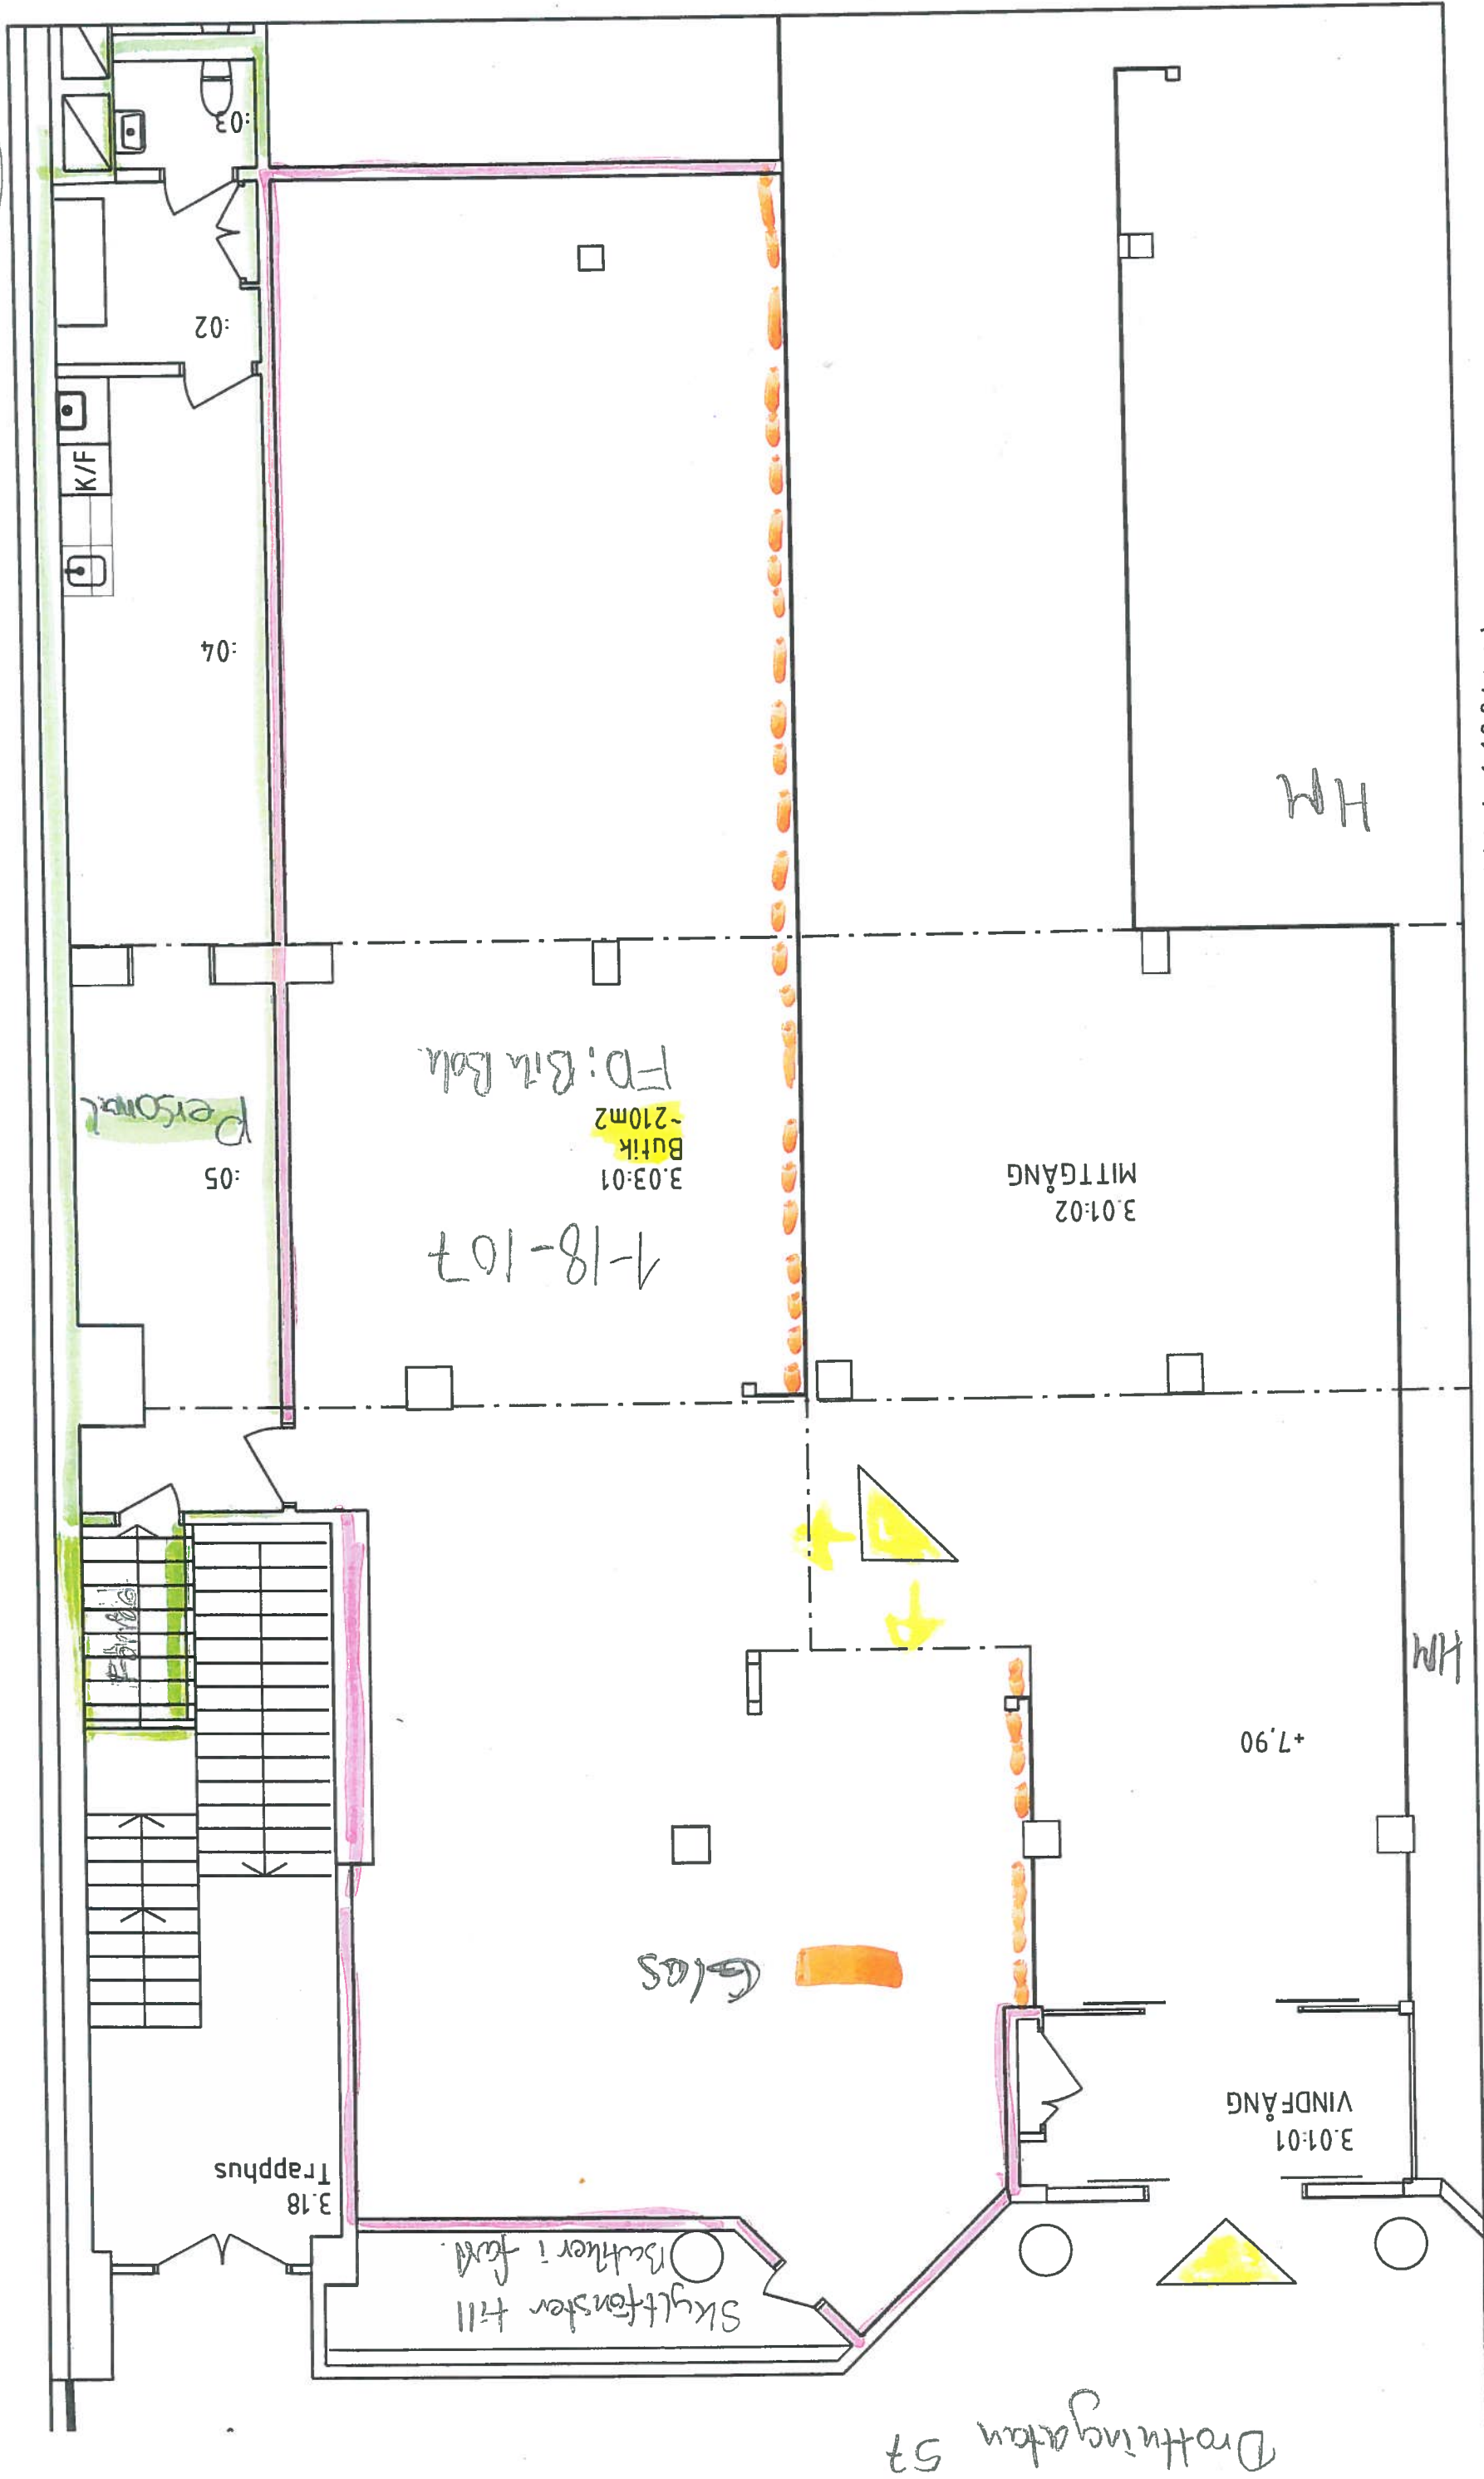

SKALA 1:100(A4)

10


2

100

MFTER

Ku Uppsala 12
Cibygge

Drothingatan St