


Situationsplan Nya Ingång.

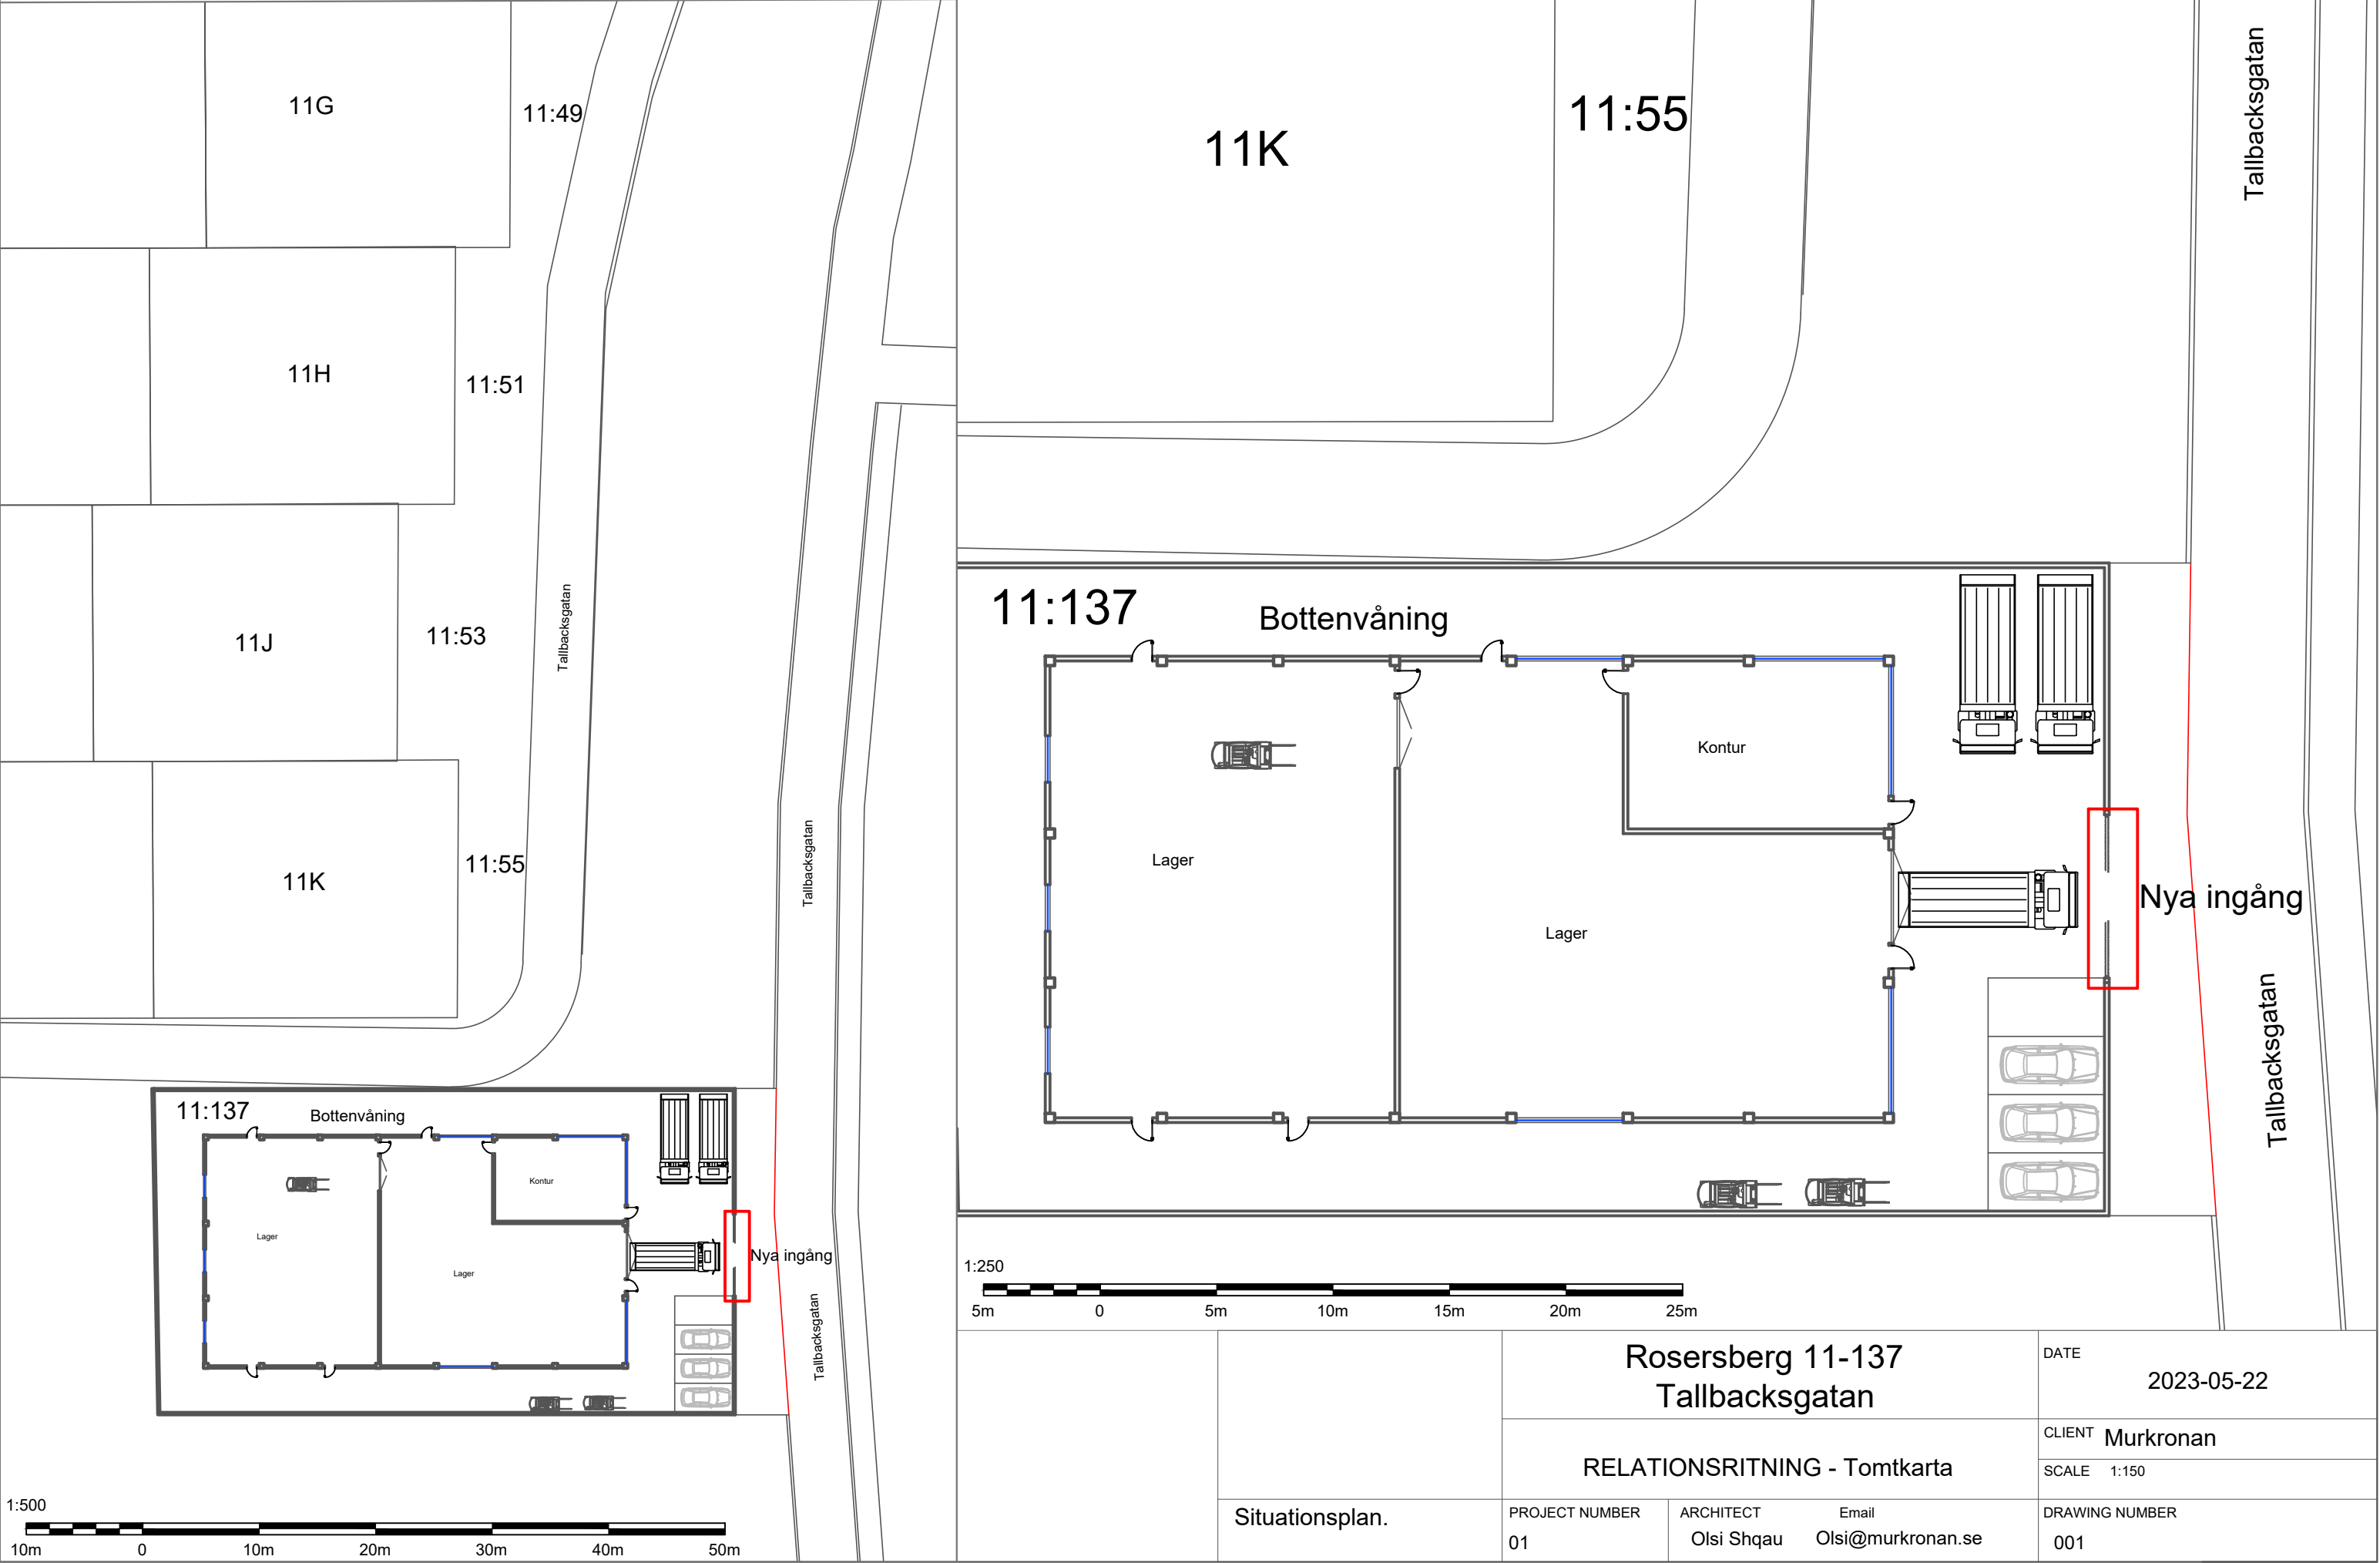

Rosersberg 11-137
Tallbacksgatan

DATE
2023-05-22

RELATIONS RITNING - Tomtkarta

CLIENT Murkronan

SCALE 1:150

Situationsplan.

PROJECT NUMBER
01

ARCHITECT
Olsi Shqau
Email
Olsi@murkronan.se

DRAWING NUMBER
001