


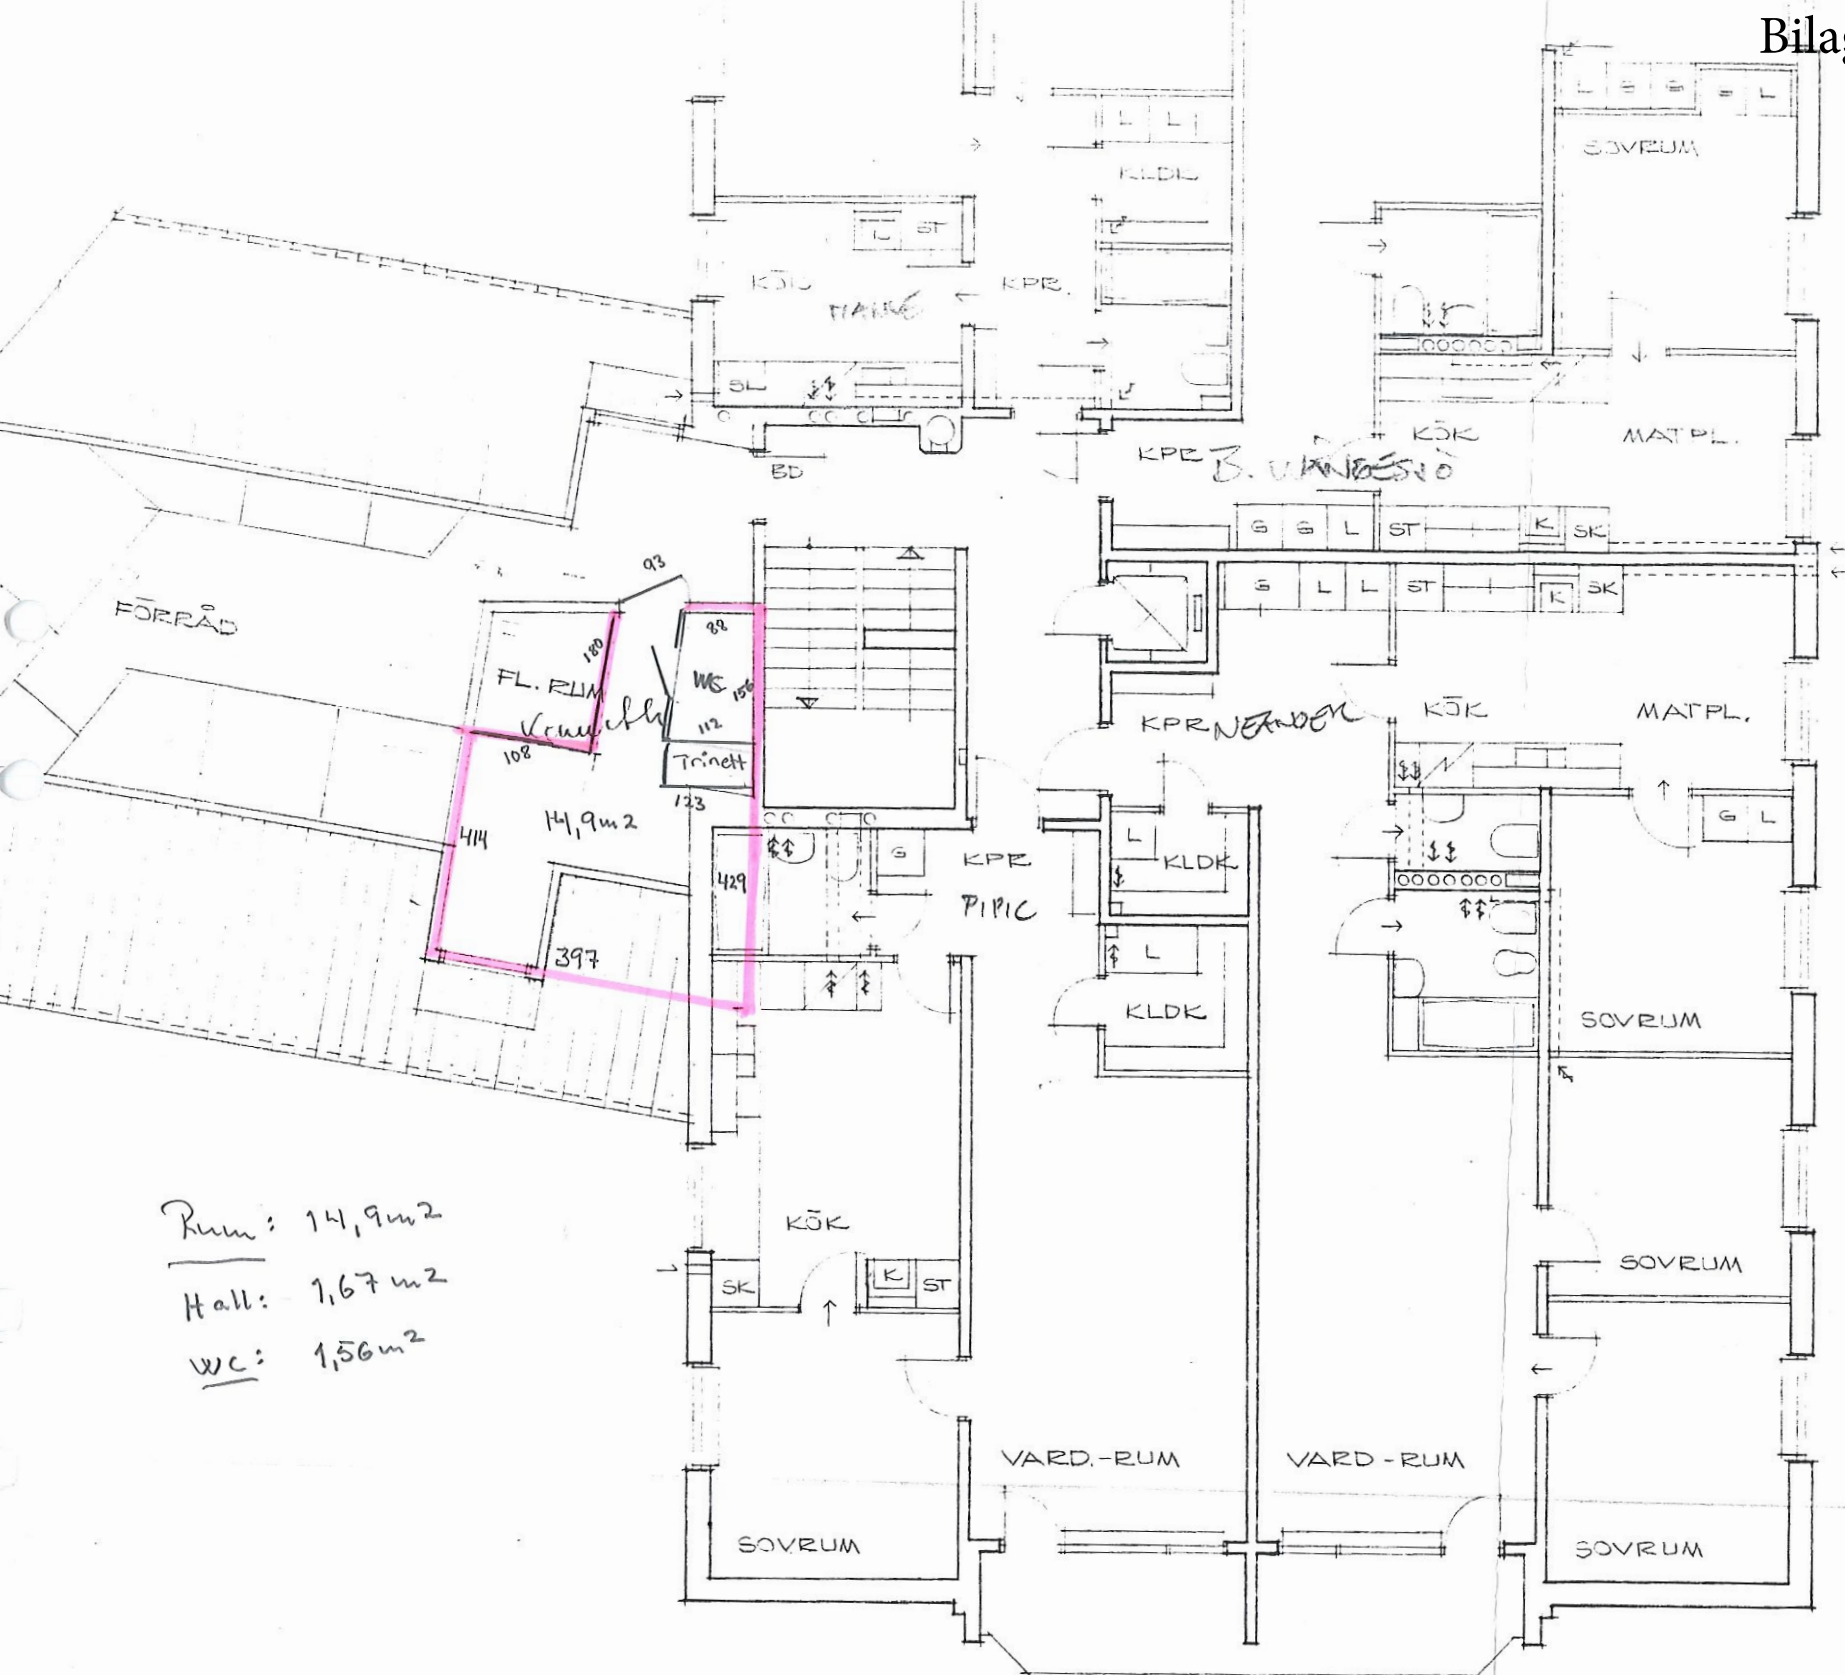

Rum: 14,9m²

Hall: 1,67m²

WC: 1,56m²