
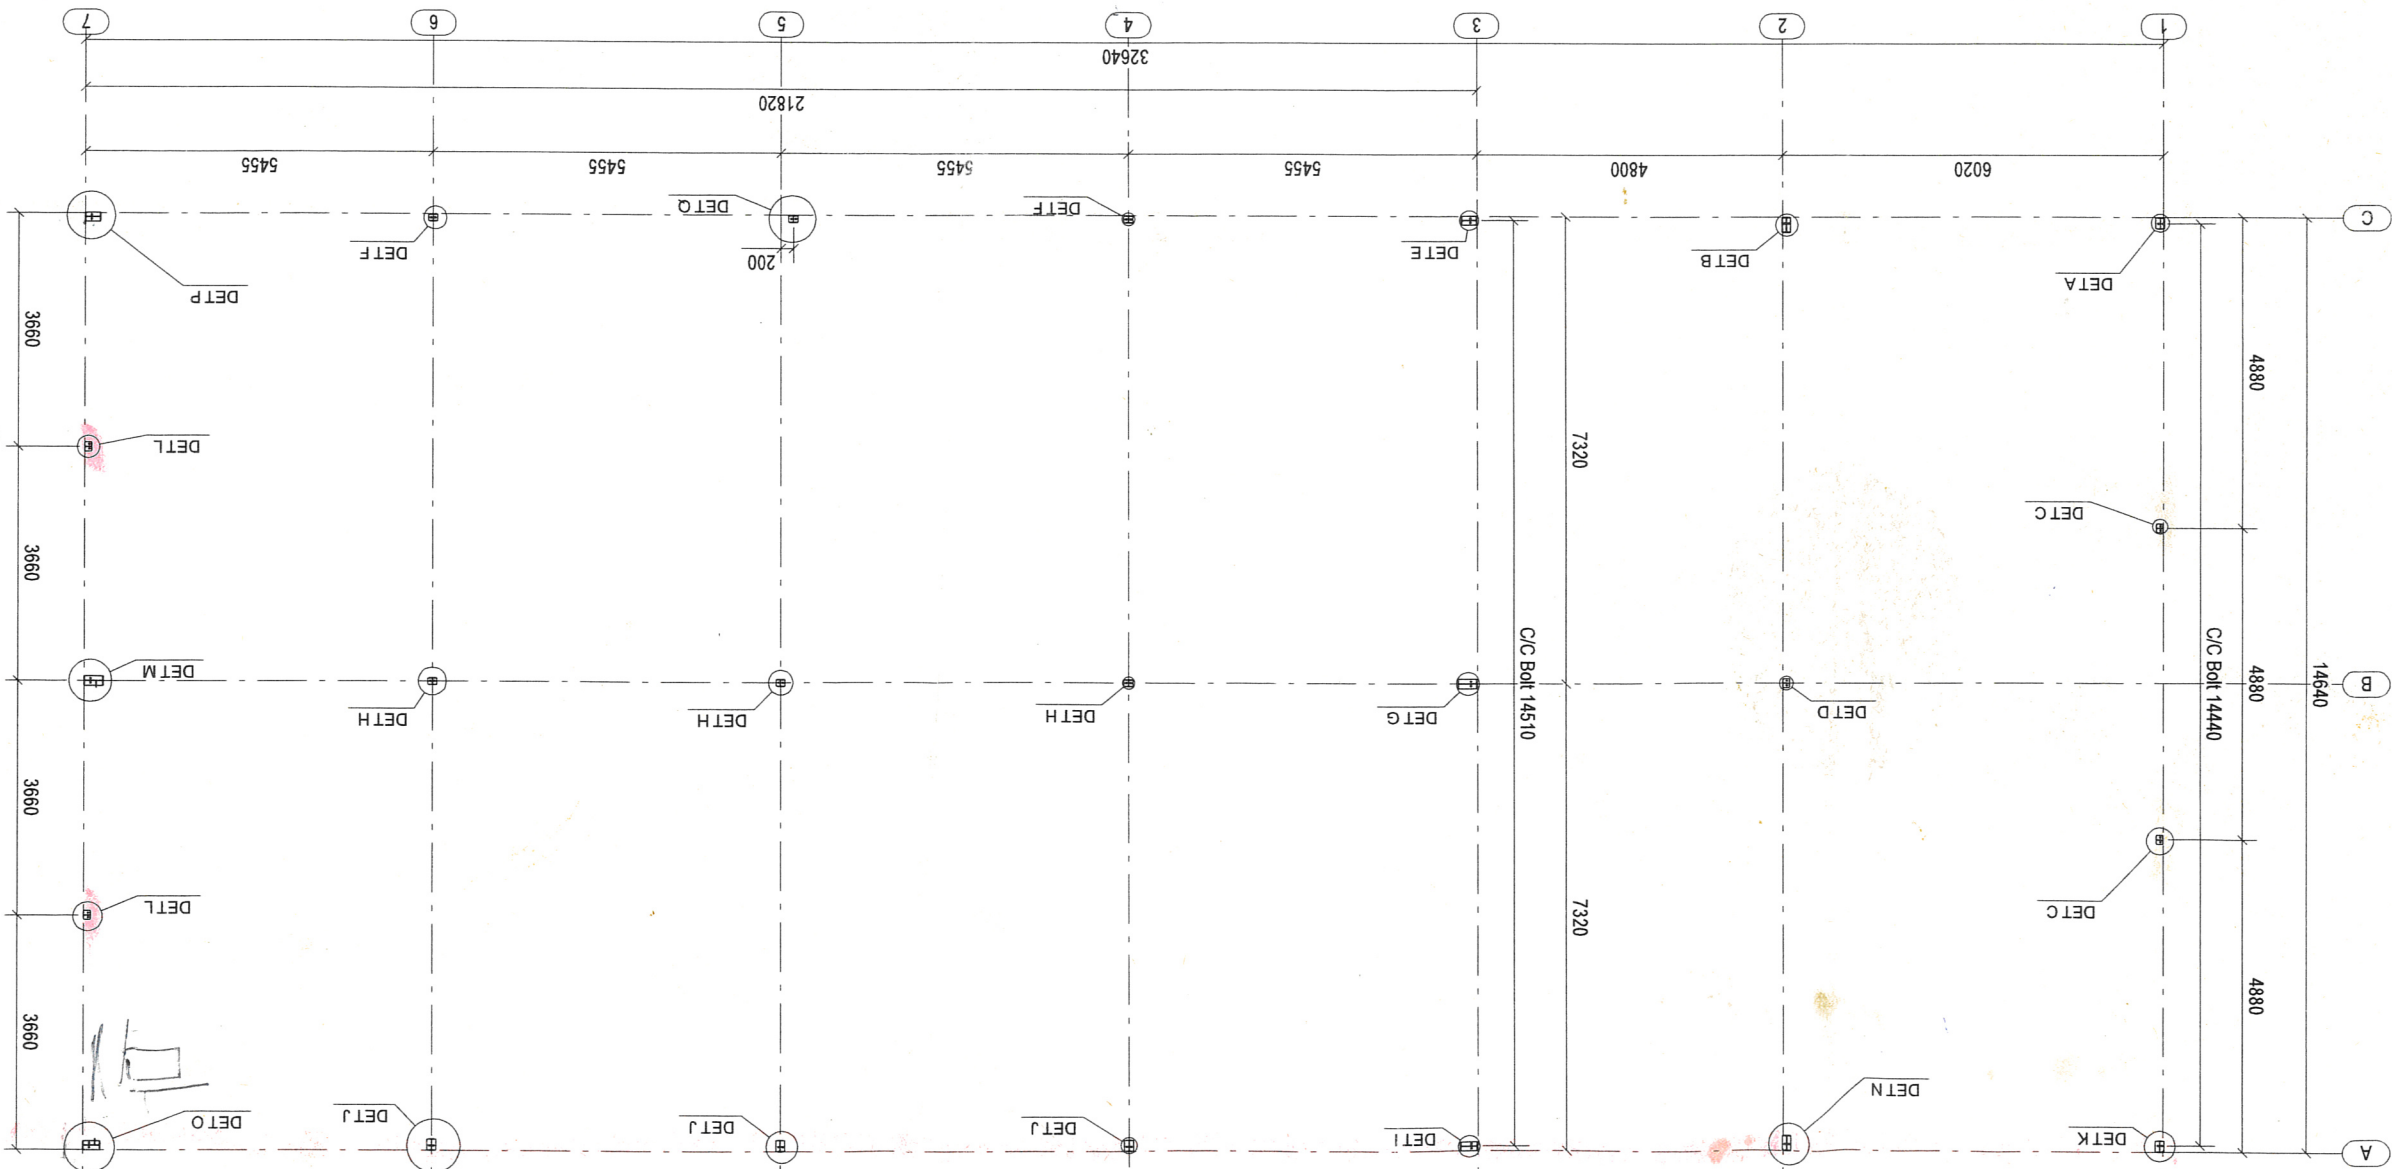


Fundamenter:
Nedstøtning af ramme-ankre
I god tid før spærmontage.
Korrekt placering af gavissøjler
er udenfor vort ansvar.

Tolerancer:
Ramme-anker Kote +/- 5mm
Søjle-anker Kote +/- 5mm
Vandr. +/- 5mm
Udsparring Kote +/- 0
Vandr. +/- 20mm

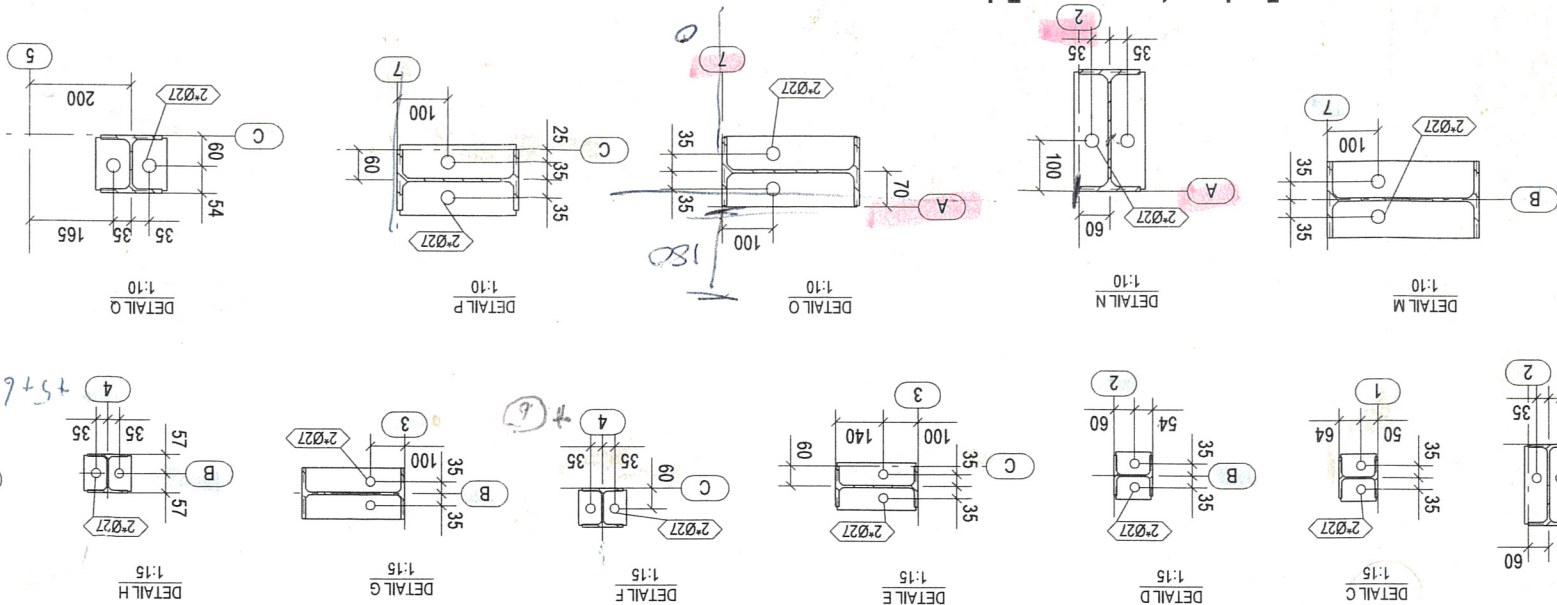

Customer:	Jordell
Customer:	Argongatan 16 431 53 Mölndal
Drawing Title:	Anchor plan
Drawing No.:	[3]
Project No.:	11009
Designer:	L. Jansson
Checked By:	A. Krumlin
Approved By:	K. P. Nielsen
Scale:	1:10
Scale:	1:15
Revision No.:	4
Phase No.:	
DRG. CREATED:	13.02.2014
DRG. MODIF.:	19.02.2014
CSK Steel SIA Stacijas iela 6a Tukums LV3101 Tāl.: +37163181575 Fakss: +37163107095 info@csk.lv	

REV. DATE	REVISION DESCRIPTION
18.02.2014	Building high
17.02.2014	Clips on wall
14.02.2014	Clips, remove uddhang

3 2 1
