


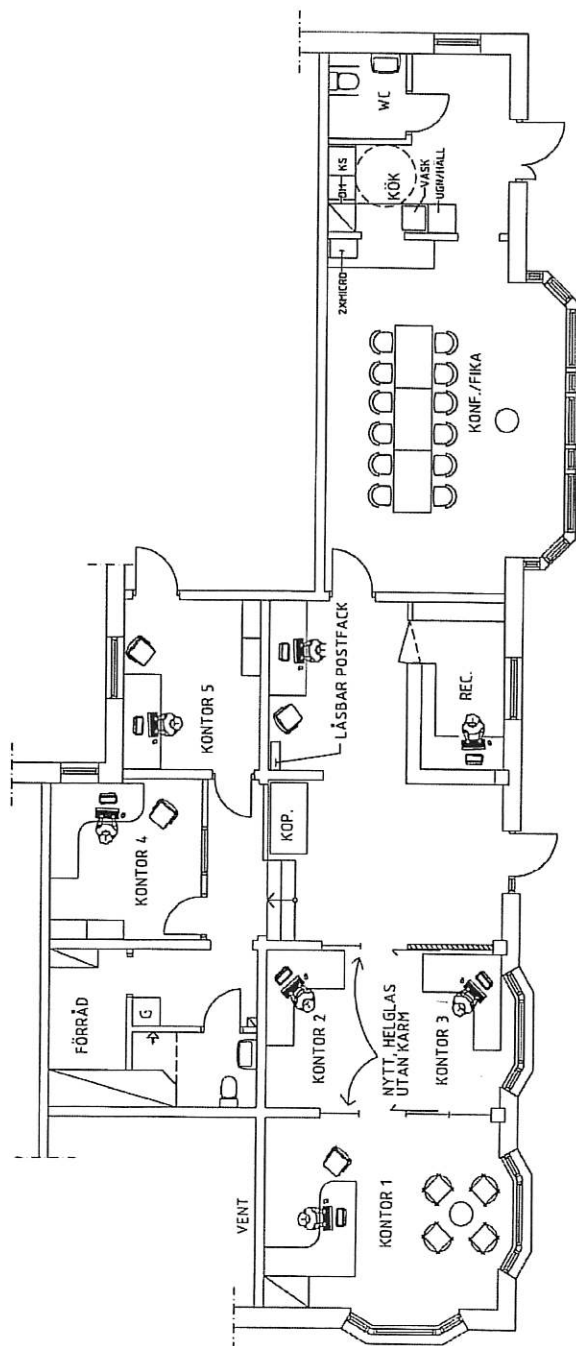

PH 19 01 08 JUSTERAT KÖK
PH 18 12 06 NY PLANLÖSNING
PH 18 09 06 ALTERNATIV 2
PH 18 08 01

[illegible]