


Ungefärlig ritning lagerfastighet Grebbeshult 1:21. Totalt ca. 1210 kvm

Entresol ca. 210 kvm

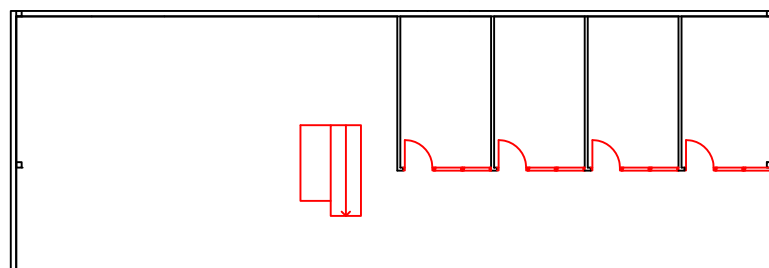

Markplan ca.
1000 kvm

