


— .. — BRANDCELLSGRÄNS

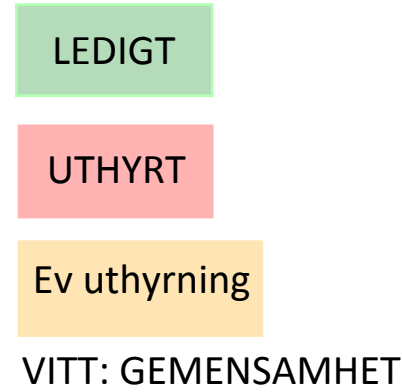

Architectural floor plan of the Källarvåning (Basement). The plan shows a large room labeled FRD 004, a smaller room labeled FRD 003, a room labeled ELC 002, and a central area labeled HALL 001. A staircase (STEGE) and a fire escape (UTRYNNINGSLUCKA) are located near the top of the plan. The drawing is oriented with North (N) at the top. Section lines B-B and D-D are indicated.

		BET	ANT	ÄNDERINGEN AVSSER	SIGN	DATUM
	RELATIONSHANDLING	Arkitektkontoret RYDSTERN & LILIEDAHL AB Agnesgatan 5 211 33 Malmö Tel: 040-30 68 69 E-mail: info@r-l.se www.r-l.se		BORGEBY 16:26 LOMMA KOMMUN NYBYGGNAD KONTORSHOTELL OCH MILJÖHUS PLANER		
	BYGGHANDLING					
	FÖRFRÅGNINGSUNDERLAG					
	PRELIMINÄRHANDLING					
	BYGGLOVHANDLING	RTID AV, KONSTRUERAD AV AF	Arbetstnr. 16103	SKALA 1:100 (A1)		RITNINGNUMMER A0:02
	ORT, DATUM MÅLMÖ. 2018-10-10					