Från: **Johan Swedérus** johan@newproperty.se
Ämne:
Datum: 9 november 2026 12:34
Till:

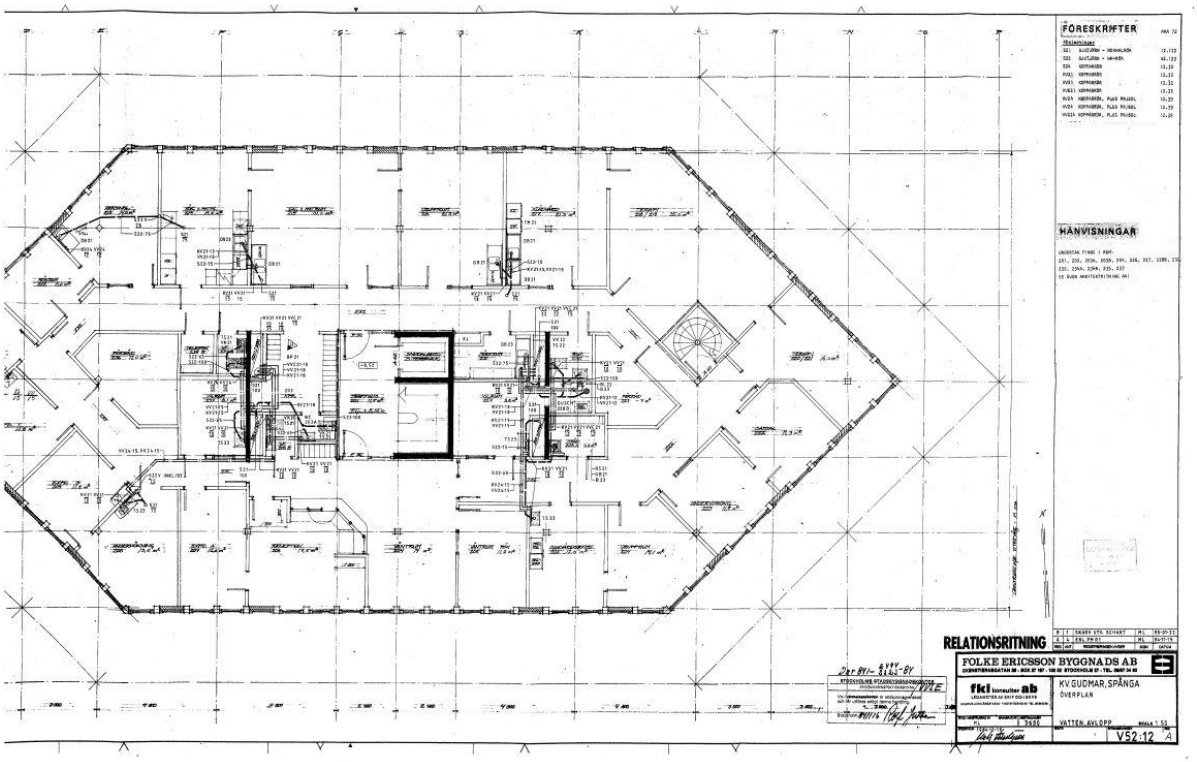

Johan Swedérus
Leasing Manager Office
+46 708 26 86 56 www.newproperty.se
johan@newproperty.se
Nybrogatan 39, 114 39 Stockholm
IMPORTANT: The contents of this email and any attachments are confidential. They are intended for the named recipient(s) only. If you have received this email by mistake, please notify the sender immediately and do not disclose the contents to anyone or make copies thereof.