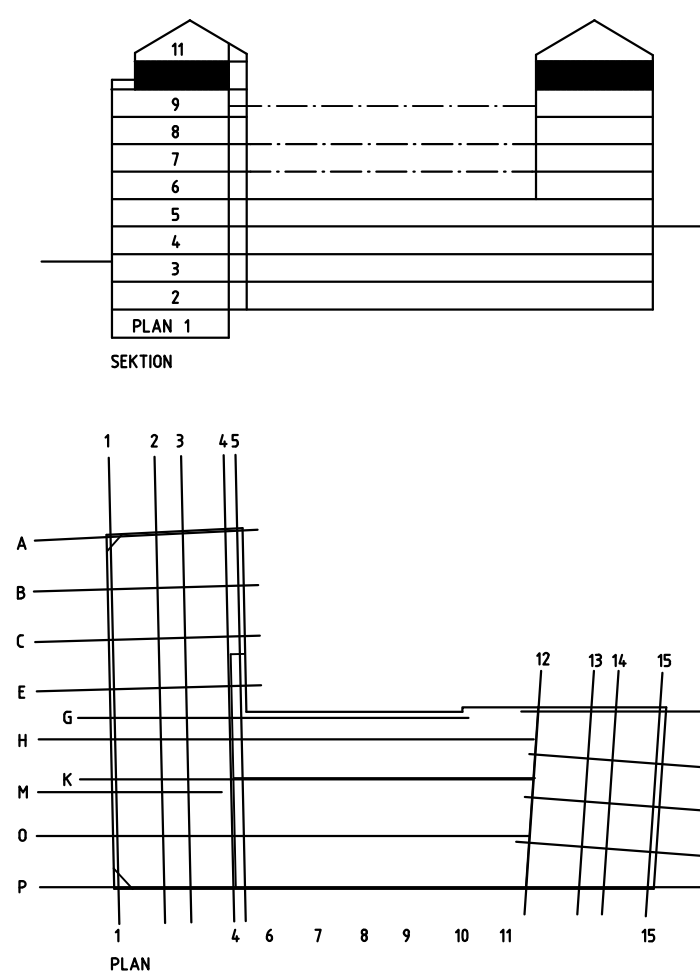
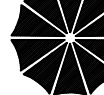


REV	ANT	REVIDERING	AVSER		SIGN	DATUM
 Skandia						
KV TÖRNET 10. STOCKHOLM						
PLAN 10						
A		DIGITALISERING RITPLANERING AB				
RITNINGSTYP						
RELATIONS RITNING						
DATUM		SKALA		ARB.NR.		
2001-11-15		1:100		8770/A025		
ANSVARIG		RITNINGSNR.		REV.		
TS		A30:10				