


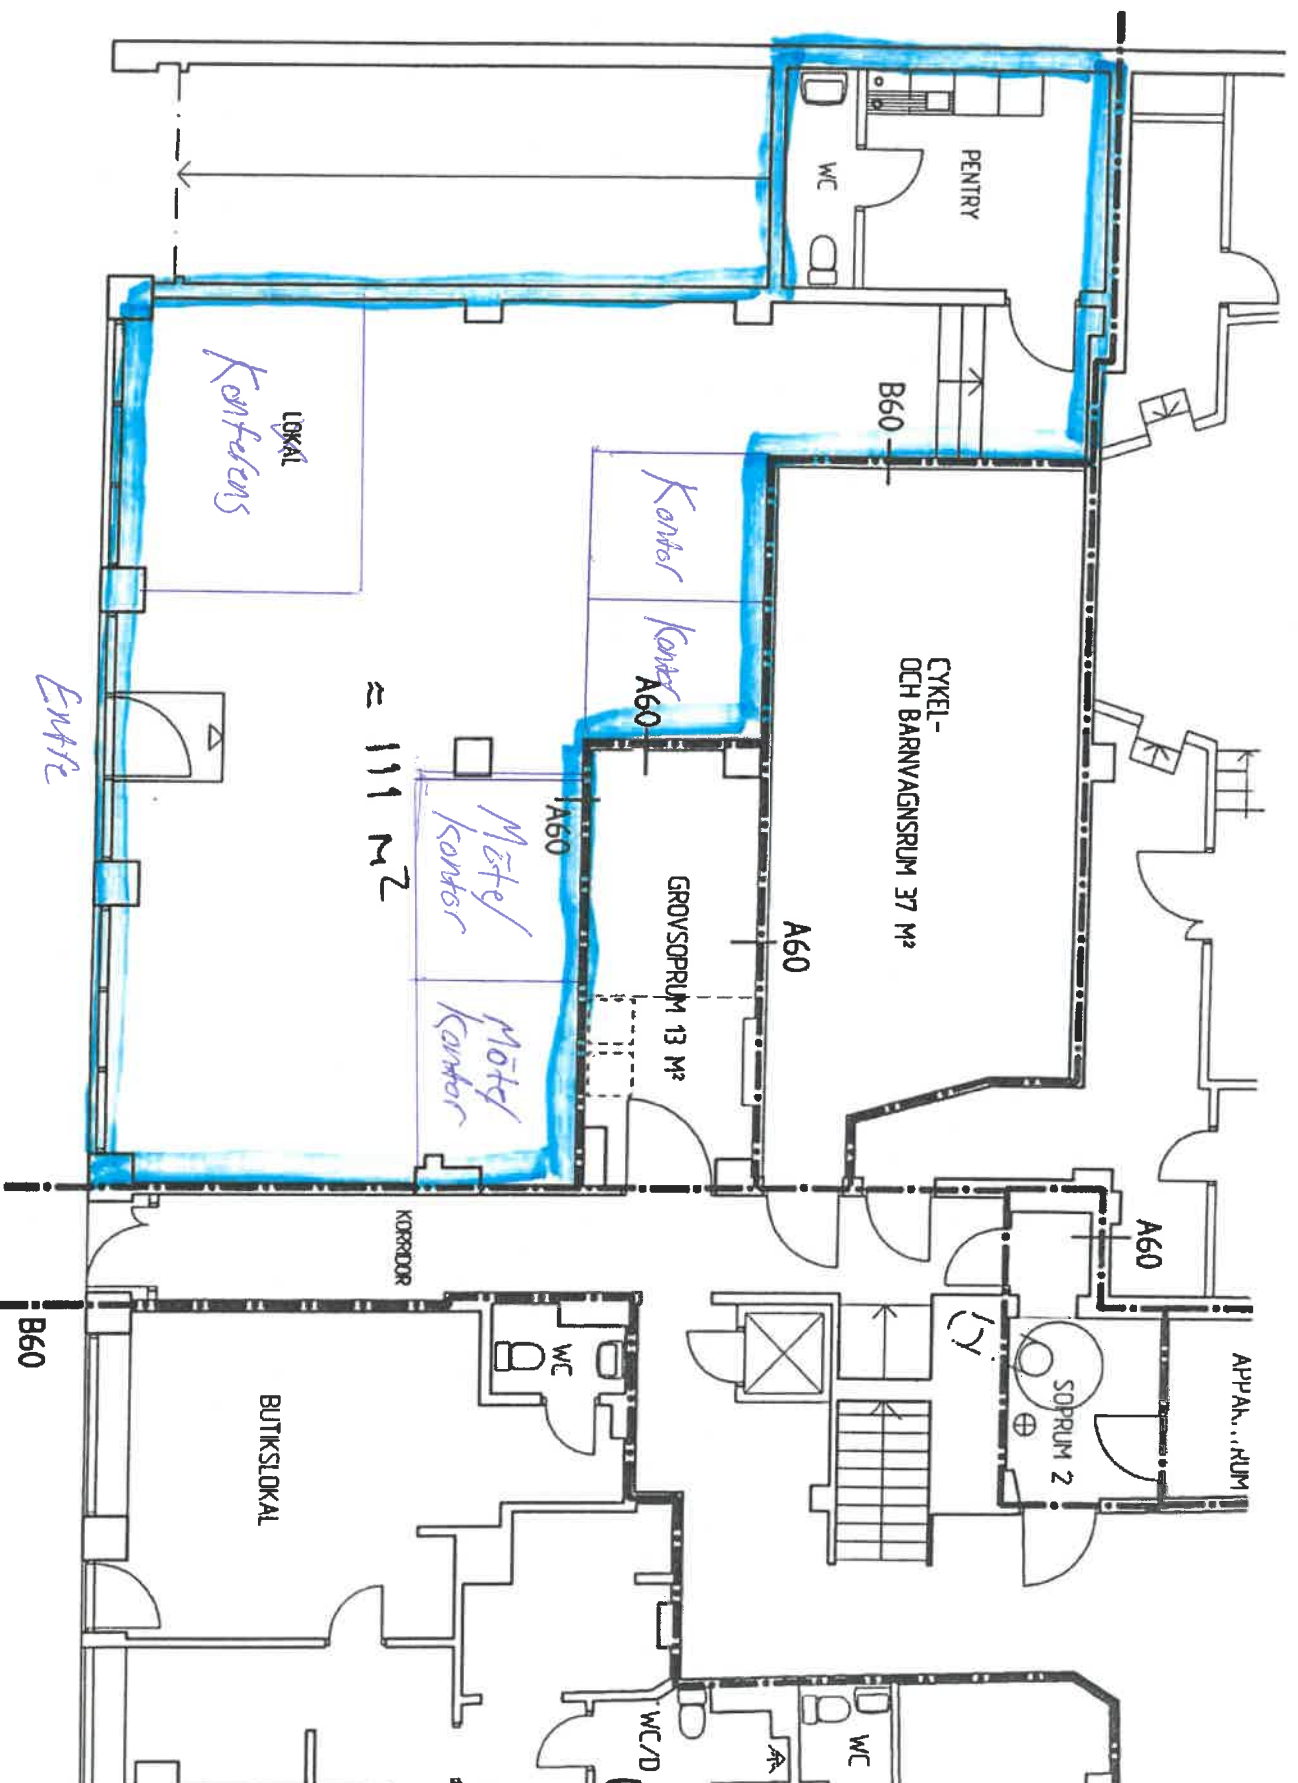

BOTTENPLAN

SURBRUNNSGATAN