


BOTTENPLAN (ÄNDRINGSRITNING.)

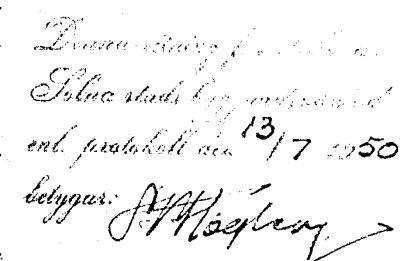

12.6 50


[illegible]

68-II

49

STOCKHOLM 1 MAJ 1950

J. ALBIN SISON STARK  
ARKITEKT. S.A.R.