


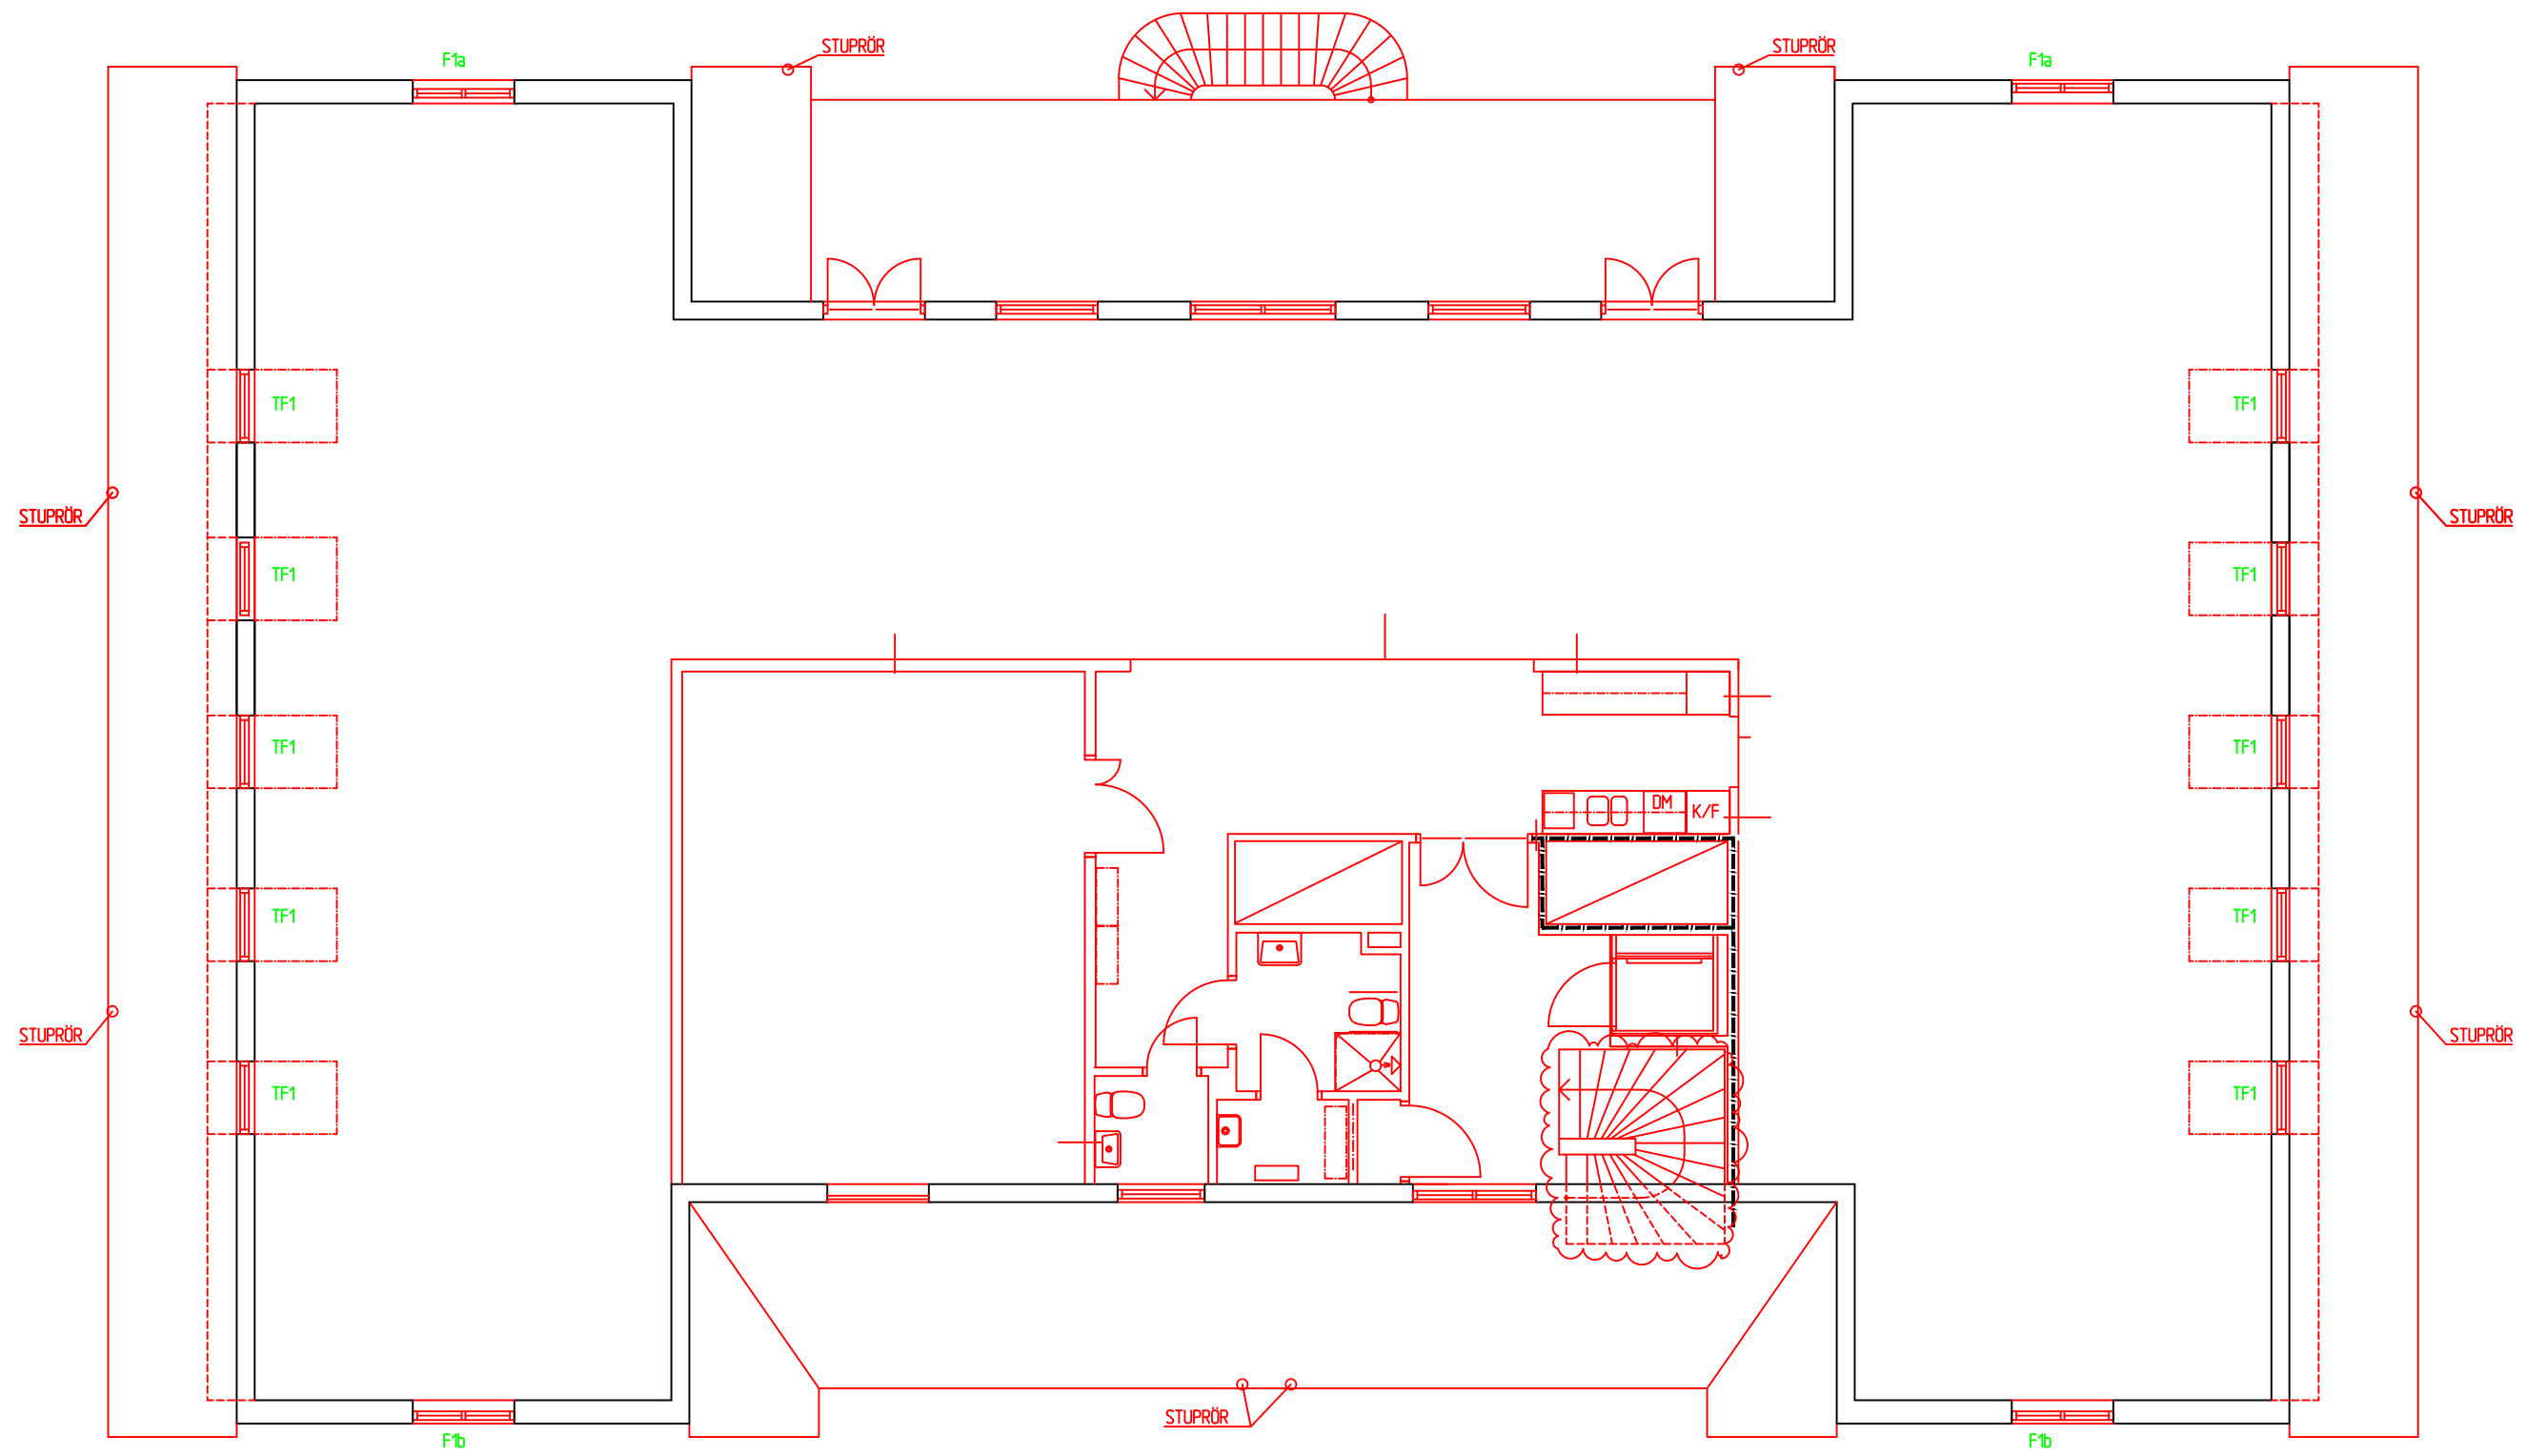

PLAN 3