


- HYRESOBJEKT
- ALLMÄN YTA
 - 101012003
 - 101012006
 - 101012007
 - 101012008
 - 101012009

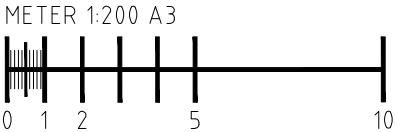

A		MARKERING YTOR	SF	2020-06-09
BET	ANT	ÄNDRINGEN AVSER	SIGN	DATUM
RELATIONSRITNING				
				
KARLSKRONA				
PROJEKT NR.		RITAD AV ES		
DATUM 2019-02-08				
PLAN 1 trp				
SKALA		NUMMER		BET
1:100/A1, 1:200/A3		A01.1-20		