



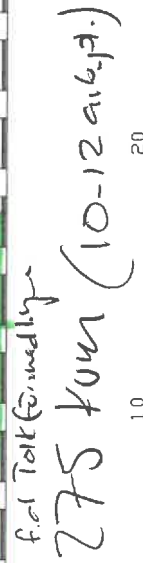

BRANDCELLSINDELNING
BRANDKLASS EI60


KLÖVERN

[illegible]