



19/11/2011

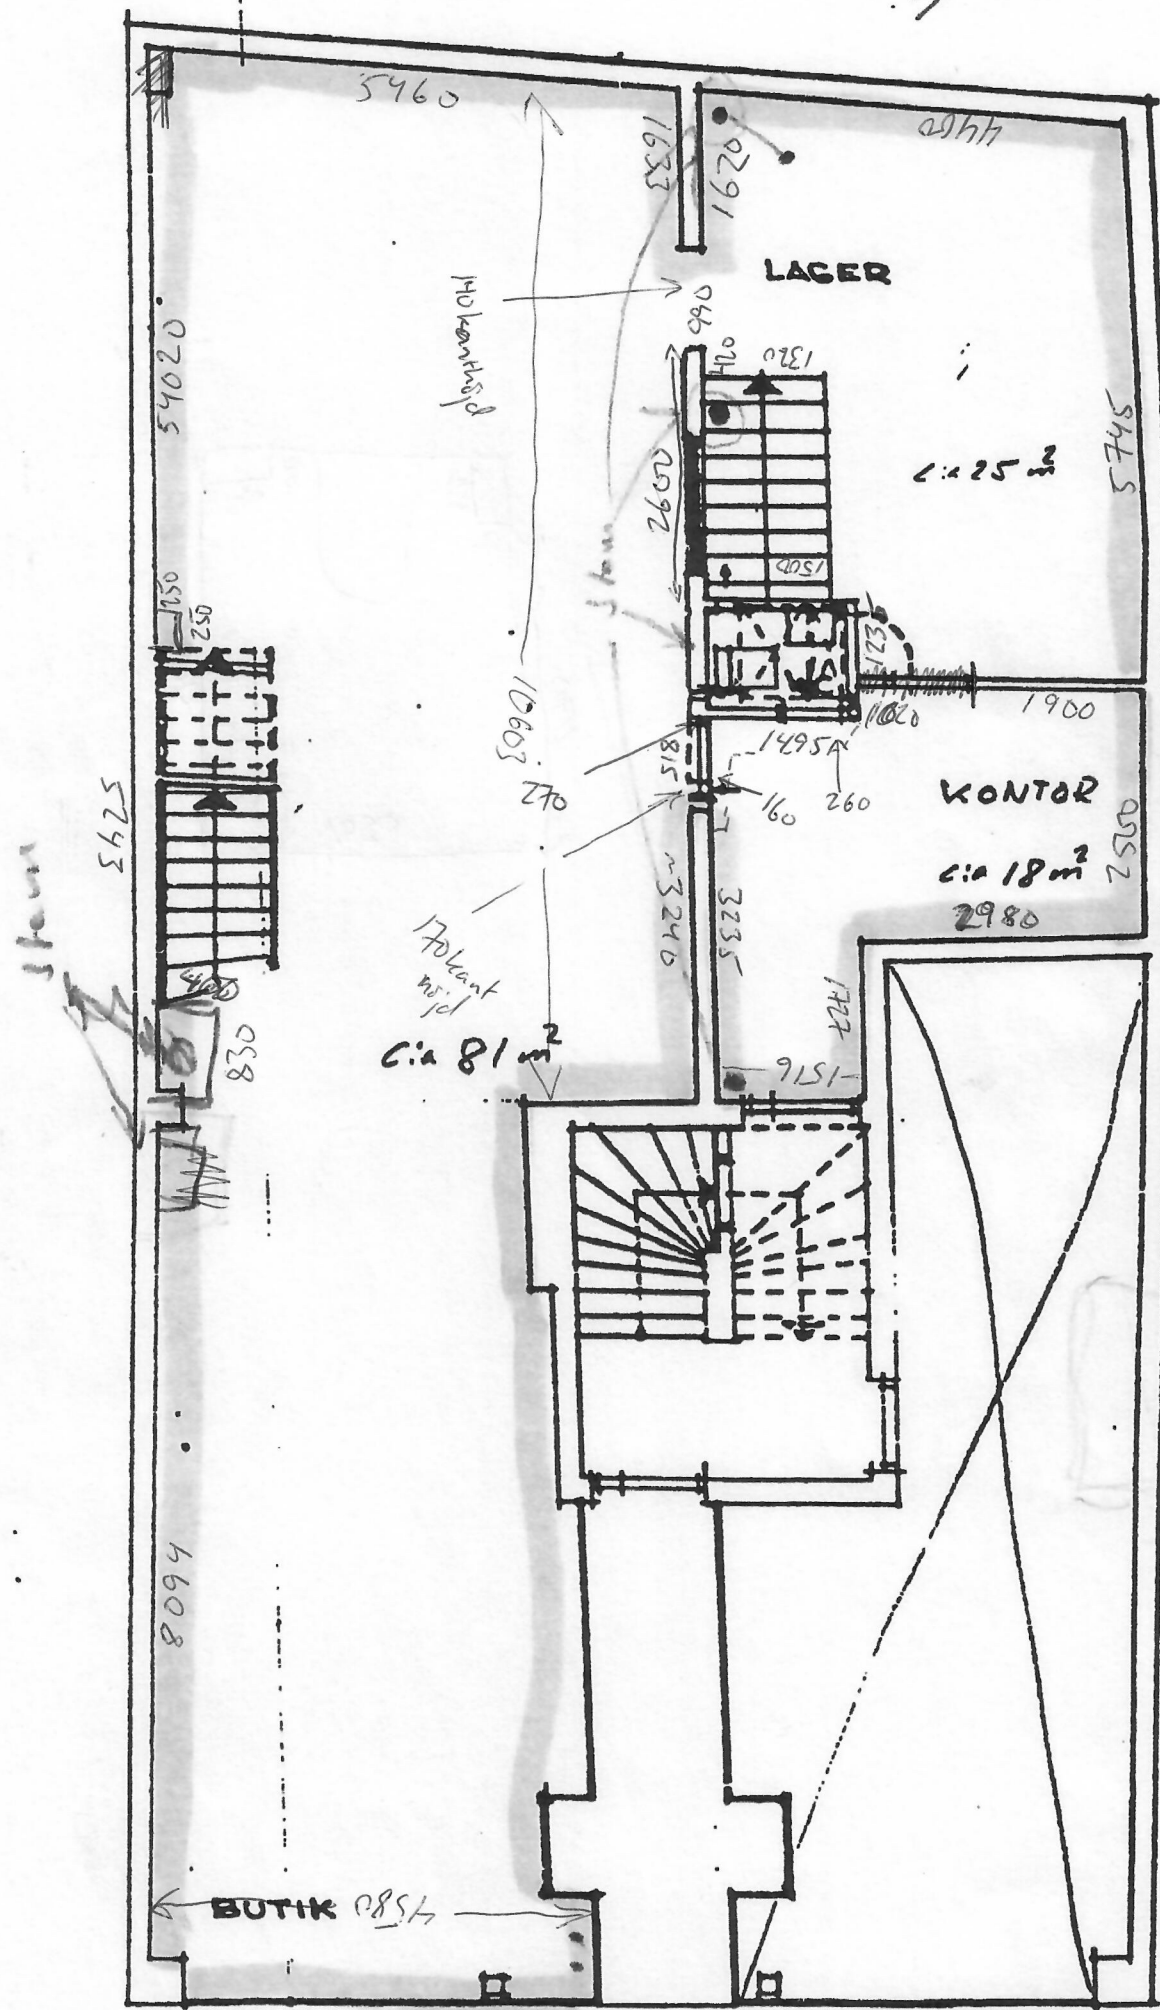

12
5
18

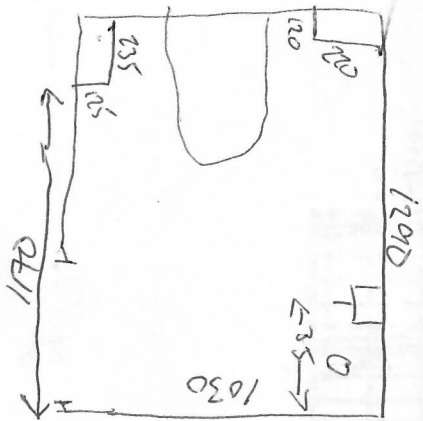

20/15