



PLAN 2. ALTERNATIV 1

KONTORSLOKAL
LOA: 415m²

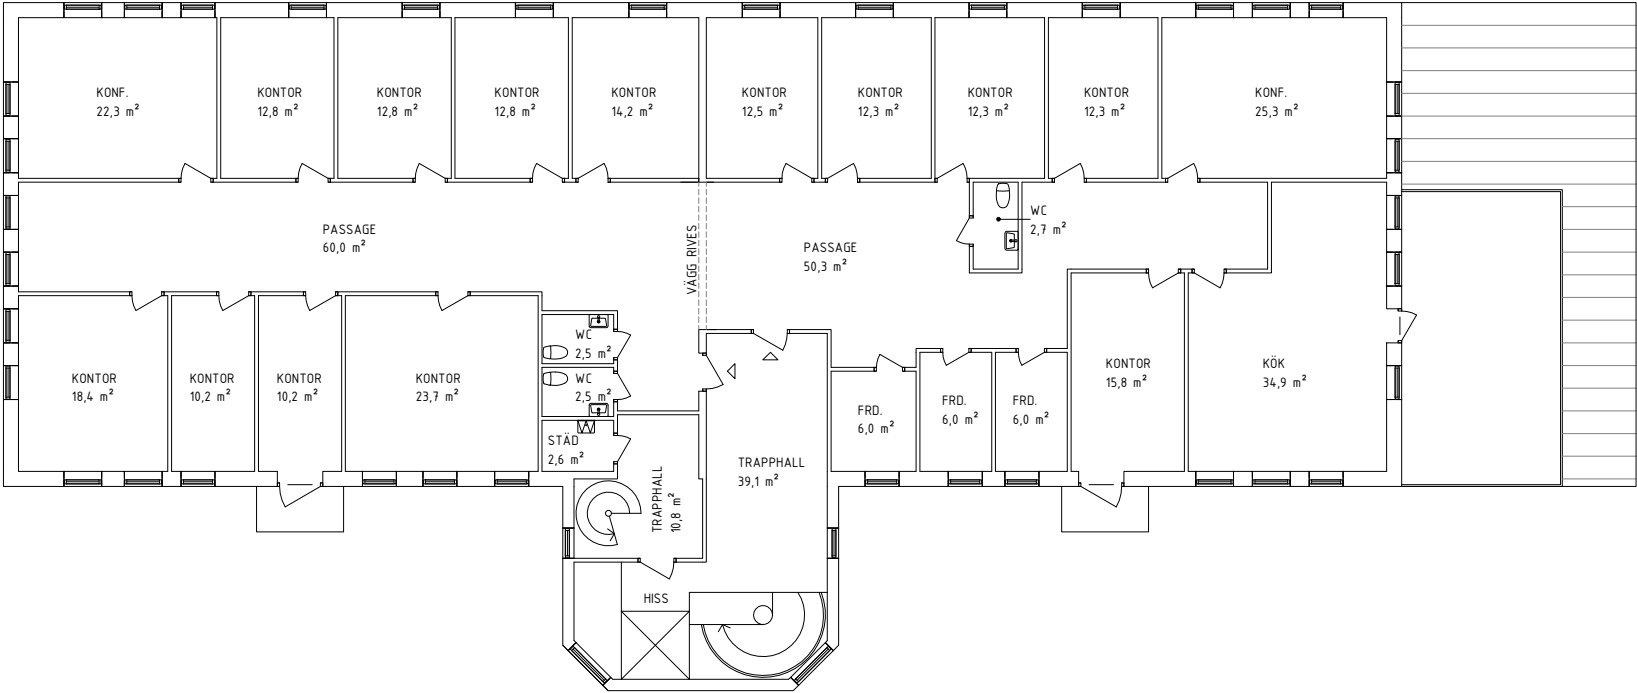

PLAN 2. ALTERNATIV 2

KONTORSLOKAL
LOA: 415m²

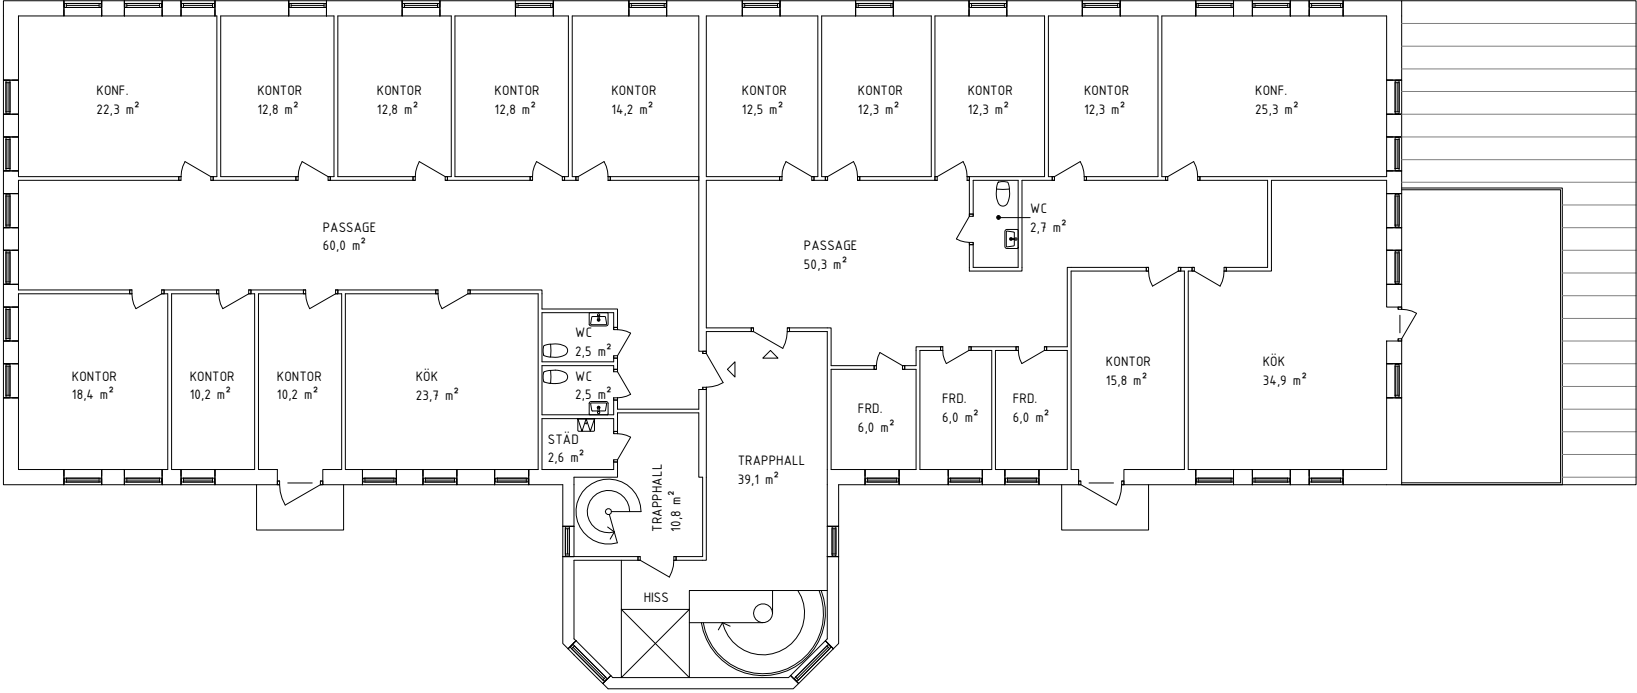

SKALA 1:100 0 1 10 METER

UTKAST

INFORMATIONSHANDLING

2025-09-30

AMALIA JÖNSSONS G.25

HÖGSBO 16:13

KONTORSLOKALER

MONDAAY!

Arkitektur & Design AB

www.mondaay.se | hello@mondaay.se

J.N

J.N

J.N

PLANRITNING

PLAN 2

2 TR

KONTORSOKAL

A-40-1-020

A1

1:100

BRÅLA

SET