


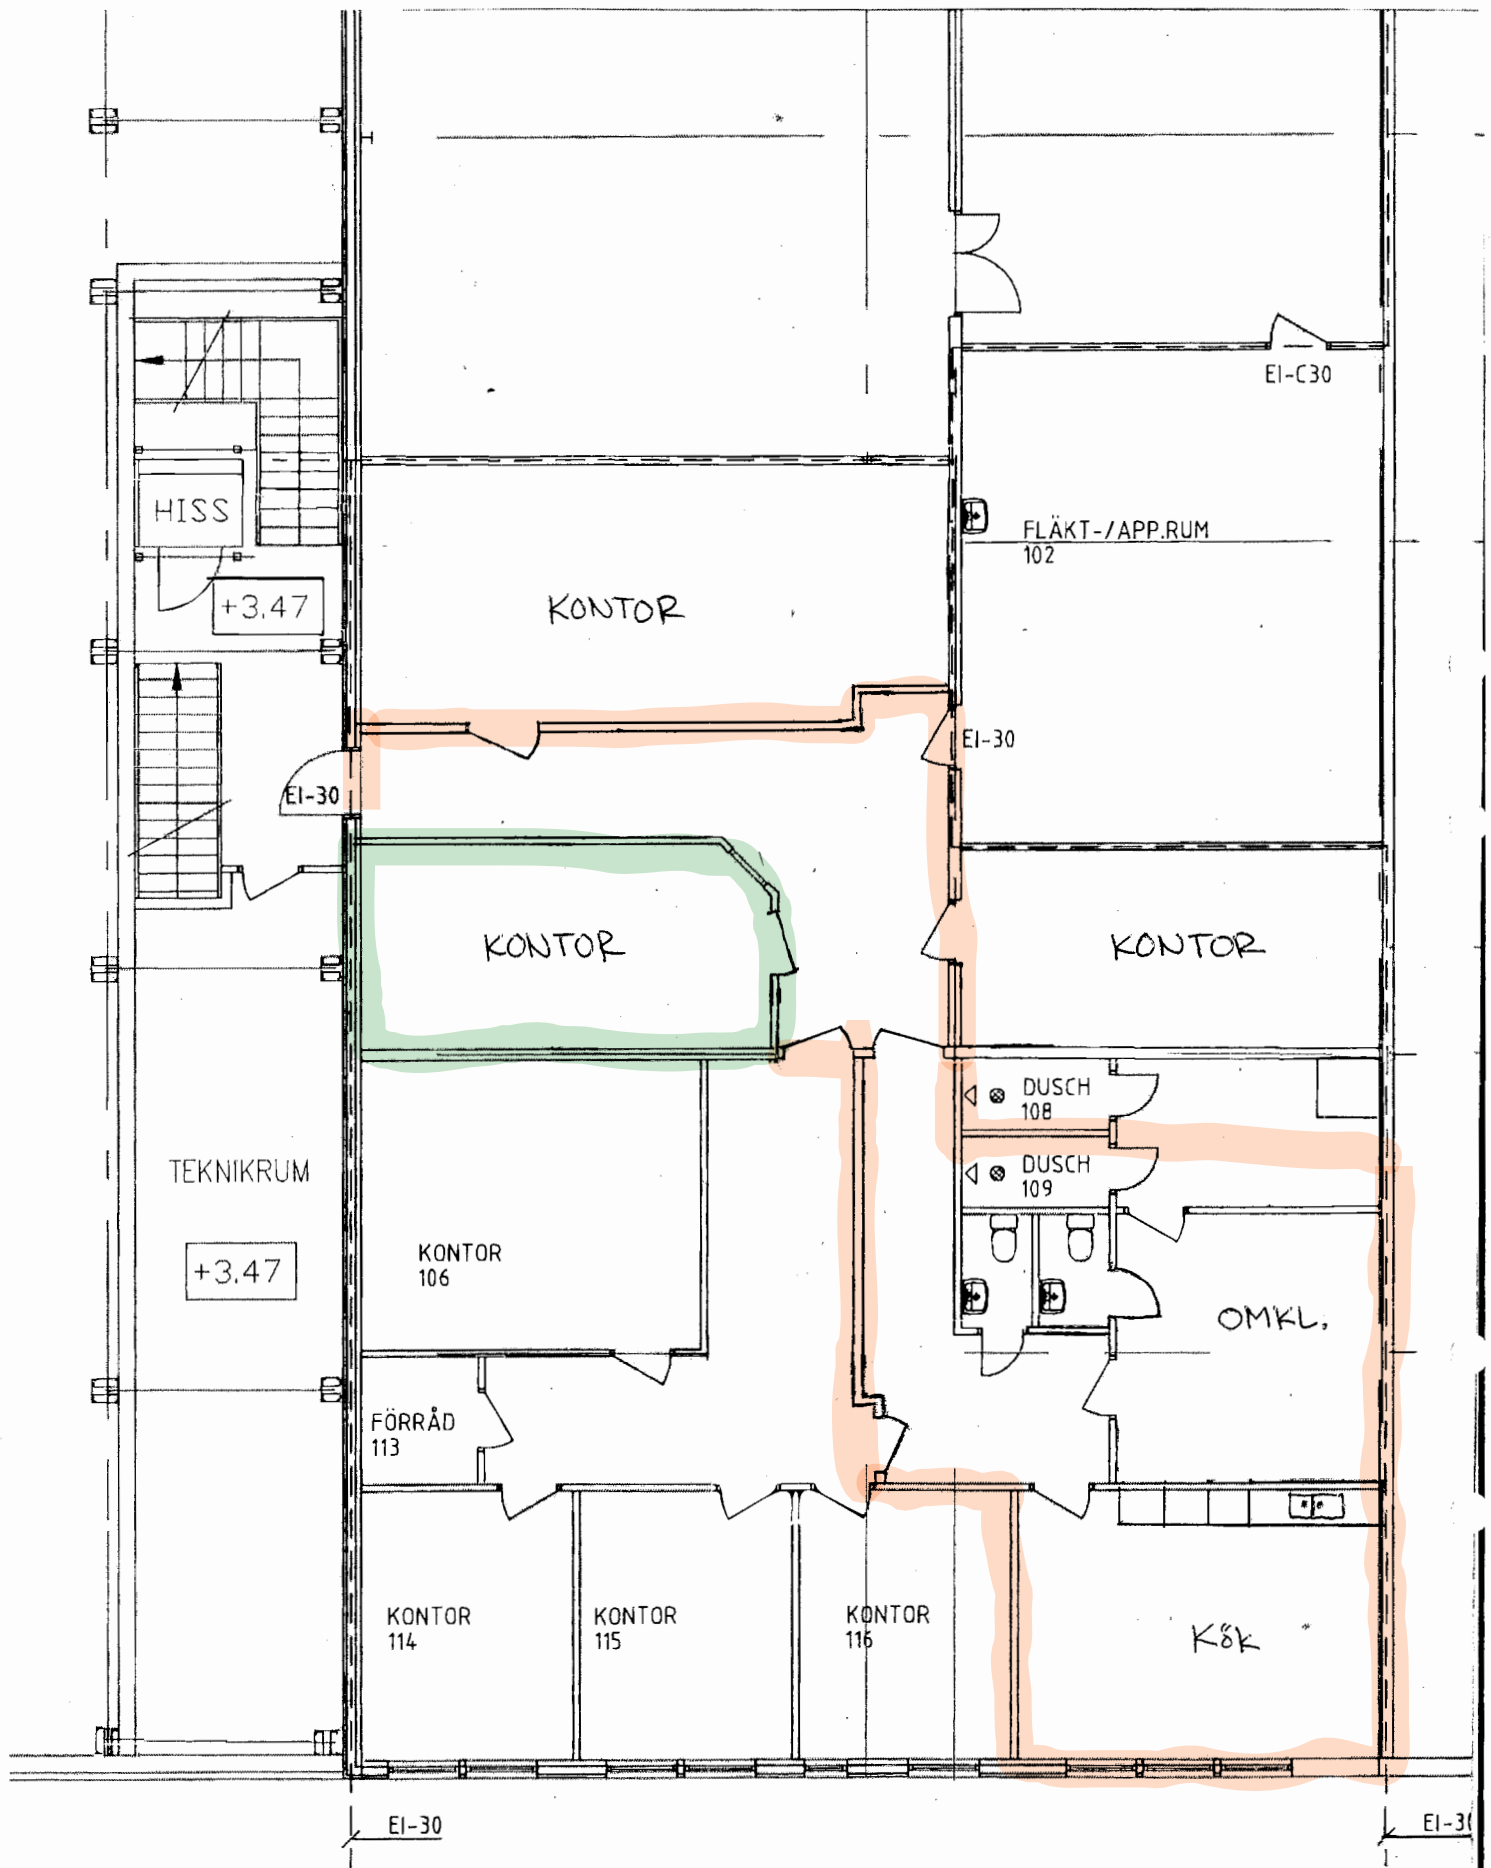

PLAN 1