


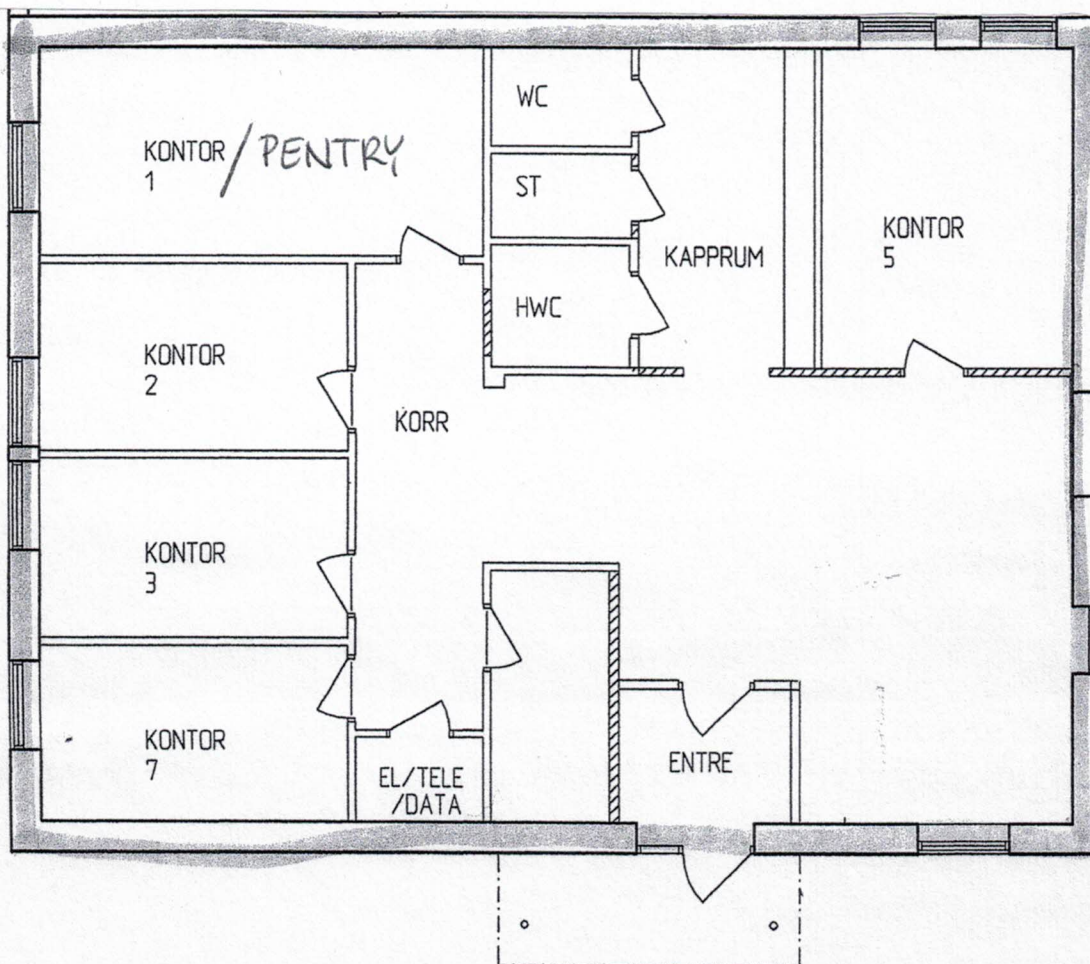

SKALA 1:100

CA 136 KVM