


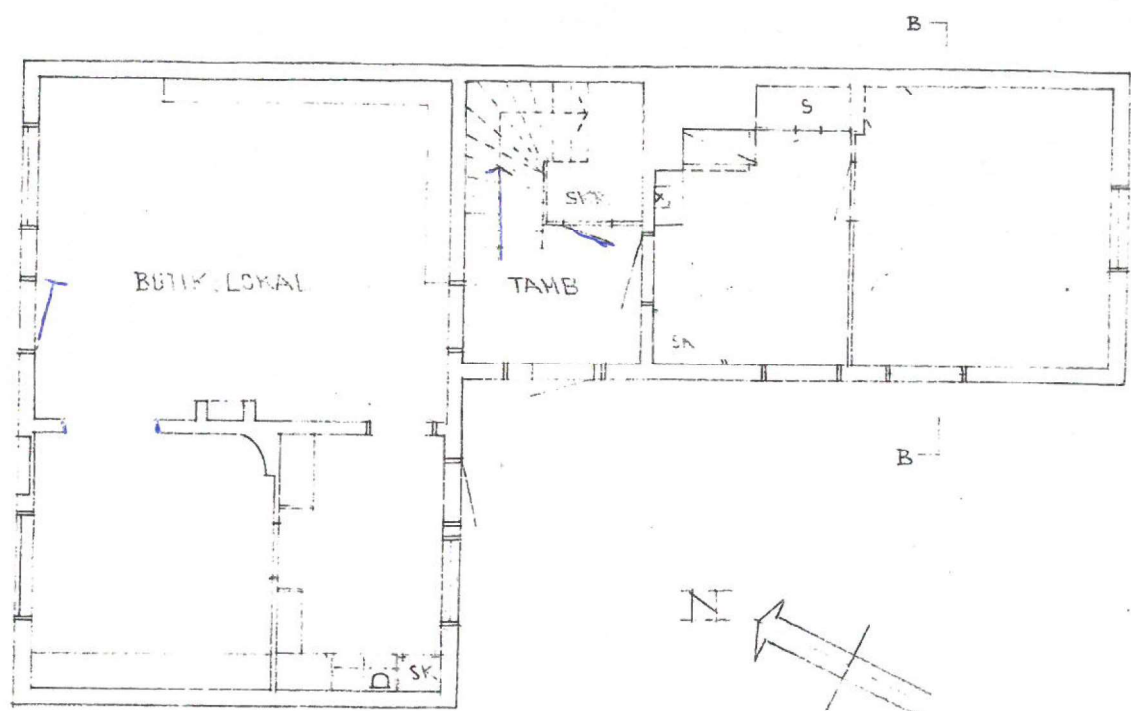

BOTTENPLAN