


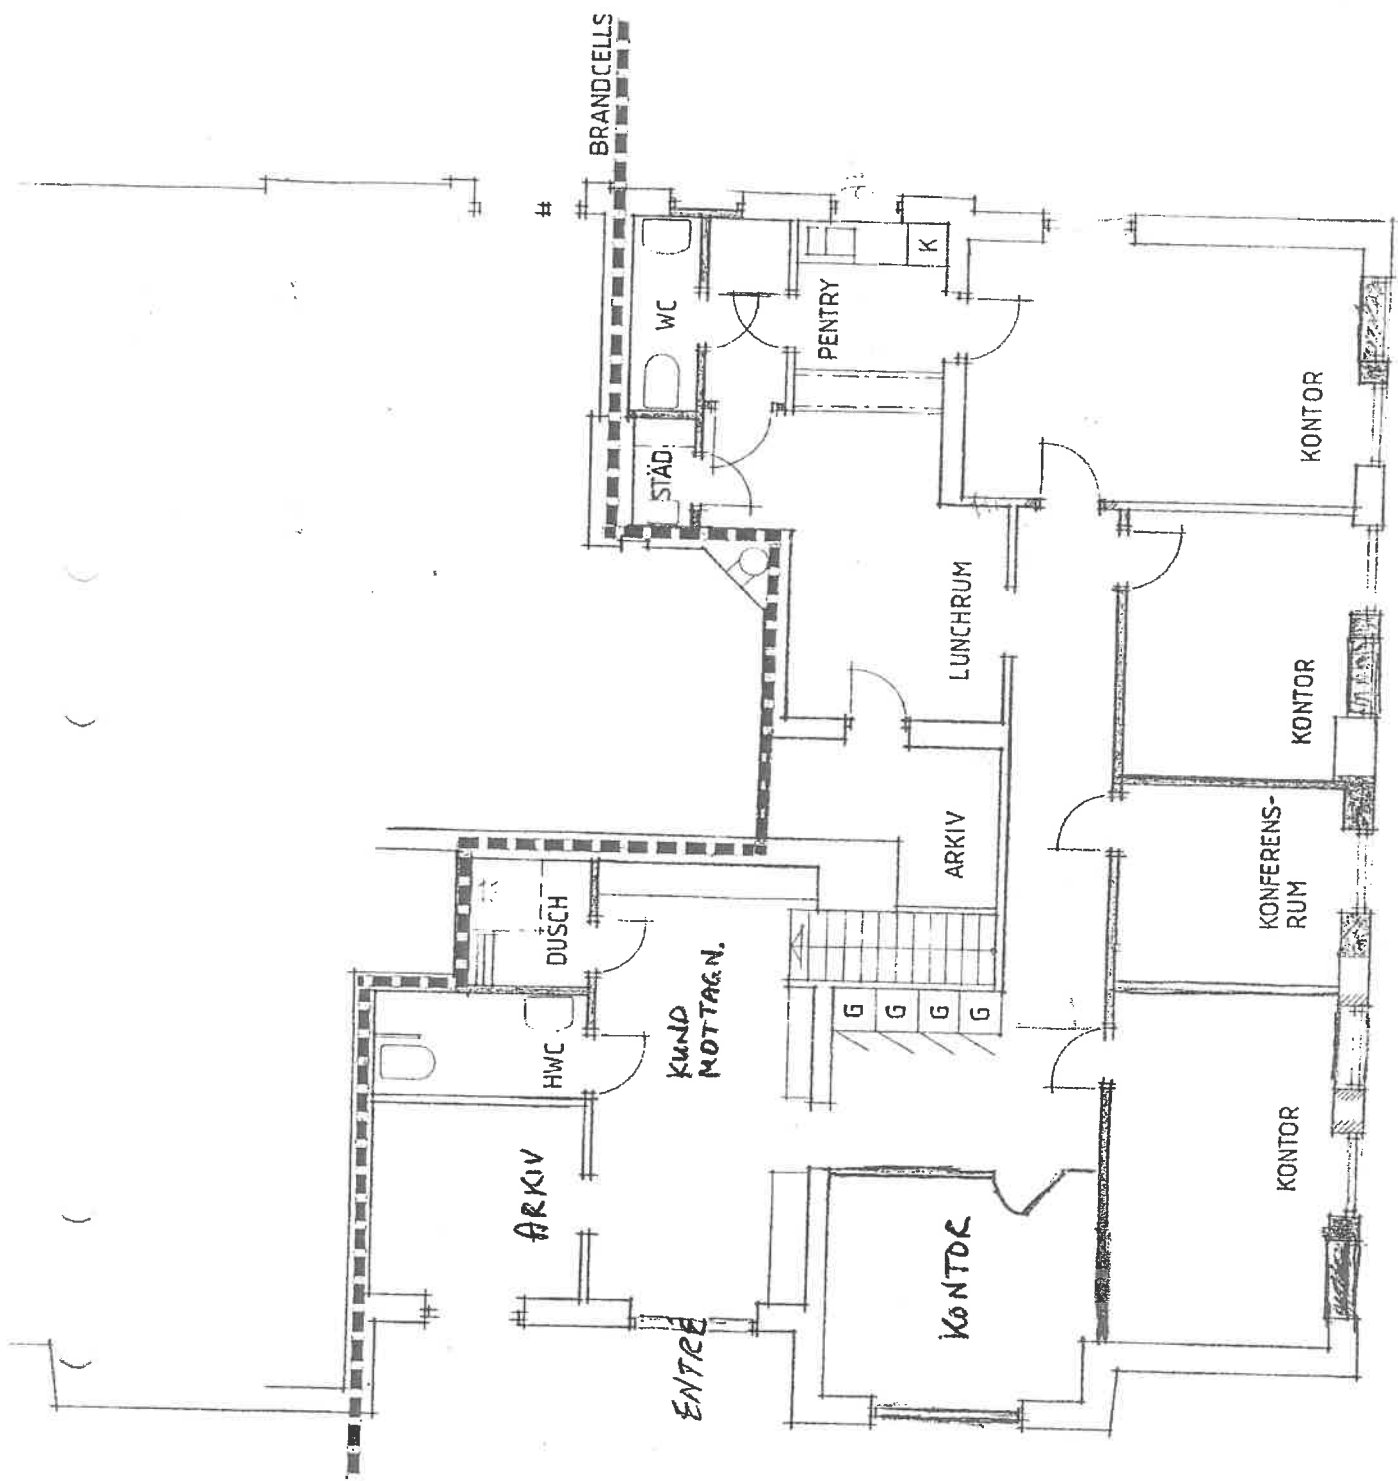

BRANDCELLS

#

STAD.

WC

PENTRY

K

LUNCHRUM

ARKIV

G G G G

KUND
MOTTAGN.

HWC

DUSCH

ARKIV

ENTRÉ

KONTOR

KONTOR

KONFERENS-
RUM

KONTOR

KONTOR