


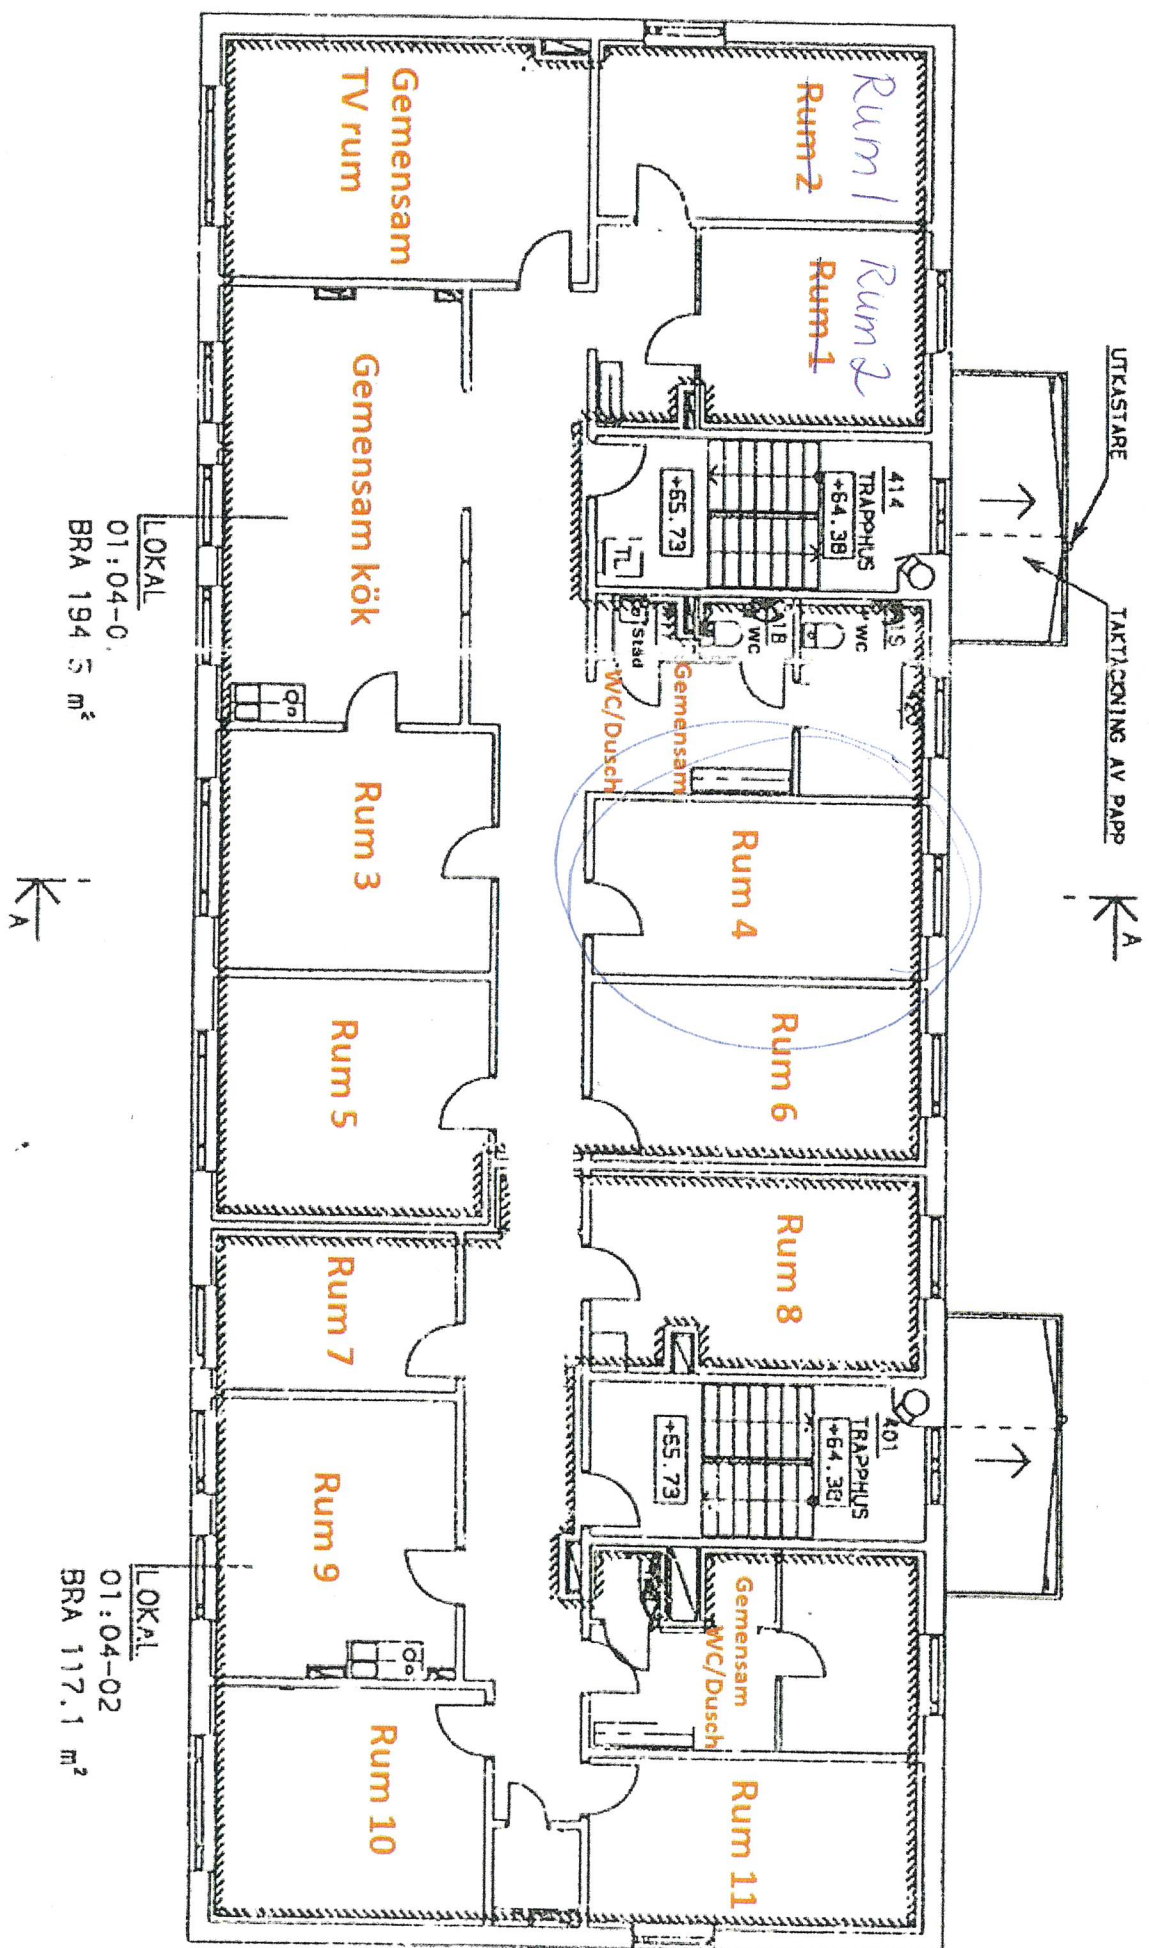

01:04-0.
BRA 194 5 m²

LOKAL.
01:04-02
BRA 117.1 m²